
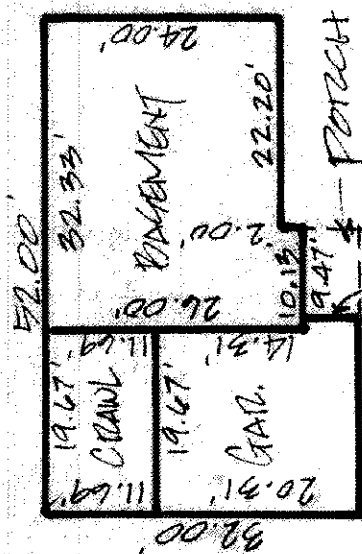


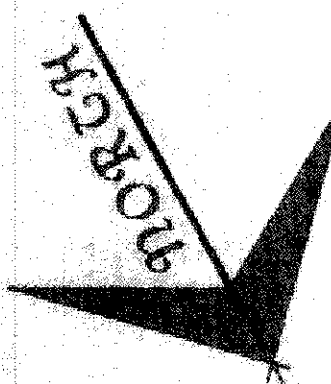


HOUSE DETAIL
SCALE: 1" = 20'

Grading Plan Approved
THOMAS R. GILLES, P.E.
Lake County Engineer
Date: 10-2-82

N. 73° 13' 30" W. 200.00'

N. 17° 11' 34" E. 128.00'

SUBLOT 100A
22,330.72 SQ. FT.

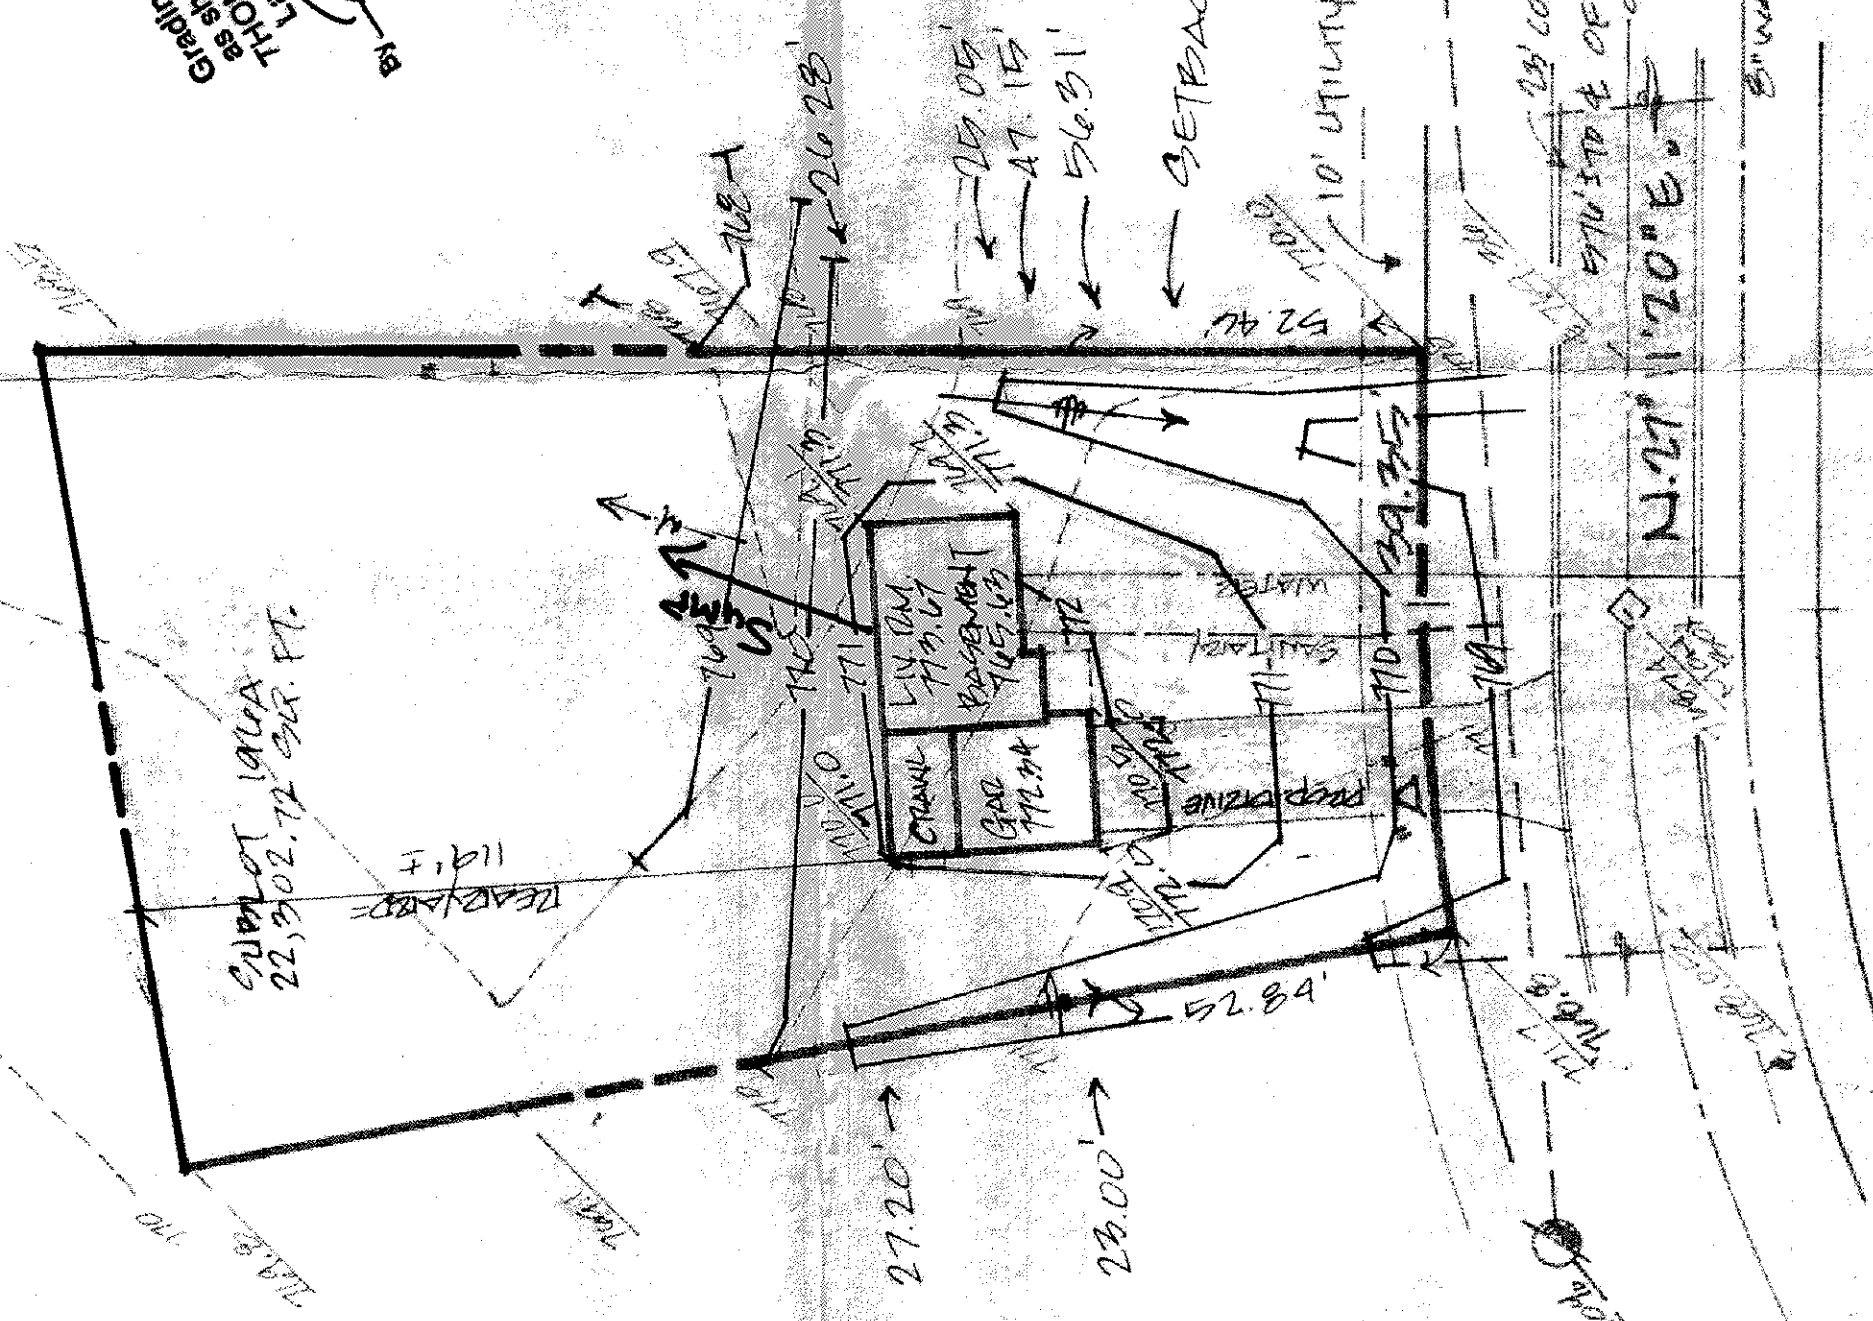

EXISTING
SAN. M.H. # 8
C.R. - 708.74
INV. - 756.39

SANUL DRIVE 60'

HOUSE BEARING S. 24° 15' 14" W.
TOP OF BLOCK 772.67

SITE PLAN

CONCORD TOWNSHIP
LAKE COUNTY, OHIO
for: RYAN HAWES
OWNER

ADDRESS	CITY	ZIP
CONCORD HILLS #4		
SUBLOT NO.	LOT	TRACT
196		
SUBLOT NO.	VOLUME	PAGE
	PERM. PARCEL NO.	STREET

LEGEND

- SANITARY MANHOLE
- STORM MANHOLE
- INLET OR CATCH BASIN
- HYDRANT
- EXISTING CONTOURS
- PROPOSED CONTOURS
- EXIST. ELEV.
- PROP. ELEV.
- WATER VALVE (GAS)
- WATER METER (GAS)
- AS BUILT ELEVATION
- INDICATES DIRECTION OF SURFACE DRAINAGE

REMARKS

ALL BOUNDARY DATA SHOWN WAS OBTAINED FROM IDEAS, RECORDED SUBDIVISION PLAT OR OTHER PUBLIC RECORDS.
LOCATIONS AS SHOWN OF ADJACENT WELLS AND SEPTIC TANKS OBTAINED FROM LAKE COUNTY HEALTH DEPARTMENT

DESIGN CERTIFICATION

THIS PLAT WAS PREPARED BY ME, AND IS CORRECT TO THE BEST OF MY KNOWLEDGE AND BELIEF.

NAME: Ryan Hawes
SURVEYOR REGISTRATION NO. 5-6571

CHECK LIST

- NO. OF BEDROOMS
- DIMENSIONS
- SEASONS
- USE TO NEAREST STREET
- SUBLOT NO. PARCEL NO.
- SURROUNDING OWNERS
- BLDG. DIMENSIONS FIN OR
- APPROX. TYPE WID. SPACES
- SIDEWALK TYPE WIDTH THICKNESS
- CULVERT TYPE DIA. LENGTH
- ROCK OUTCROPPINGS
- WATER MAIN SIZE, LOCATION
- SAN. SEWER SIZE, LOC. LOC.
- SAN. M.H. CAST ELEV. INV. ELEV.
- SAN. COND. SIZE, LOC. DEPTH
- STORM SEWER SIZE, LOC. LOC.
- STORM M.H. CAST ELEV. INV. ELEV.
- PAV'T TYPE GRADE CURVES
- GAS LINE LOC. SIZE PRESSURE
- SEPTIC TANK LOCATION & DUPLICATION AREA
- WELL LOCATION
- ISOLATION RADIUS FROM WELL

PLAN PREPARED BY: DEBEVEC & SALO & ASSOCIATES, INC.

125 E ERIE ST. PAINESVILLE, OHIO

NO.	DATE	BY
1		
2		
3		
4		
5		

SCALE: 1" = 30'
DATE: 3/19/82
DRAWING NO. 4820-196

REGISTERED SURVEYOR

"AS BUILT" CERTIFICATION
I, HEREBY CERTIFY THAT THE CIRCLED GRADES ARE EXISTING FINISH GRADES CHECKED IN THE FIELD ON 19 AND ARE CORRECT TO THE BEST OF MY KNOWLEDGE AND BELIEF.

CURVE "A"
ARC = 50.89'
Δ = 10° 24' 50"
CHORD = 50.82'
N. 71° 58' 55" E.

ZONING PERMIT #4455
ISSUED 3-10-82

SUBJECT TO APPROVAL BY:
Lake County Sanitary Eng. ☐
Lake County Eng. Dept. ☒
Lake County Planning Comm. ☐
Lake County Bldg. Dept. ☒
Teno & McNamee

BENCHMARK MONUMENT
BOY IN FRONT OF 5/2 196
ELEVATION 768.74

N.I.O. # 4820-196