

# SITE PLAN

Lenora TOWNSHIP LAKE COUNTY, OHIO

for: Margaret Deal

OWNER

ADDRESS: 1101 1/2 S. P. E. CITY: ZIP:

Grading Plan as shown at THOMAS P. C. Lake County Engineer Date: 7/15/82

LOT	TRACT
VOLUME	PAGE
PERM. PARCEL NO.	STREET

REMARKS

ALL BOUNDARY DATA SHOWN WAS OBTAINED FROM IDEEDS, RECORDED SUBDIVISION PLAT OR OTHER PUBLIC RECORDS.

LOCATIONS AS SHOWN OF ADJACENT WELLS AND SEPTIC TANKS OBTAINED FROM LAKE COUNTY HEALTH DEPARTMENT

DESIGN CERTIFICATION

THIS PLAN WAS PREPARED BY ME, AND IS CORRECT

DATE: 7/15/82

NAME: SURVEYOR REGISTRATION NO.:

CHECK LIST

NO. OF BEDROOMS	WATER MAIN SIZE, LOCATION
BEARINGS	SAN. SEWER SIZE, % GR. LOC.
TIE TO NEAREST STREET	SAN. MH. CAST, ELEV., INV. ELEV.
SUBLOT NO. PARCEL NO.	SAN. CONN. SIZE, LOC. DEPTH
SURROUNDING OWNERS	STORM SEWER SIZE, % GR. LOC.
BLOD. DIMENSIONS FIN. GR.	STORM MH. CAST, ELEV.
BLOD. TIES P.T.R. GRADERS	PAV'T TYPE, GRAD, CURVES
APPROX TYPE WIDTH THICKNESS	GRAS LINE LOC. SIZE PRESSURE
SEWER TYPE, LOCATION, & DUPPLICATION AREA	SEWER TANK LOCATION & DUPPLICATION AREA
COLLECTOR TYPE DIA. LENGTH	WELL LOCATION
ROCK OUTCROPPINGS	ISOLATION RADIUS FROM WELL

PLAN PREPARED BY:

BABCOCK • JONES & ASSOCIATES, INC.

270 MAIN ST. SUITE #20 PAINESVILLE, OHIO

NO.	DATE	BY
1		
2		
3		
4		
5		

DRAWN BY: SCALE: 1" = 30'

CHECKED: DATE: 7/21/82

CREW: CHIEF: APPD.:


PHONE NO. 357-1811

DRAWING NO. 82-088

"AS BUILT" CERTIFICATION

I, HEREBY CERTIFY THAT THE CIRCLED GRADES ARE EXISTING FINISH GRADES CHECKED IN THE FIELD ON 7/19/82 AND ARE CORRECT TO THE BEST OF MY KNOWLEDGE AND BELIEF.

REGISTERED SURVEYOR REG. NO.:

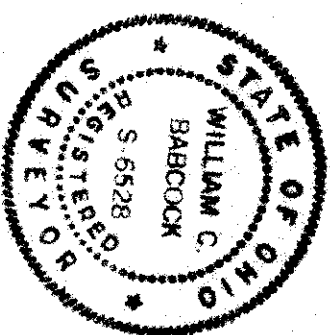

ZONING PERMIT

ISSUED 7/18/82 #4510 PAK

SUBJECT TO APPROVAL BY:

- ☐ Lake County Sanitary Eng.
- ☐ Lake County Eng. Dept.
- ☐ Lake County Planning Comm.
- ☐ Lake County Bldg. Dept.

