


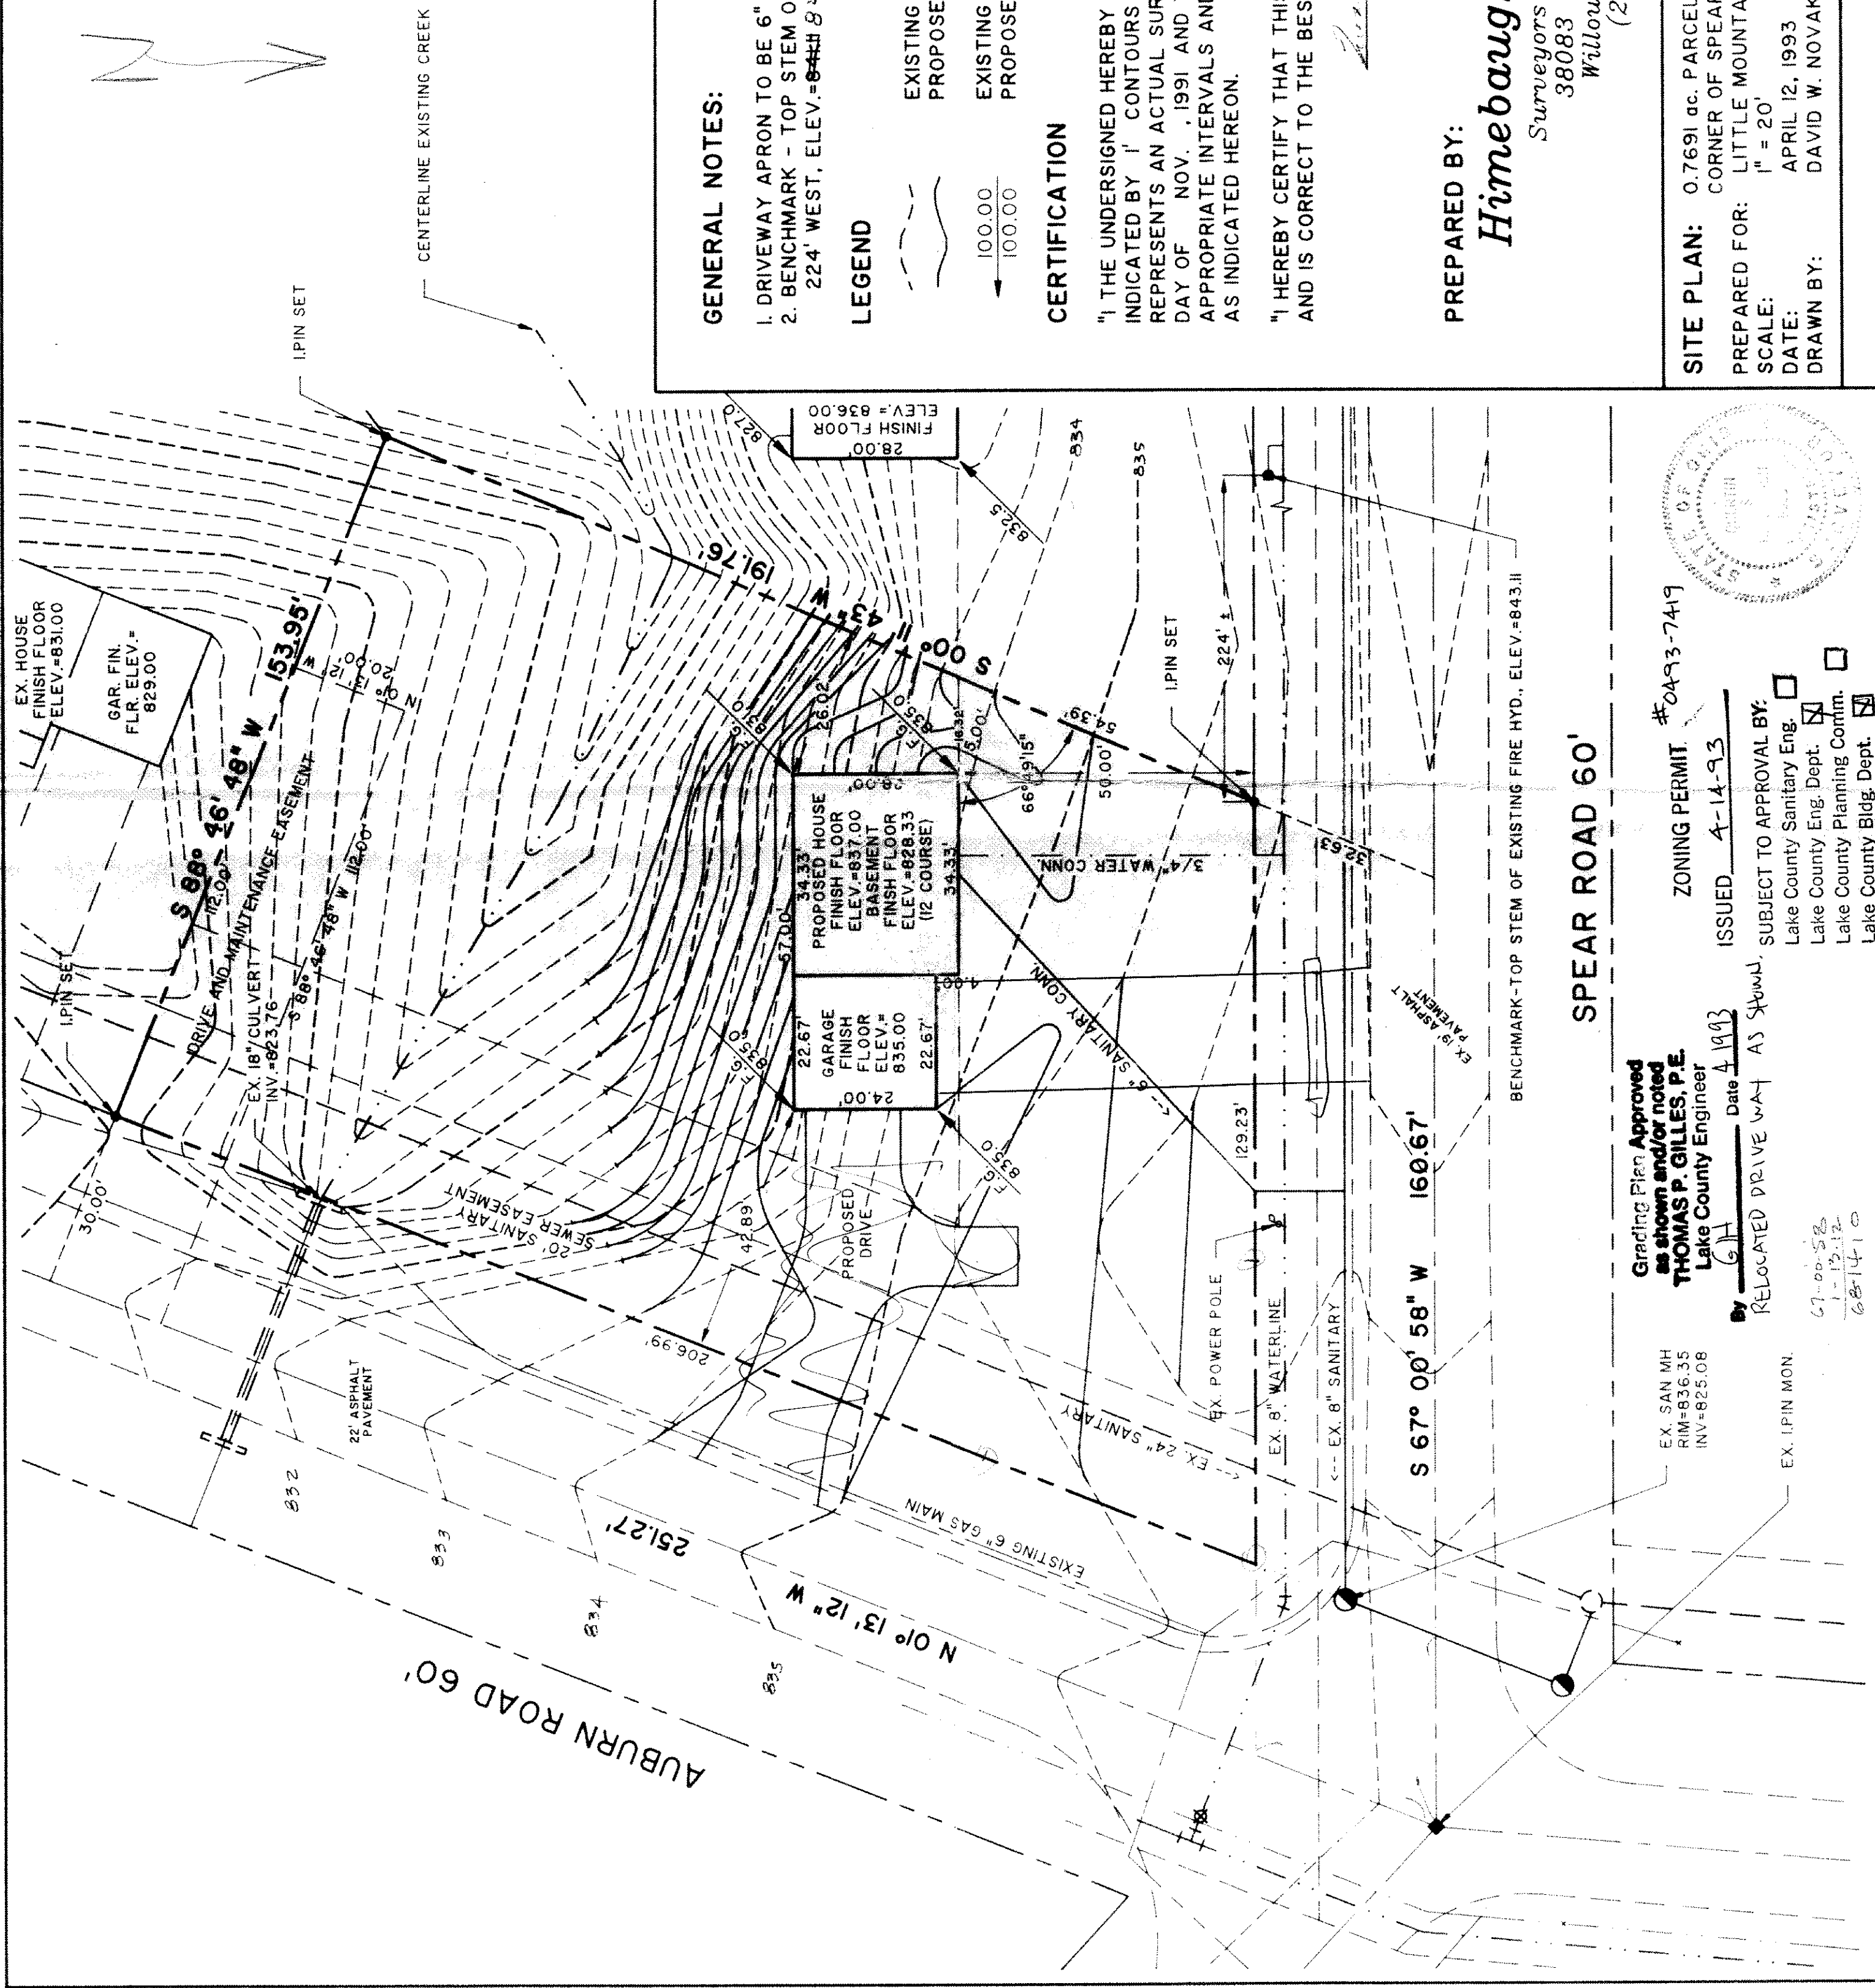

GENERAL NOTES:

1. DRIVEWAY APRON TO BE 6" THICK
2. BENCHMARK - TOP STEM OF FIRE HYDRANT LOCATED 224' WEST, ELEV. = 844.31

LEGEND

- EXISTING CONTOUR
- PROPOSED CONTOUR
- EXISTING ELEVATION
- PROPOSED ELEVATION

CERTIFICATION

"I, THE UNDERSIGNED HEREBY CERTIFY THAT THIS TOPOGRAPHY INDICATED BY 1' CONTOURS AND ELEVATIONS SHOWN HEREON REPRESENTS AN ACTUAL SURVEY MADE BY ME ON THE 13th DAY OF NOV. 1991 AND THE ELEVATIONS WERE TAKEN AT APPROPRIATE INTERVALS AND AS OF THAT DAY THEY EXISTED AS INDICATED HEREON.

"I HEREBY CERTIFY THAT THIS PLAN WAS PREPARED BY ME AND IS CORRECT TO THE BEST OF MY KNOWLEDGE"

QUENTIN S. HIMEBAUGH, P.S. No. 6820

PREPARED BY:

Himebaugh and Associates

Surveyors and Site Consultants
38083 West Spaulding St.
Willoughby, Ohio 44094
(216) 946-1761

SITE PLAN: 0.7691 ac. PARCEL AT THE SOUTHWEST CORNER OF SPEAR AND AUBURN ROAD, CONCORD TWP.

PREPARED FOR: LITTLE MOUNTAIN HOMES, INC.

SCALE: 1" = 20'

DATE: APRIL 12, 1993

DRAWN BY: DAVID W. NOVAK

ZONING PERMIT #0493-7419

ISSUED 4-14-93

SUBJECT TO APPROVAL BY:

- ☐ Lake County Sanitary Eng.
- ☐ Lake County Eng. Dept.
- ☐ Lake County Planning Comm.
- ☒ Lake County Bldg. Dept.

Grading Plan Approved
as shown and/or noted
THOMAS P. GILLES, P.E.
Lake County Engineer

By **GH** Date **4/14/93**

RELOCATED DRIVE WAY AS SHOWN.

67-00-58
1-12-12
681410

EX. SAN. MH
RM=836.35
INV=825.08

EX. IPIN MON.

SPEAR ROAD 60'

AUBURN ROAD 60'