

CERTIFICATION

THIS PLAN WAS PREPARED BY ME,
AND IS CORRECT TO THE BEST OF
MY KNOWLEDGE AND BELIEF


Timothy P. Hadden

REG. SURVEOR NO. 5786



NOTE: IMPROVEMENTS SHOWN HEREIN
ARE TAKEN FROM PLANS APPROVED
BY THE OFFICE OF THE LAKE COUNTY
ENGINEER.

KELLOGG ROAD 60'

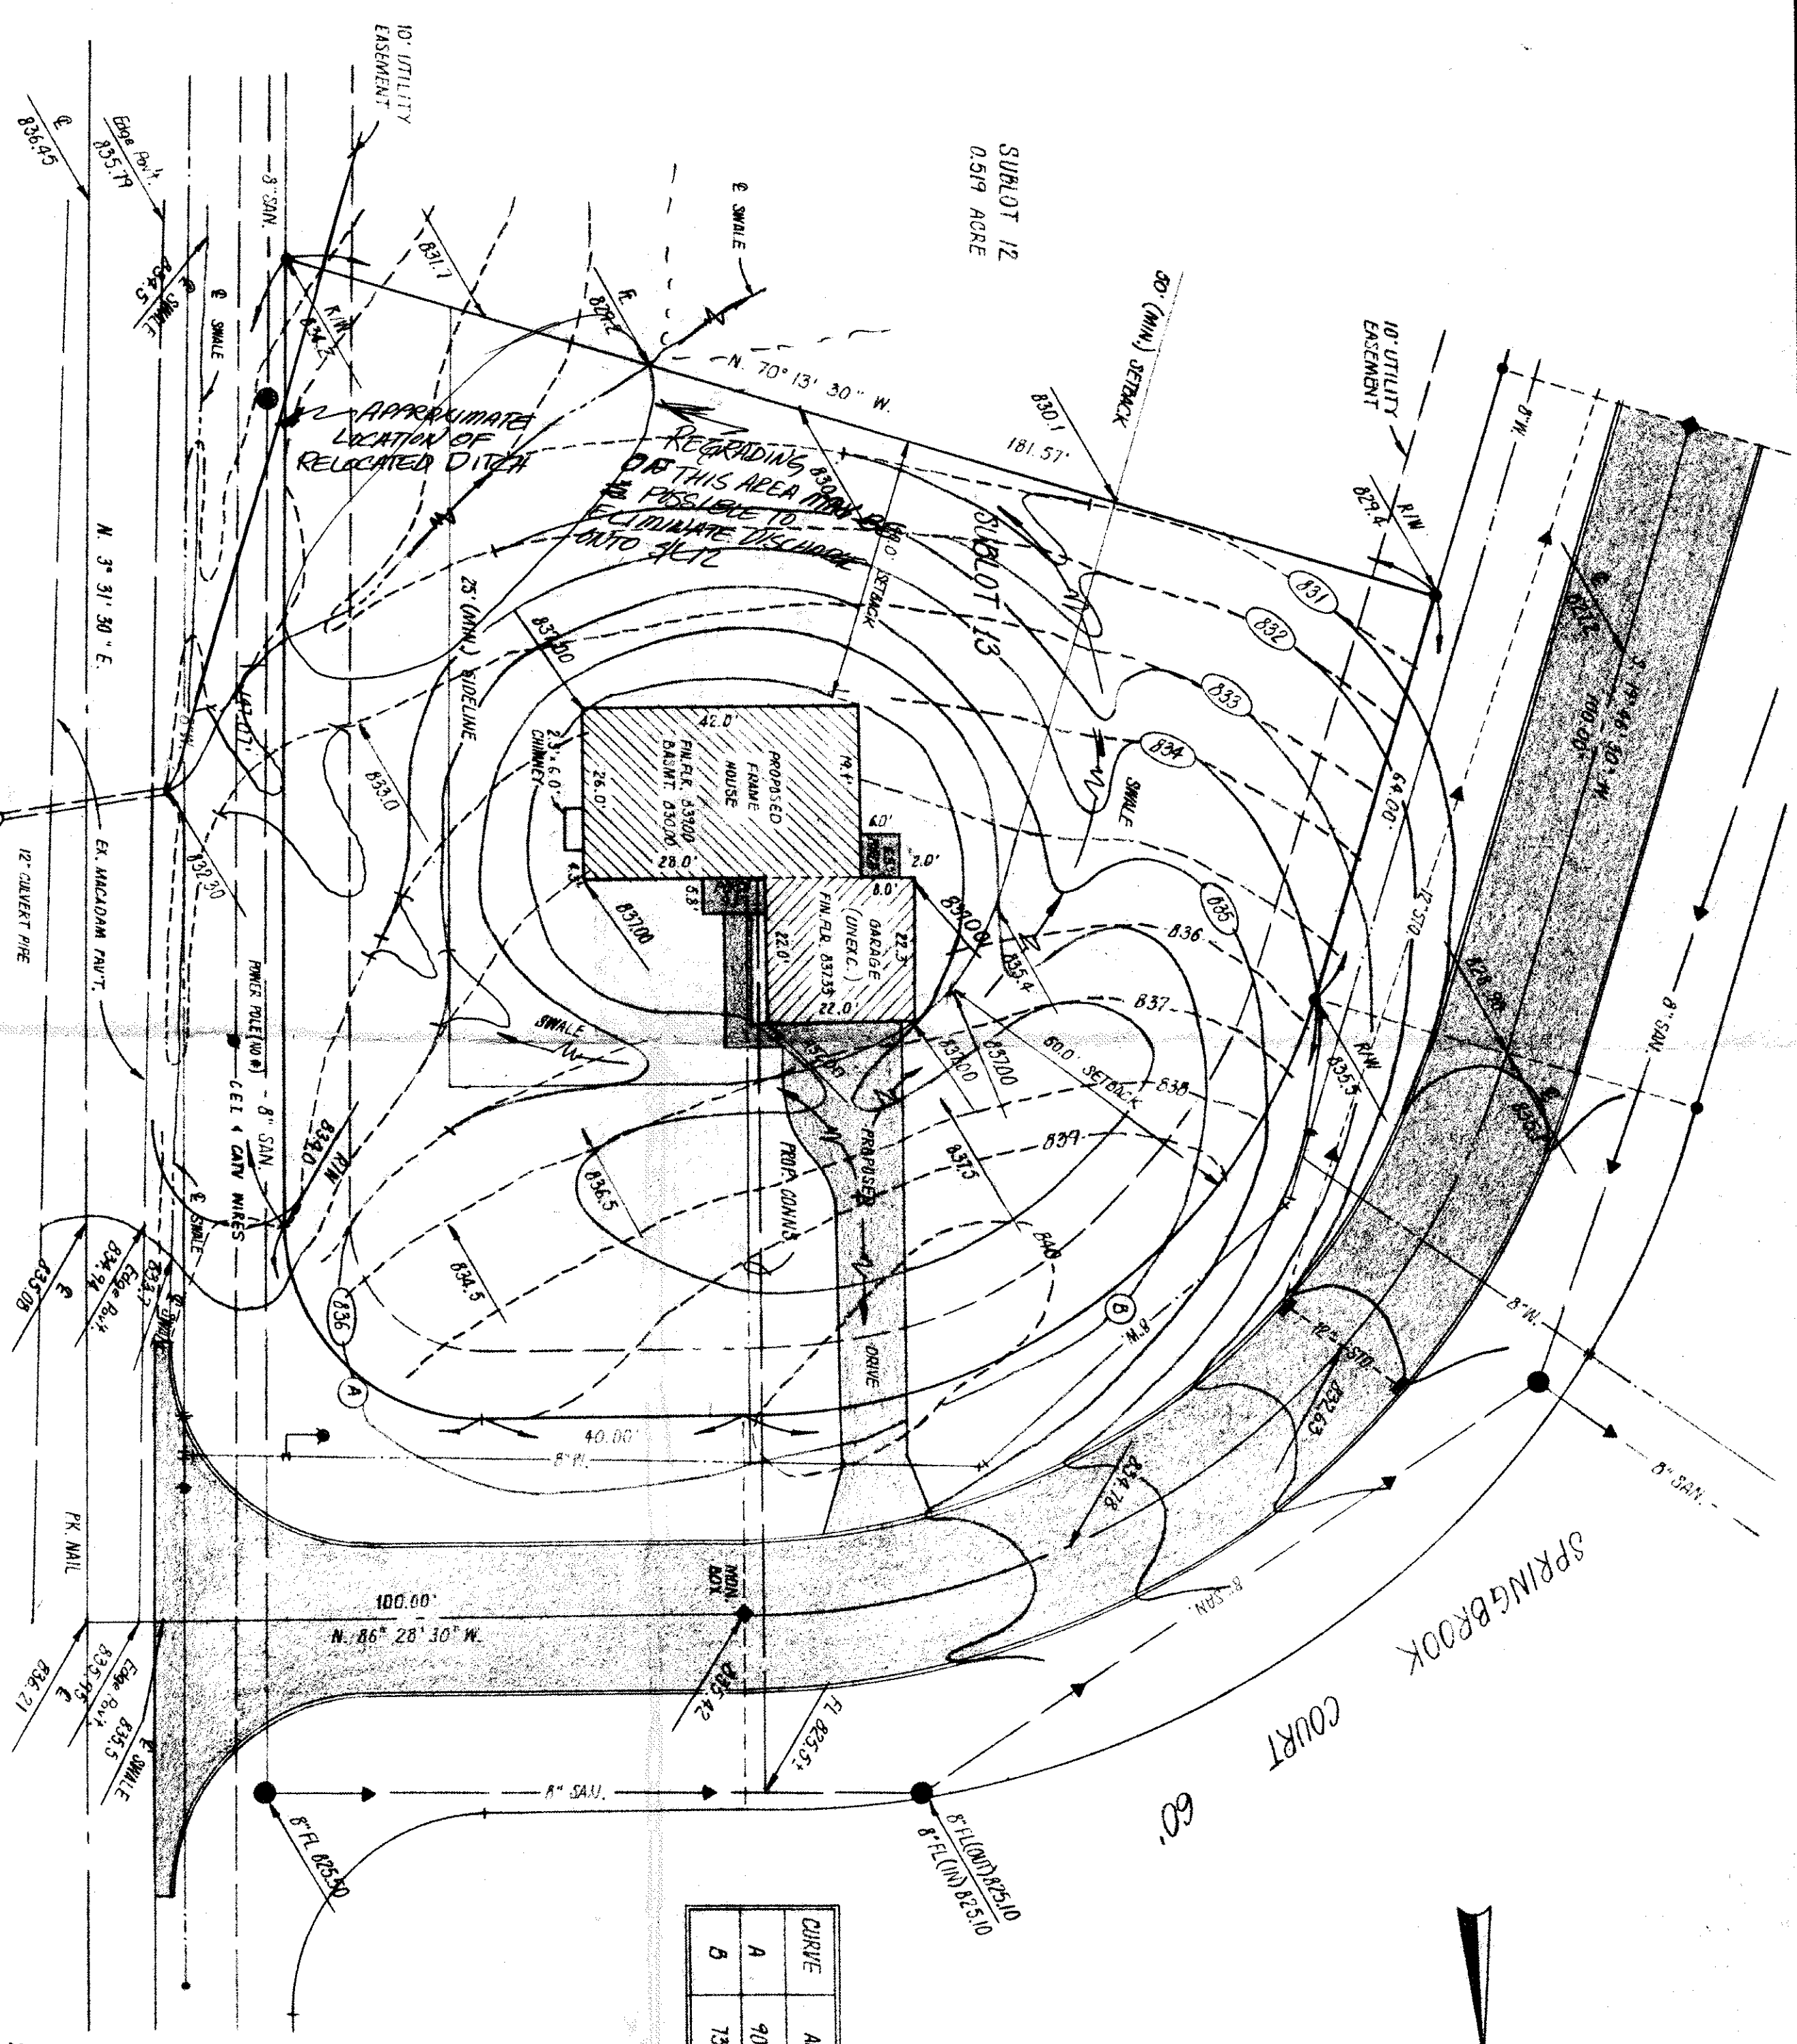

- LEGEND
- 1. 800.00 PROPOSED GROUND ELEV.
 - 2. 800.00 EXISTING GROUND ELEV.
 - 3. —W— OVERLAND DRAINAGE FLOW
 - 4. BENCHMARK: PK. NAIL IN WEST SIDE OF D.B.T. POLE # 56515, ELEV. 837.55
 - 5. ——— EXISTING CONTOURS
 - 6. (---) PROPOSED CONTOURS

Timothy A. Hadden

ZONING PERMIT # 5746
ISSUED 4-11-87

CURVE	ANGLE	RADIUS	LENGTH	BEARING	CHORD
A	90° 0' 00"	80.00'	47.12'	S. 47° 28' 30" E.	42.43'
B	73° 45' 00"	90.00'	115.85'	N. 56° 37' 00" E.	108.01'



DATE JANUARY 1982
SCALE 1"=20'
DRAWN BY JHS
CHECKED BY TPH

CT COLPETZER-THOMAS, INC.
AN ENGINEERING GROUP

CONCORD TOWNSHIP
SUBPLOT 13, SPRINGBROOK COURT
LAKE COUNTY, OHIO

SHEET 1 OF 1
CONTRACT NO. 88/13