

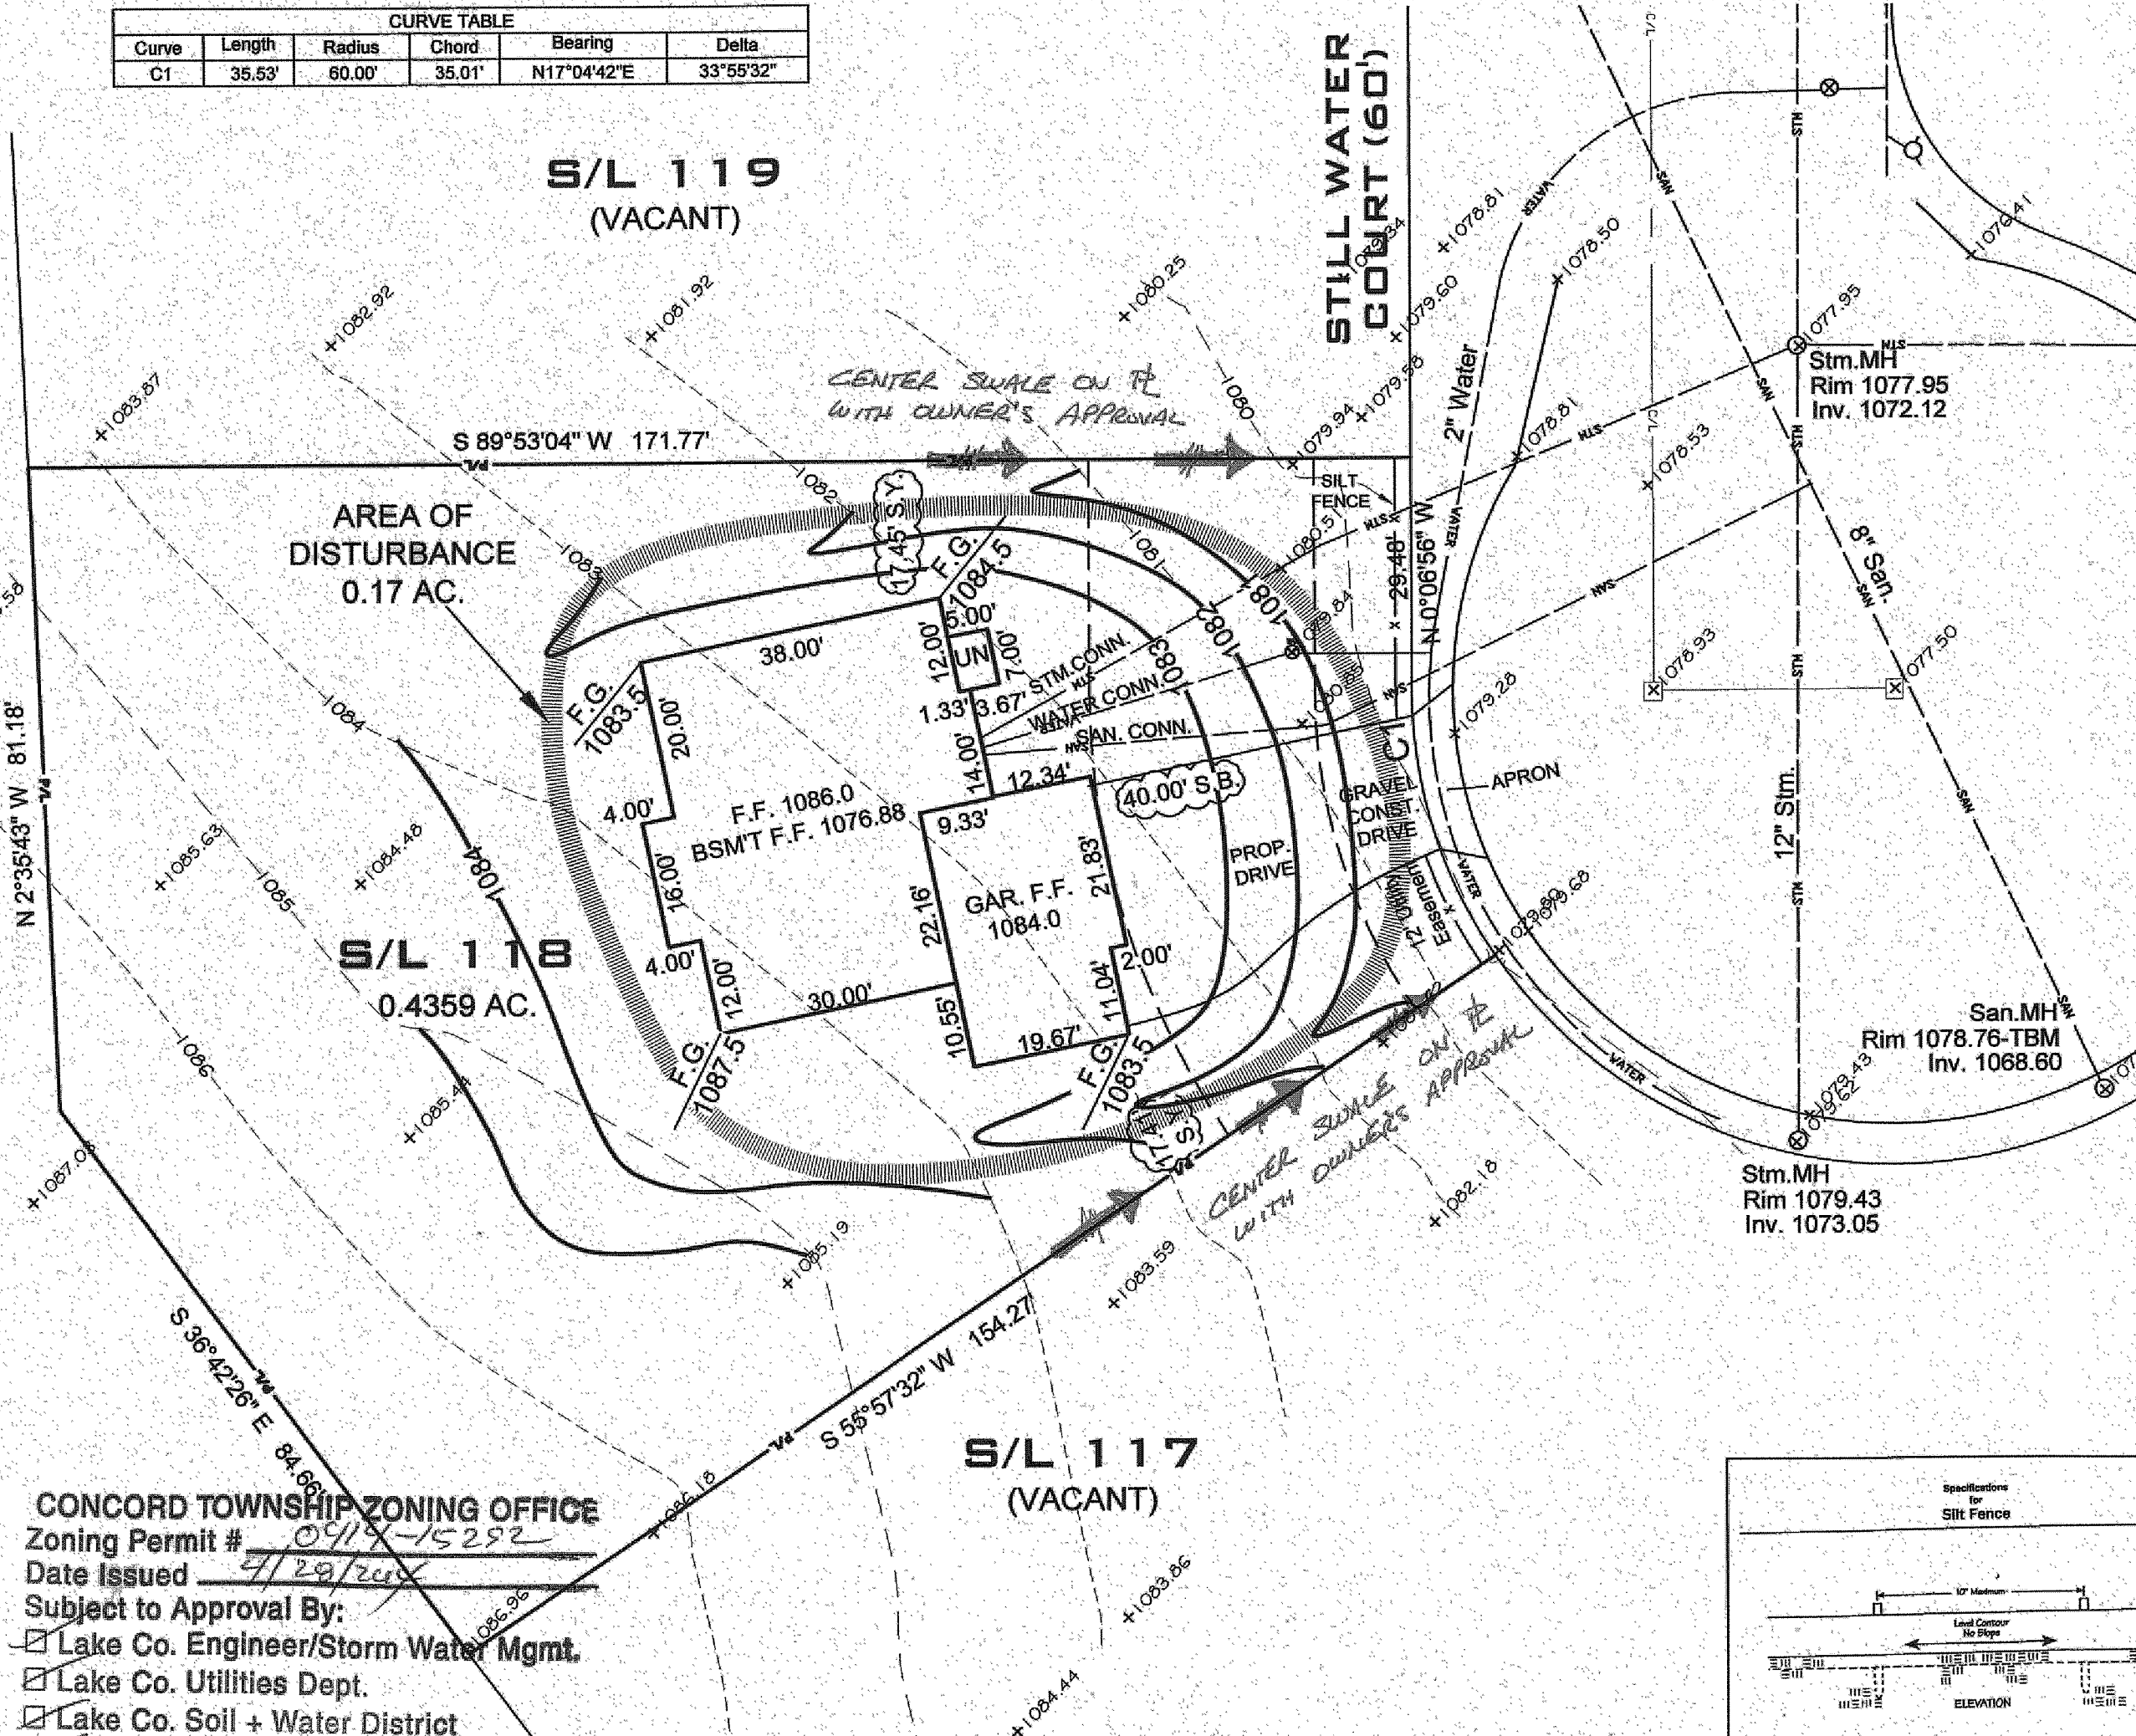



CURVE TABLE					
Curve	Length	Radius	Chord	Bearing	Delta
C1	35.53'	60.00'	35.01'	N17°04'42"E	33°55'32"

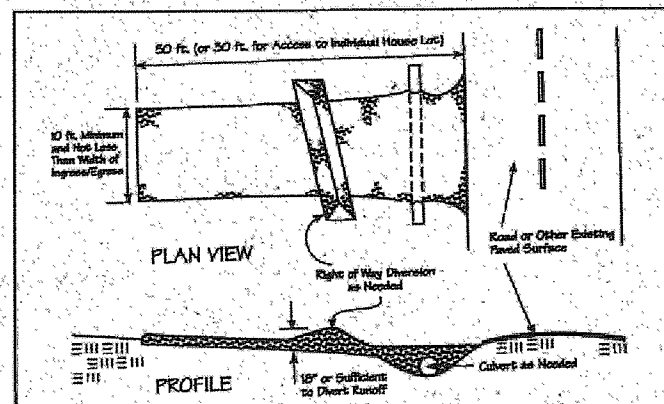

CONCORD TOWNSHIP ZONING OFFICE
 Zoning Permit # 0918-15282
 Date Issued 4/29/2014
 Subject to Approval By:
☒ Lake Co. Engineer/Storm Water Mgmt.
☒ Lake Co. Utilities Dept.
☒ Lake Co. Soil + Water District
☒ Lake Co. Health District
☒ Lake Co. Building Dept.

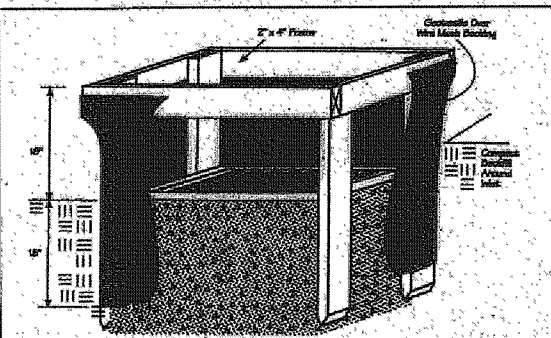

Temporary Seeding Species Selection			
Seeding Dates	Species	Lb./1,000 ft. ²	Per A.C.
March 1 to August 15	Oats	3	4 bushel
	Tall Fescue	1	40 lb.
	Annual Ryegrass	1	40 lb.
	Perennial Ryegrass	1	40 lb.
August 16 to November 1	Rye	3	2 bushel
	Tall Fescue	1	40 lb.
	Annual Ryegrass	1	40 lb.
	Perennial Ryegrass	1	40 lb.
November 1 to Spring Seeding	Wheat	3	2 bushel
	Tall Fescue	1	40 lb.
	Annual Ryegrass	1	40 lb.
	Perennial Ryegrass	1	40 lb.
Note: Other approved seed species may be substituted.			

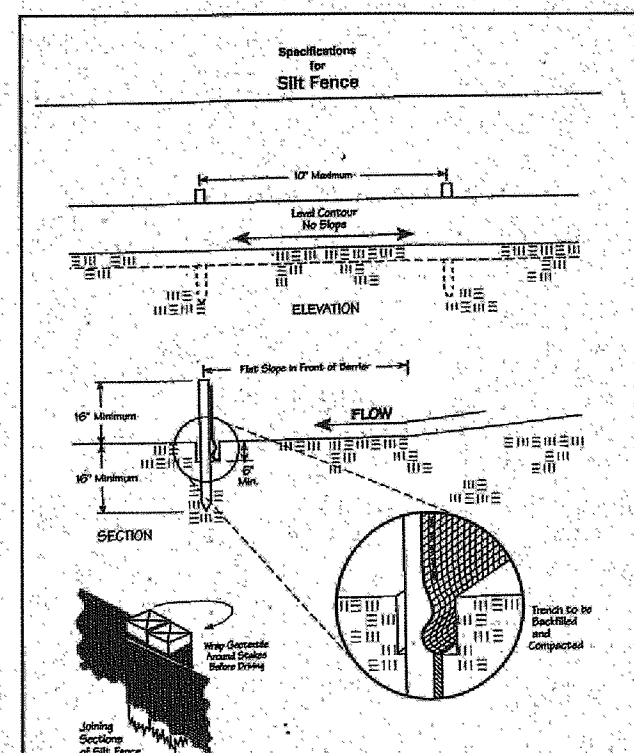

SITE PLAN

CONCORD TWP., LAKE County, Ohio


for: 20th CENTURY

CLIENT		OWNER	
ADDRESS	STREET	CITY	ZIP
STILL WATER COURT		TRACT	
SUBDIVISION	VOL.-PG.	NAME	STREET
118	STILL WATER COURT	LOT	PERM. PARCEL NO.
SUBLOT NO.	STREET	VOL.-PG.	PERM. PARCEL NO.

DESIGN CERTIFICATION

THIS PLAN WAS PREPARED BY ME, AND IS CORRECT TO THE BEST OF MY KNOWLEDGE AND BELIEF.

HARRY S. JONES, JR. SURVEYOR - REGISTRATION NO. 6343

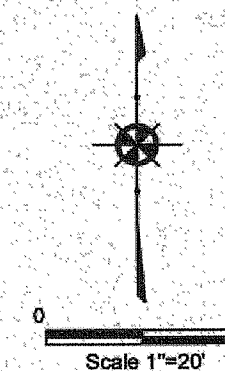

Erosion and Sediment Control Schedule

Ingress-Egress

A stone access drive complete with under lying geo-textile fabric (20 feet wide and 50 feet long) for ingress and egress at the site shall be installed. This drive shall be the only entrance and exit to the site.

Silt Fence

A silt fence shall be installed prior to any earthwork activities at the site in the locations shown on the site plan as well as along the front of any lot that slopes towards the street.

Temporary Seeding

Disturbed areas of the site that are to remain idle for more than fourteen(14) days shall be properly seeded and straw mulched within seven(7) days of completion of initial grading. Temporary seeding and mulching as a thirty(30) foot strip of the entire front of the lot shall be maintained on the site once initial grading is complete.

Stabilization of critical areas within fifty(50) feet of any stream or wetland shall be complete within two(2) days of the disturbance if the site is to remain inactive for longer than fourteen(14) days.

Mulching

Straw-mulch shall be applied at a rate of 1 bale per every ten (10) feet of curb, at a width of thirty(30) feet to the entire length of the lot. Wood chips may also be used but must be spread at a minimum depth of four inches over the thirty-foot width and must be accompanied by a properly installed silt fence.

Maintenance


Erosion and sediment controls shall be inspected every seven(7) days or within 24 hours of a 0.5" or greater rainfall event. Necessary repairs shall be made at this time.

SITE PLAN CERTIFICATION:

This plan was prepared by me and is correct to the best of my knowledge and belief.

I, the undersigned, hereby certify that this topography, indicated by 1' contours, and elevations shown hereon, represent an actual field survey made under my supervision on the 17th day of April, 2014 and that the elevations were taken at appropriate intervals and that as of that date they existed as indicated hereon.

HARRY S. JONES, JR. P.S. #6343

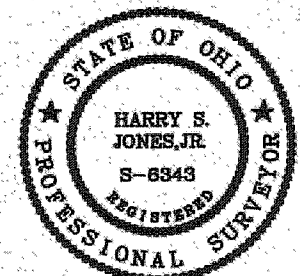

EXIST. ELEV. 100.0
 PROP. ELEV. 100.0
 AS BUILT ELEVATION 100.0
 INDICATES DIRECTION OF SURFACE DRAINAGE

2 WORKING DAYS BEFORE YOU DIG
 CALL TOLL FREE 800-362-2764
 OHIO UTILITIES PROTECTION SERVICE

"This plan has been prepared solely for the purpose of establishing grading, drainage, location of utility connections, and compliance with local zoning regulations and is based upon plans approved by agencies having jurisdiction. Jones Surveying, LLC does not warrant or guarantee structural components of the structure or the underlying soils".

BENCHMARK: RIM SAN. MH -1078.76

EXISTING UNDERGROUND UTILITIES NOTE:

"The size and location, both horizontal and vertical, of the underground utilities shown hereon, have been obtained by a diligent and comprehensive search of available records. Verification by field observation has been conducted where practical. However, Jones Surveying, LLC does not guarantee the completeness nor accuracy thereof."

REVISIONS			Jones Surveying, LLC	
NO.	DATE	BY		
1			ENGINEERS - SURVEYORS - PLANNERS	1924 MENTOR AVE., PAINESVILLE, OHIO 440-357-1811
2				440-357-9173 (FAX) hjonessurveying@yahoo.com
3			DRAWN BY	SCALE 1"=20'
4			CHKD.	DATE 4/18/14
5			CREW CHIEF	APPD HSJ
				PHONE NO. 440-357-1811
				DRAWING NO. 14-035