



Grading Plan Approved
shown and/or noted
by JOHNAS P. GILLES, P.E.
Lake County Engineer
Date 5/23/90
By GPH SEE ATTACHED NOTE!

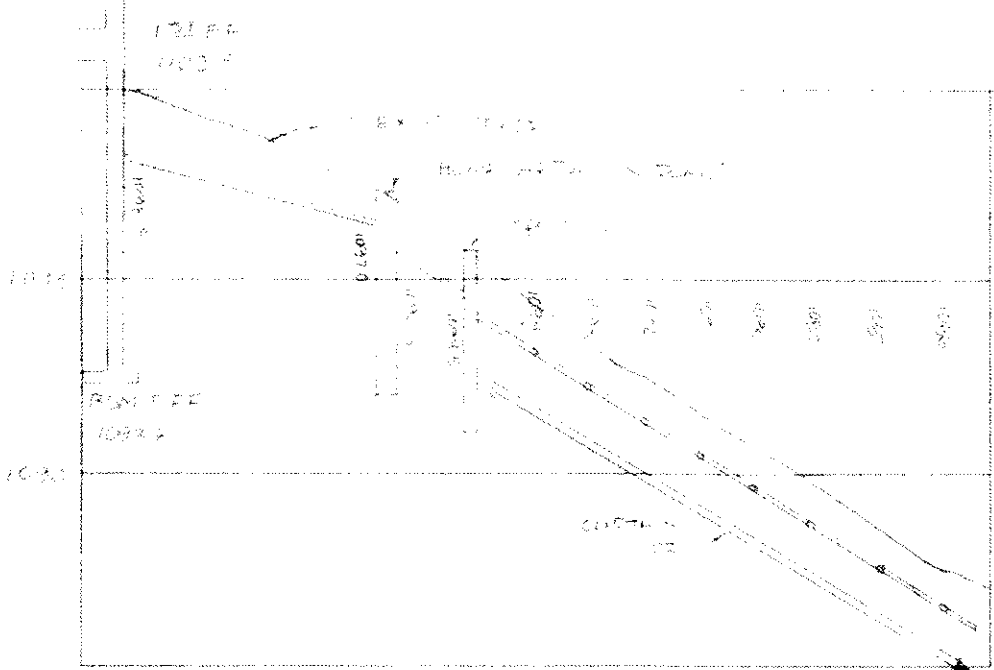

HYDRAULIC PROFILE
SCALE: HORIZ. 1\"/>

5-2-90
#6439
P. & M. Marano

Reviewed and Accepted
LAKE COUNTY GENERAL HEALTH DISTRICT
Date 5-21-90
JOEL LUDIA, R.S., M.P.H.
Health Commissioner
By [Signature]

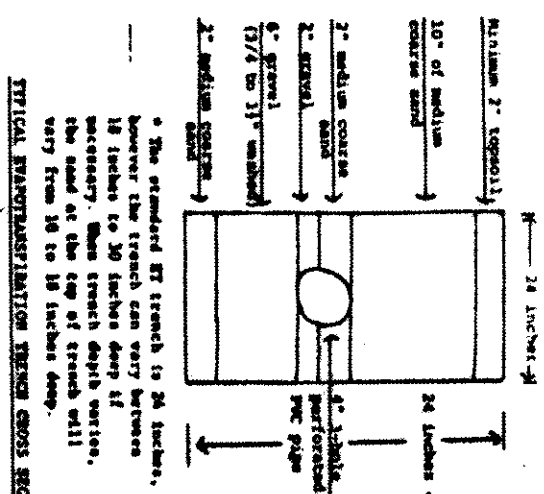

LOW YIELD WATER
FIXTURES REQUIRED
ON ALL
Shower Head
Toilet

SEWAGE DISPOSAL PERMIT MUST BE
OBTAINED BY A LAKE COUNTY LICENSED
INSTALLER BEFORE INSTALLATION IS
STARTED.

* The concrete depth must be 4 inches
above the top of the pipe. The concrete
must be finished and cured before
installing the tank.

DRAINAGE
EASEMENT

- A. To be brought to finished grade
1. Septic tank manhole covers
 2. Splitter box cover
 3. Distribution box cover
- B. No footer drains or downspouts
to be discharged into septic tanks
- C. All waste water to be discharged into
septic tanks

Test Hole
Jett Hole T-153
W/CLIPPER PICKER &
AUTOMATIC BACKLASH

SITE PLAN

CONTACT TOWNSHIP LAKE COUNTY, OHIO

for: KAY HONES

CLIENT OWNER

ADDRESS STREET CITY ZIP

SUBDIVISION 3-2-2 NAME LAKE COUNTY
VOL. 7 PG. 1
SUBLOT NO. 7 STREET LAKE COUNTY

LOT 7 TRACT 7
VOLUME 7 PAGE 7
PERM. PARCEL NO. 7 STREET 7

LEGEND

SANITARY MANHOLE ○ WATER VALVE (GAS) ○
STORM MANHOLE ● WATER METER (GAS) ○
INLET OR CATCH BASIN ○ AS BUILT ELEVATION ○
HYDRANT ○ EXISTING CONTOURS ○
PROPOSED CONTOURS ○ INDICATES DIRECTION OF SURFACE DRAINAGE ○
EXIST. ELEV. 100.0 PROP. ELEV. 100.0

REMARKS

ALL BOUNDARY DATA SHOWN WAS OBTAINED FROM IDEEDS, RECORDED
SUBDIVISION PLAT OR OTHER PUBLIC RECORDS!
LOCATIONS AS SHOWN OF ADJACENT WELLS AND SEPTIC TANKS OBTAINED FROM
LAKE COUNTY HEALTH DEPARTMENT

DESIGN CERTIFICATION

THIS PLAT WAS PREPARED BY ME, AND IS CORRECT
TO THE BEST OF MY KNOWLEDGE AND BELIEF.

CHECK LIST

WATER MAIN SIZE, LOCATION
SAN. SEWER SIZE, % GR. LOC.
SAN. MH. CAST ELEV. INV. ELEV.
SAN. CONN. SIZE, LOC. DEPTH
STORM SEWER SIZE, % GR. LOC.
STORM MH. CAST ELEV. INV. ELEV.
PAV'T TYPE, GRADE CURBS
SEPTIC TANK LOCATION & DIMENSIONS
WELL LOCATION
ISOLATION RADIUS FROM WELL

PLAN PREPARED BY:
BABCOCK • JONES & ASSOCIATES, INC.
PAINESVILLE, OHIO

NO.	DATE	BY	SCALE	PHONE NO.
1	5/18/90	HT	1" = 30'	357-1811
2				
3				
4				
5				

DRAWN BY HT DATE 5/18/90 DRAWING NO. 357-1811
CHK'D. HT DATE 5/18/90
CREW HT APP'D. HT

"AS BUILT" CERTIFICATION

I, HEREBY CERTIFY THAT THE CIRCLED GRADES ARE EXISTING
FINISH GRADES CHECKED IN THE FIELD ON 5/18/90
AND ARE CORRECT TO THE BEST OF MY KNOWLEDGE AND BELIEF.

REGISTERED SURVEYOR REG. NO. 19

"I, the undersigned hereby certify that this topography
indicated by 6", 1" or 2" contours, and elevations shown
hereon represent an actual field survey made by me on
the 18th day of May, 1990 and that the
elevations were taken at appropriate intervals and that as
of that date they existed as indicated hereon."

Name [Signature]

Reg. No. 19