


V:\2002\02135\02135.dwg, 12/27/02 09:21:18 AM, Copyright Barrington Consulting Group

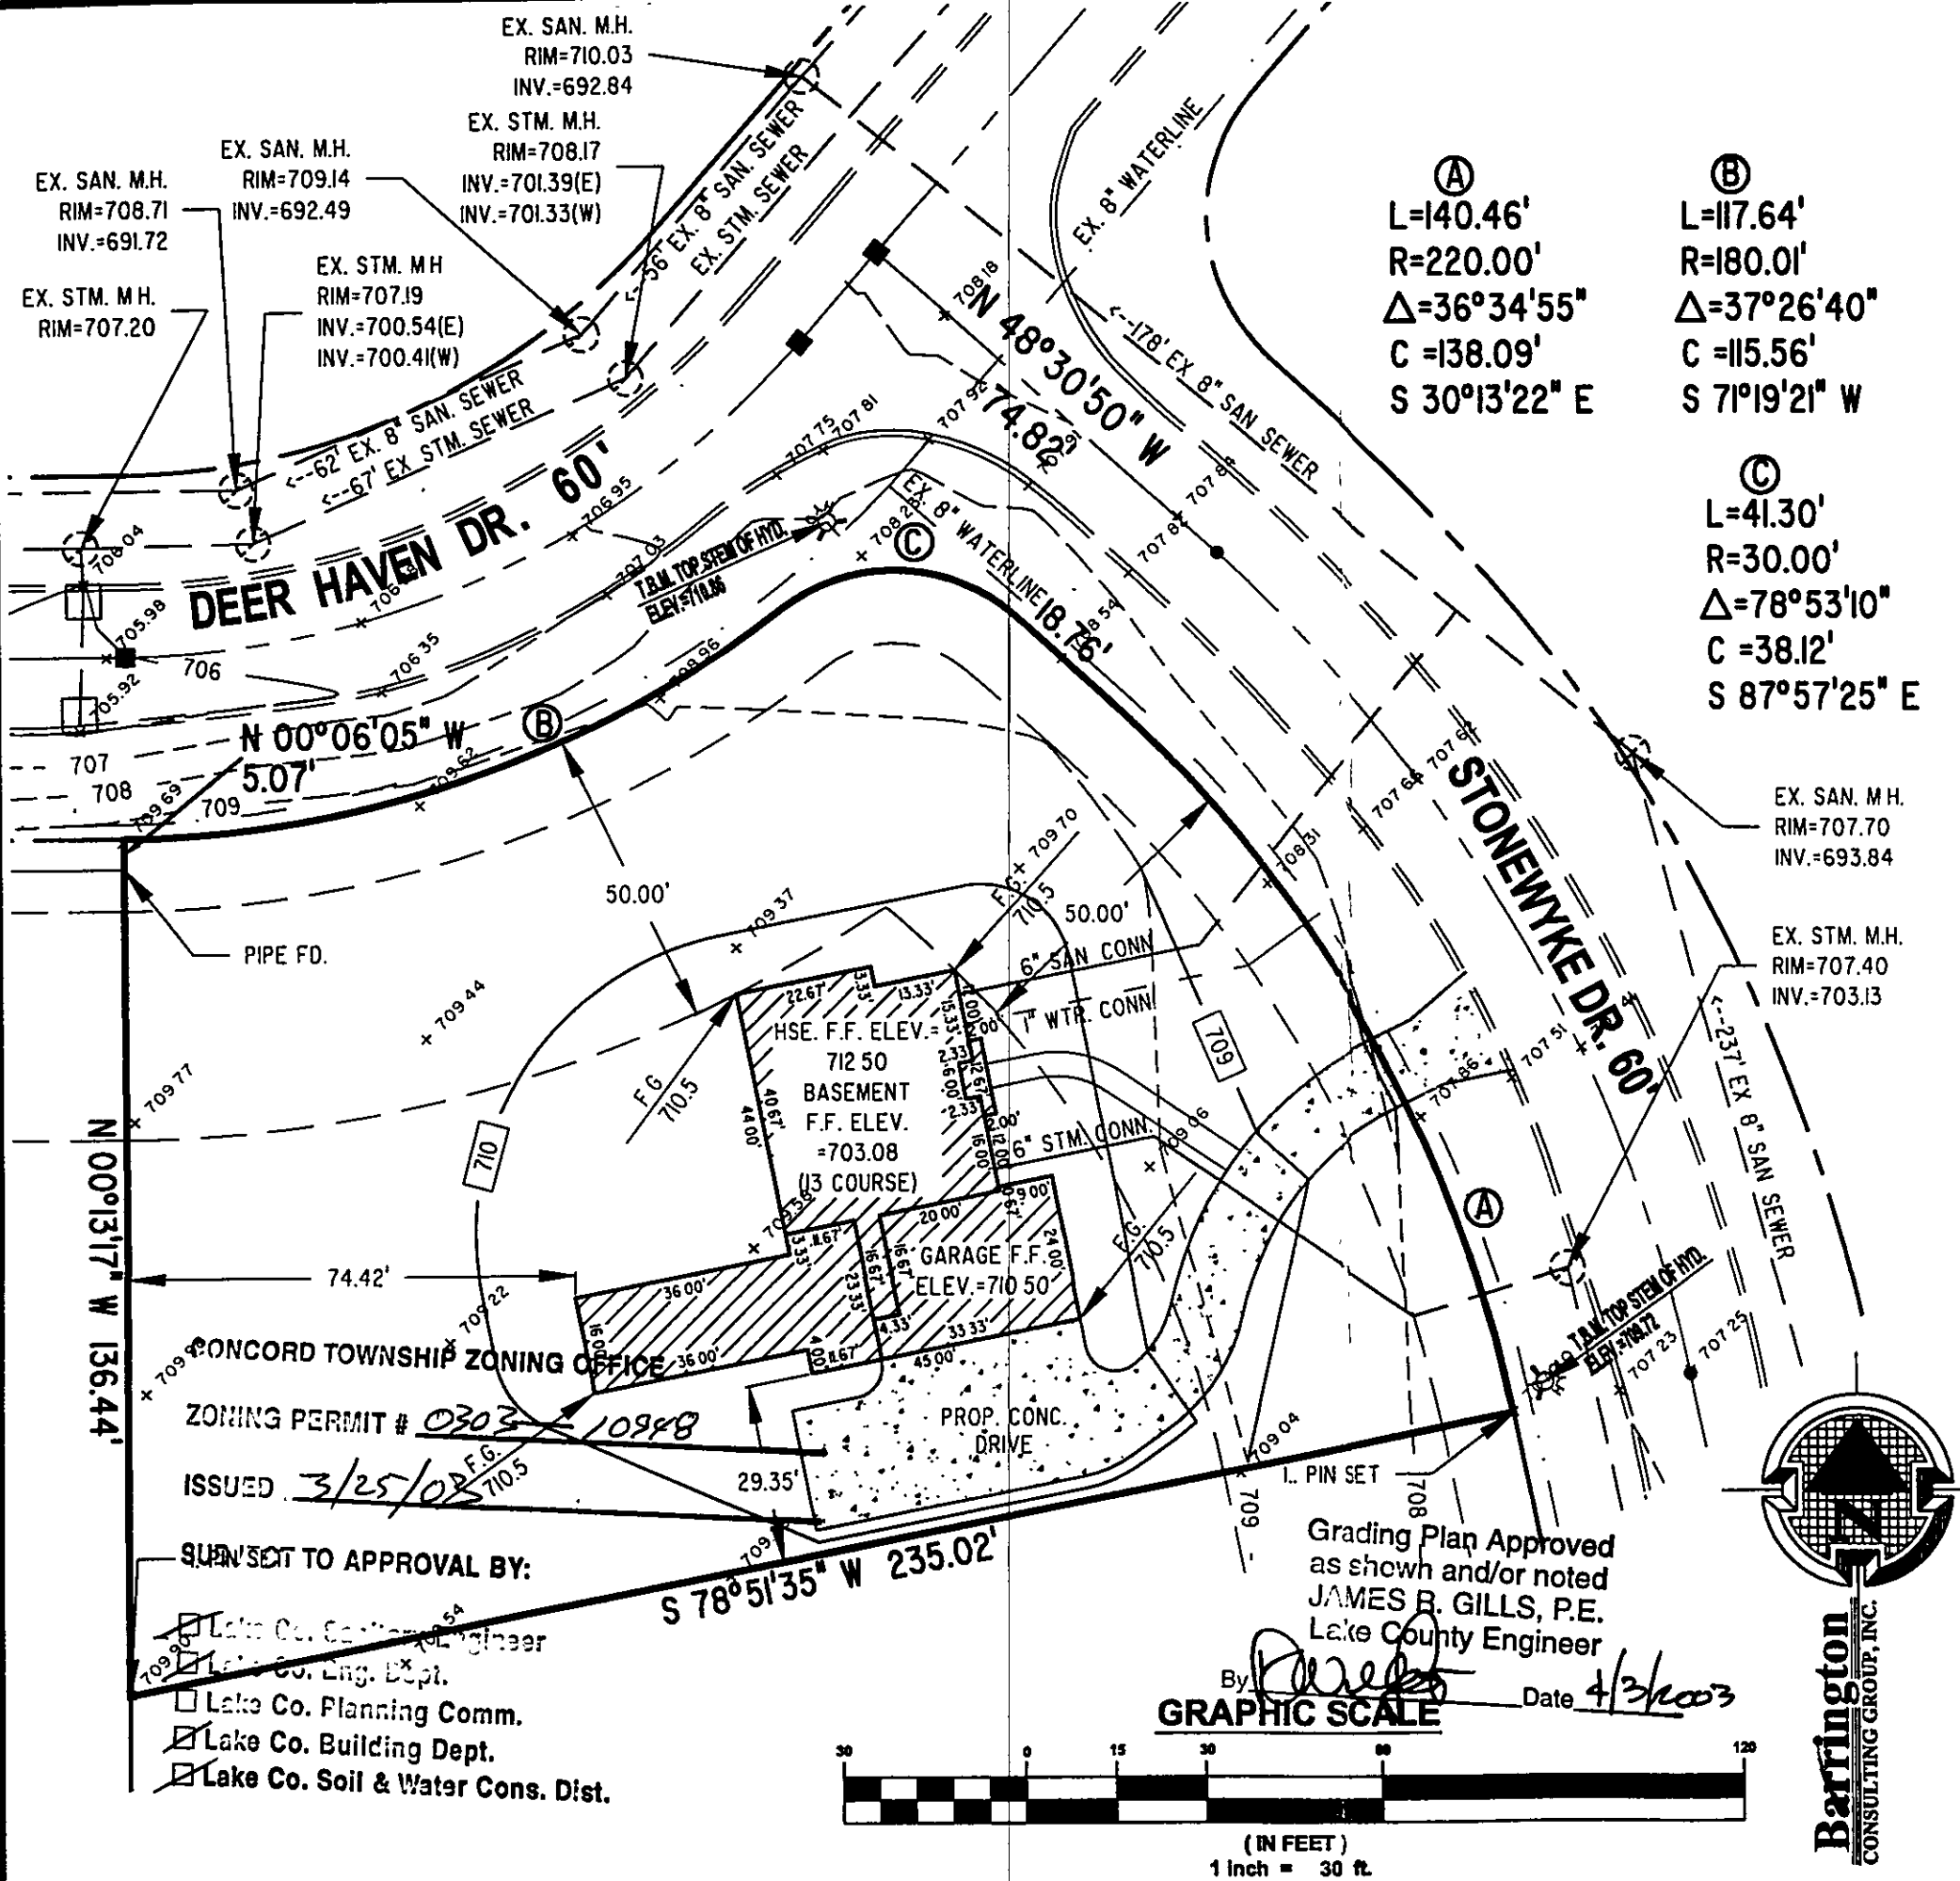

#### GENERAL NOTES:

1. BENCHMARK - TOP STEM OF EXISTING FIRE HYDRANT LOCATED IN FRONT OF SUBLOT No. 106, ELEVATION = 710.86.
2. CONCRETE SIDEWALK TO FIVE FEET WIDE AND FOUR INCHES THICK, SIDEWALK TO BE SIX INCHES THICK AT DRIVEWAY APRON.
3. ALL DOWNSPOUTS TO BE OUTLETED TO SPLASH BLOCKS.
4. SUMP PUMP REQUIRED FOR BASEMENT.
5. CONTRACTOR RESPONSIBLE FOR CONTACTING THE OHIO UTILITY PROTECTION SERVICE (1.800.362.2764) AND ALL UTILITY COMPANIES A MINIMUM OF 48 HOURS PRIOR TO CONSTRUCTION.
6. THE LOCATION BOTH HORIZONTAL AND VERTICAL OF EXISTING UNDERGROUND UTILITIES SHOWN HEREON, HAVE BEEN OBTAINED BY A DILIGENT AND COMPREHENSIVE SEARCH OF AVAILABLE RECORDS. VERIFICATION BY FIELD OBSERVATION HAS BEEN CONDUCTED WHERE PRACTICAL, HOWEVER, BARRINGTON CONSULTING GROUP, INC. DOES NOT GUARANTEE THE COMPLETENESS, NOR ACCURACY THEREOF.
7. CONTRACTOR SHALL VERIFY ELEVATIONS OF LATERAL INVERTS IN THE FIELD PRIOR TO FOUNDATION EXCAVATION.

#### CERTIFICATION :

"I THE UNDERSIGNED HEREBY CERTIFIES THAT THIS TOPOGRAPHY INDICATED BY 1 FOOT CONTOURS AND ELEVATION SHOWN HEREON REPRESENTS AN ACTUAL SURVEY MADE BY ME ON THE 16th DAY OF DECEMBER, 2002 AND THE ELEVATIONS WERE TAKEN AT AN APPROPRIATE INTERVAL AND AS OF THAT DAY THEY EXISTED AS INDICATED HEREON.

"I HEREBY CERTIFY THAT THIS PLAN WAS PREPARED BY ME AND IS CORRECT TO THE BEST OF MY KNOWLEDGE AND BELIEF"

DAVID W. NOVAK, P.S. No. 7507

#### "AS-BUILT"

PROPOSED FINISH FLOOR OF HOUSE = \_\_\_\_\_  
"AS-BUILT" TOP OF BLOCK = \_\_\_\_\_  
"AS-BUILT" FINISH FLOOR OF HOUSE = \_\_\_\_\_

"I HERE BY CERTIFY THAT THE "AS-BUILT" GRADE WAS CHECKED IN THE FIELD ON THE \_\_\_\_ DAY OF \_\_\_\_, 2002


DAVID W. NOVAK, P.S. No. 7507

CERT-2.DWG

02135

REVISIONS	BY

**Barrington**  
CONSULTING GROUP, INC.  
3842 WESTERN PARKWAY, SUITE 10  
WILLOUGHBY, OHIO 44094  
PHONE 440.946.1761 FAX 440.918.0486

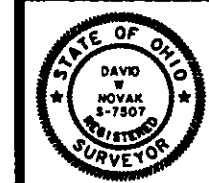

**SITE PLAN**  
S/L 106 STONEWYKE DRIVE, ELLISON CREEK SUB. PH. 3  
CONCORD, OHIO 44077  
**BETTER BUILDERS**

DRAWN WSO
CHECKED DWN
DATE DEC. 17, 2002
SCALE 1" = 30'
JOB NO. 02135
SHEET 111
OF SHEETS