

SIL 17

N 45° 44' 50" W
387.84'



133.09'
N 10° 38' 34" E

268.14'
N 45° 18' 50" W

NORTH

EXISTING HOUSE
F.P.L. 732.17

STUART DR.

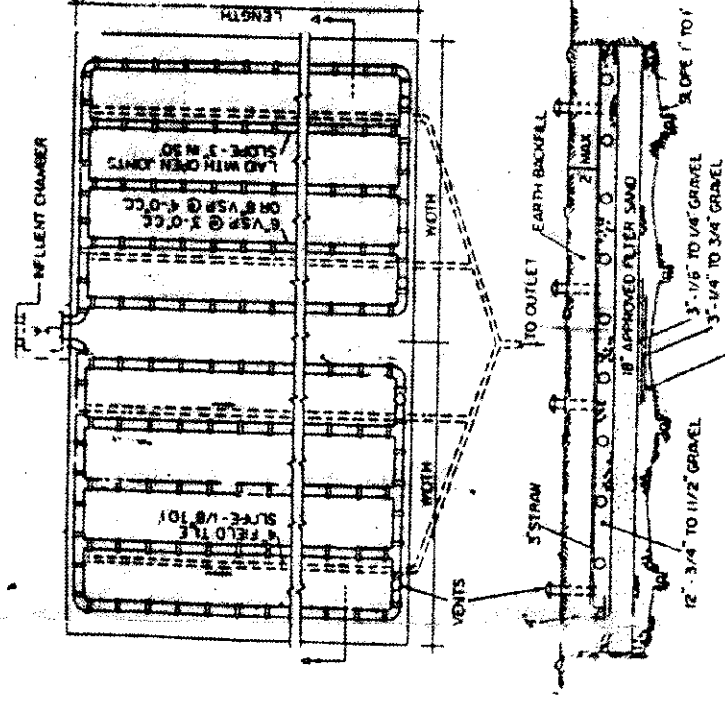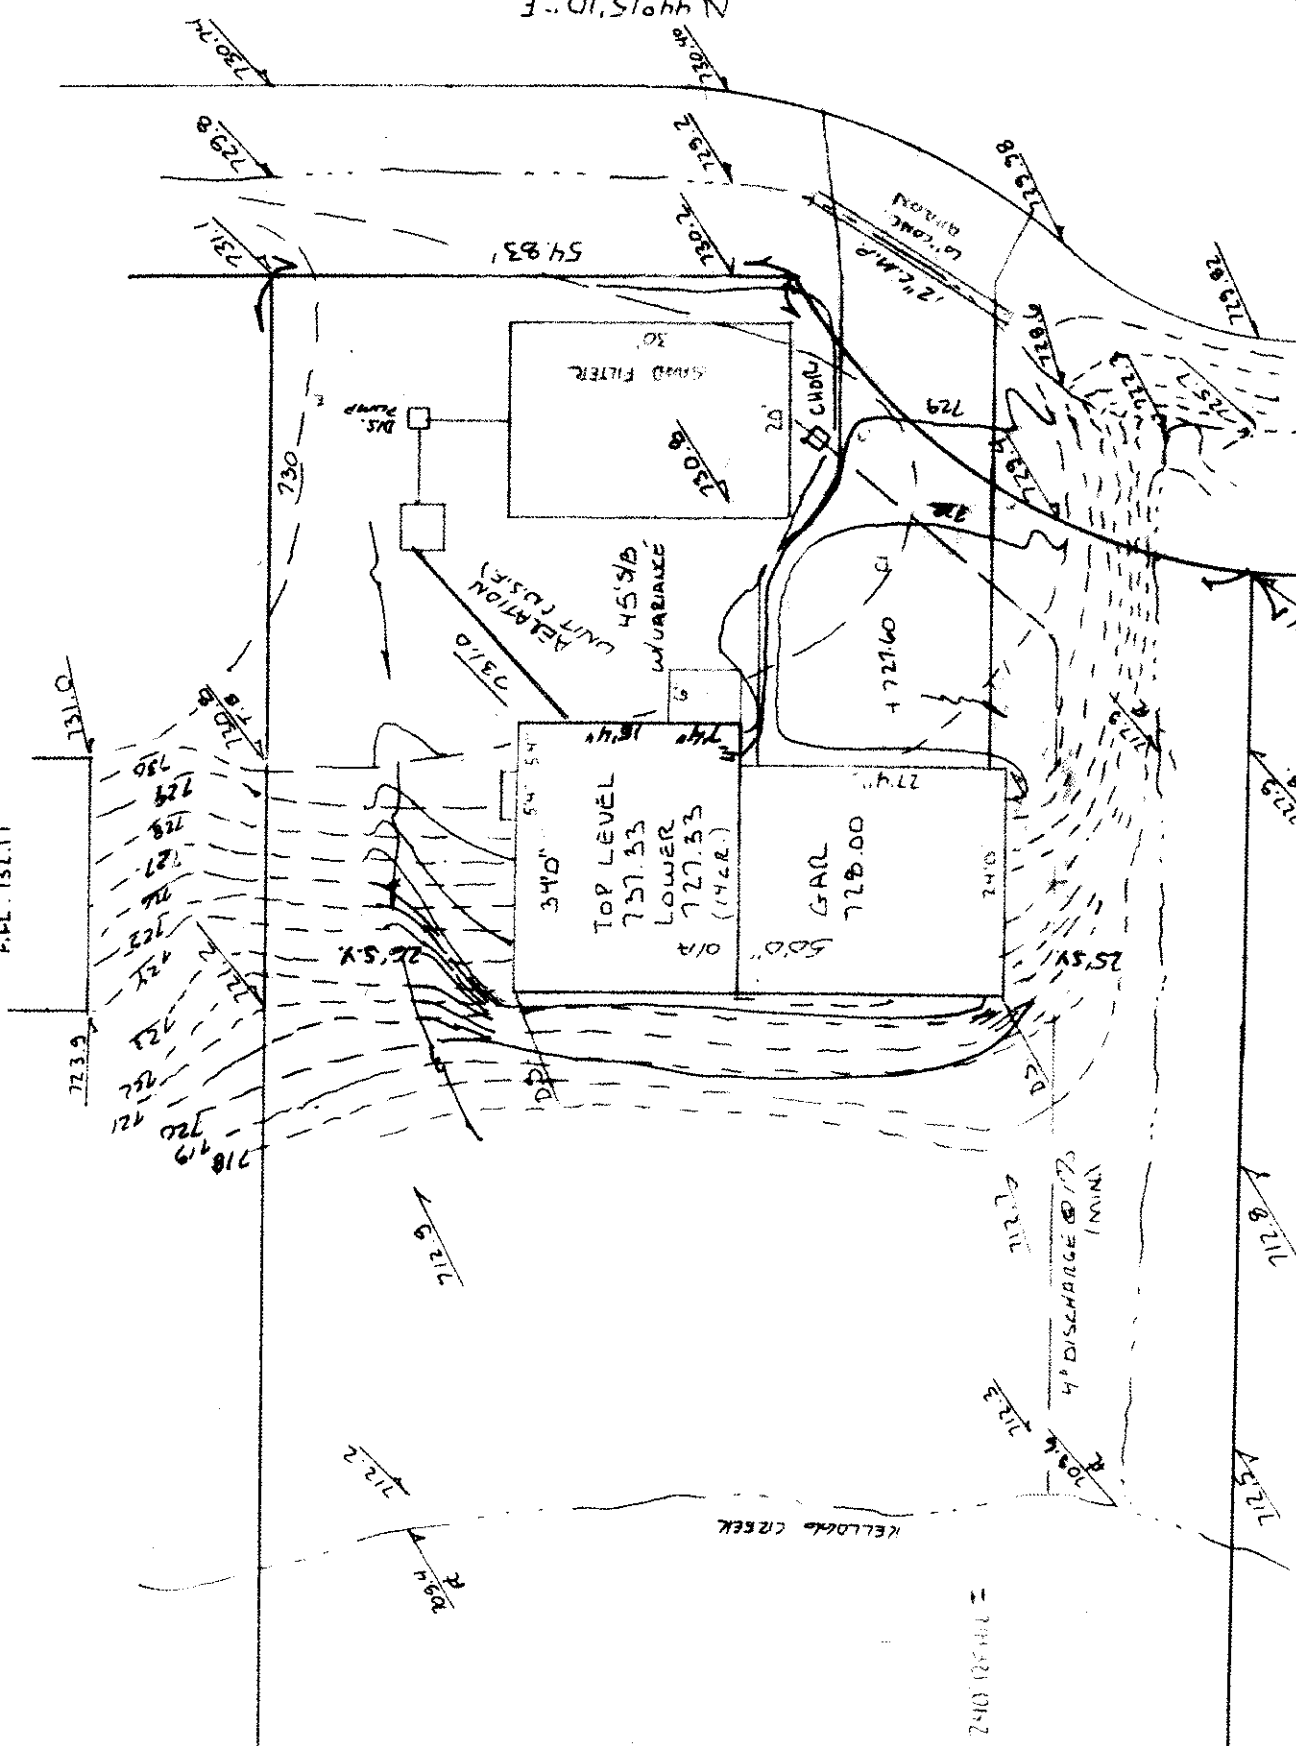

SECTION A-A
SUBSURFACE SAND FILTERS

PROFILE HOR. 1" = 30'
VER. 1" = 5'

Grading Plan Approved
as shown and/or noted
THOMAS P. GILLES, P.E.
Lake County Engineer

By GJA Date 3/23/93
KELLOGG CREEK HAS A DEFINED
100 YEAR FLOOD PLAIN BOUNDARY AS
DESIGNATED BY FEMA. ALL
STIPULATIONS MUST BE MET.

SITE PLAN FOR:
WAYNE S. HORTON

SCALE: 1" = 10'	APPROVED BY	DRAWN BY F.J.H.
DATE: MAR. 93		
BEING SUBMIT 18 IN THE SPRING VALLEY ESTATES S&BD. TOWNSHIP OF CONCORD - LAKE COUNTY - OHIO		
		DRAWING NUMBER 93-1127

I CERTIFY THAT THIS PLAN
WAS PREPARED BY ME AND
IS CORRECT TO THE BEST OF
MY KNOWLEDGE AND BELIEF

John C. Skonieczny
REG. SURVEYOR 6656

JOHN C. SKONECZNY
7739 VIEWMOUNT DR.
PAINESVILLE, OHIO 44077
PH. 352-7742

