

SITE PLAN

CONCORD TOWNSHIP, LAKE COUNTY, OHIO

for: **LAY HOLLER** OWNER

7721 SOUTHWIND DR. CONCORD, OHIO 43087

SPRING VALLEY EST.
SUBDIVISION: **SPRING VALLEY**
VOL. **25** PAGE **12**
SUBLOT NO. **24** STREET **SPRING VALLEY DR.**

LOT	TRACT
24	12
VOLUME	PAGE
25	12
PERMIT PARCEL NO.	STREET
24	SPRING VALLEY DR.

REMARKS
ALL BOUNDARY DATA SHOWN WAS OBTAINED FROM (DEEDS, RECORDED SUBDIVISION PLAT OR OTHER PUBLIC RECORDS)
LOCATIONS AS SHOWN OF ADJACENT WELLS AND SEPTIC TANKS OBTAINED FROM LAKE COUNTY HEALTH DEPARTMENT

DESIGN CERTIFICATION
THIS PLAT WAS PREPARED BY ME, AND IS CORRECT TO THE BEST OF MY KNOWLEDGE AND BELIEF.
NAME: **Harry S. Jones, Jr.**
SURVEYOR REGISTRATION NO. **6393**

NO. OF BEDROOMS	WATER MAIN SIZE, LOCATION
3	8" IN. CAST. IRON, INV. ELEV. 100.0
SEWER MAIN SIZE, LOCATION	SEWER MAIN SIZE, LOCATION
8" IN. CAST. IRON, INV. ELEV. 100.0	8" IN. CAST. IRON, INV. ELEV. 100.0
SEWER MAIN SIZE, LOCATION	SEWER MAIN SIZE, LOCATION
8" IN. CAST. IRON, INV. ELEV. 100.0	8" IN. CAST. IRON, INV. ELEV. 100.0
SEWER MAIN SIZE, LOCATION	SEWER MAIN SIZE, LOCATION
8" IN. CAST. IRON, INV. ELEV. 100.0	8" IN. CAST. IRON, INV. ELEV. 100.0


NO.	DATE	BY
1	8/2/82	HSJ
2	8/2/82	HSJ
3	8/2/82	HSJ
4	8/2/82	HSJ
5	8/2/82	HSJ

"AS BUILT" CERTIFICATION
I, HEREBY CERTIFY THAT THE CIRCLED GRADES ARE EXISTING FINISH GRADES CHECKED IN THE FIELD ON **19** AND ARE CORRECT TO THE BEST OF MY KNOWLEDGE AND BELIEF.

REGISTERED SURVEYOR REG. NO. **6393**



Grading Plan Approved as shown and/or noted
THOMAS P. GILLES, P.E.
Lake County Engineer
By: **Harry S. Jones, Jr.** Date: **8.11.82**

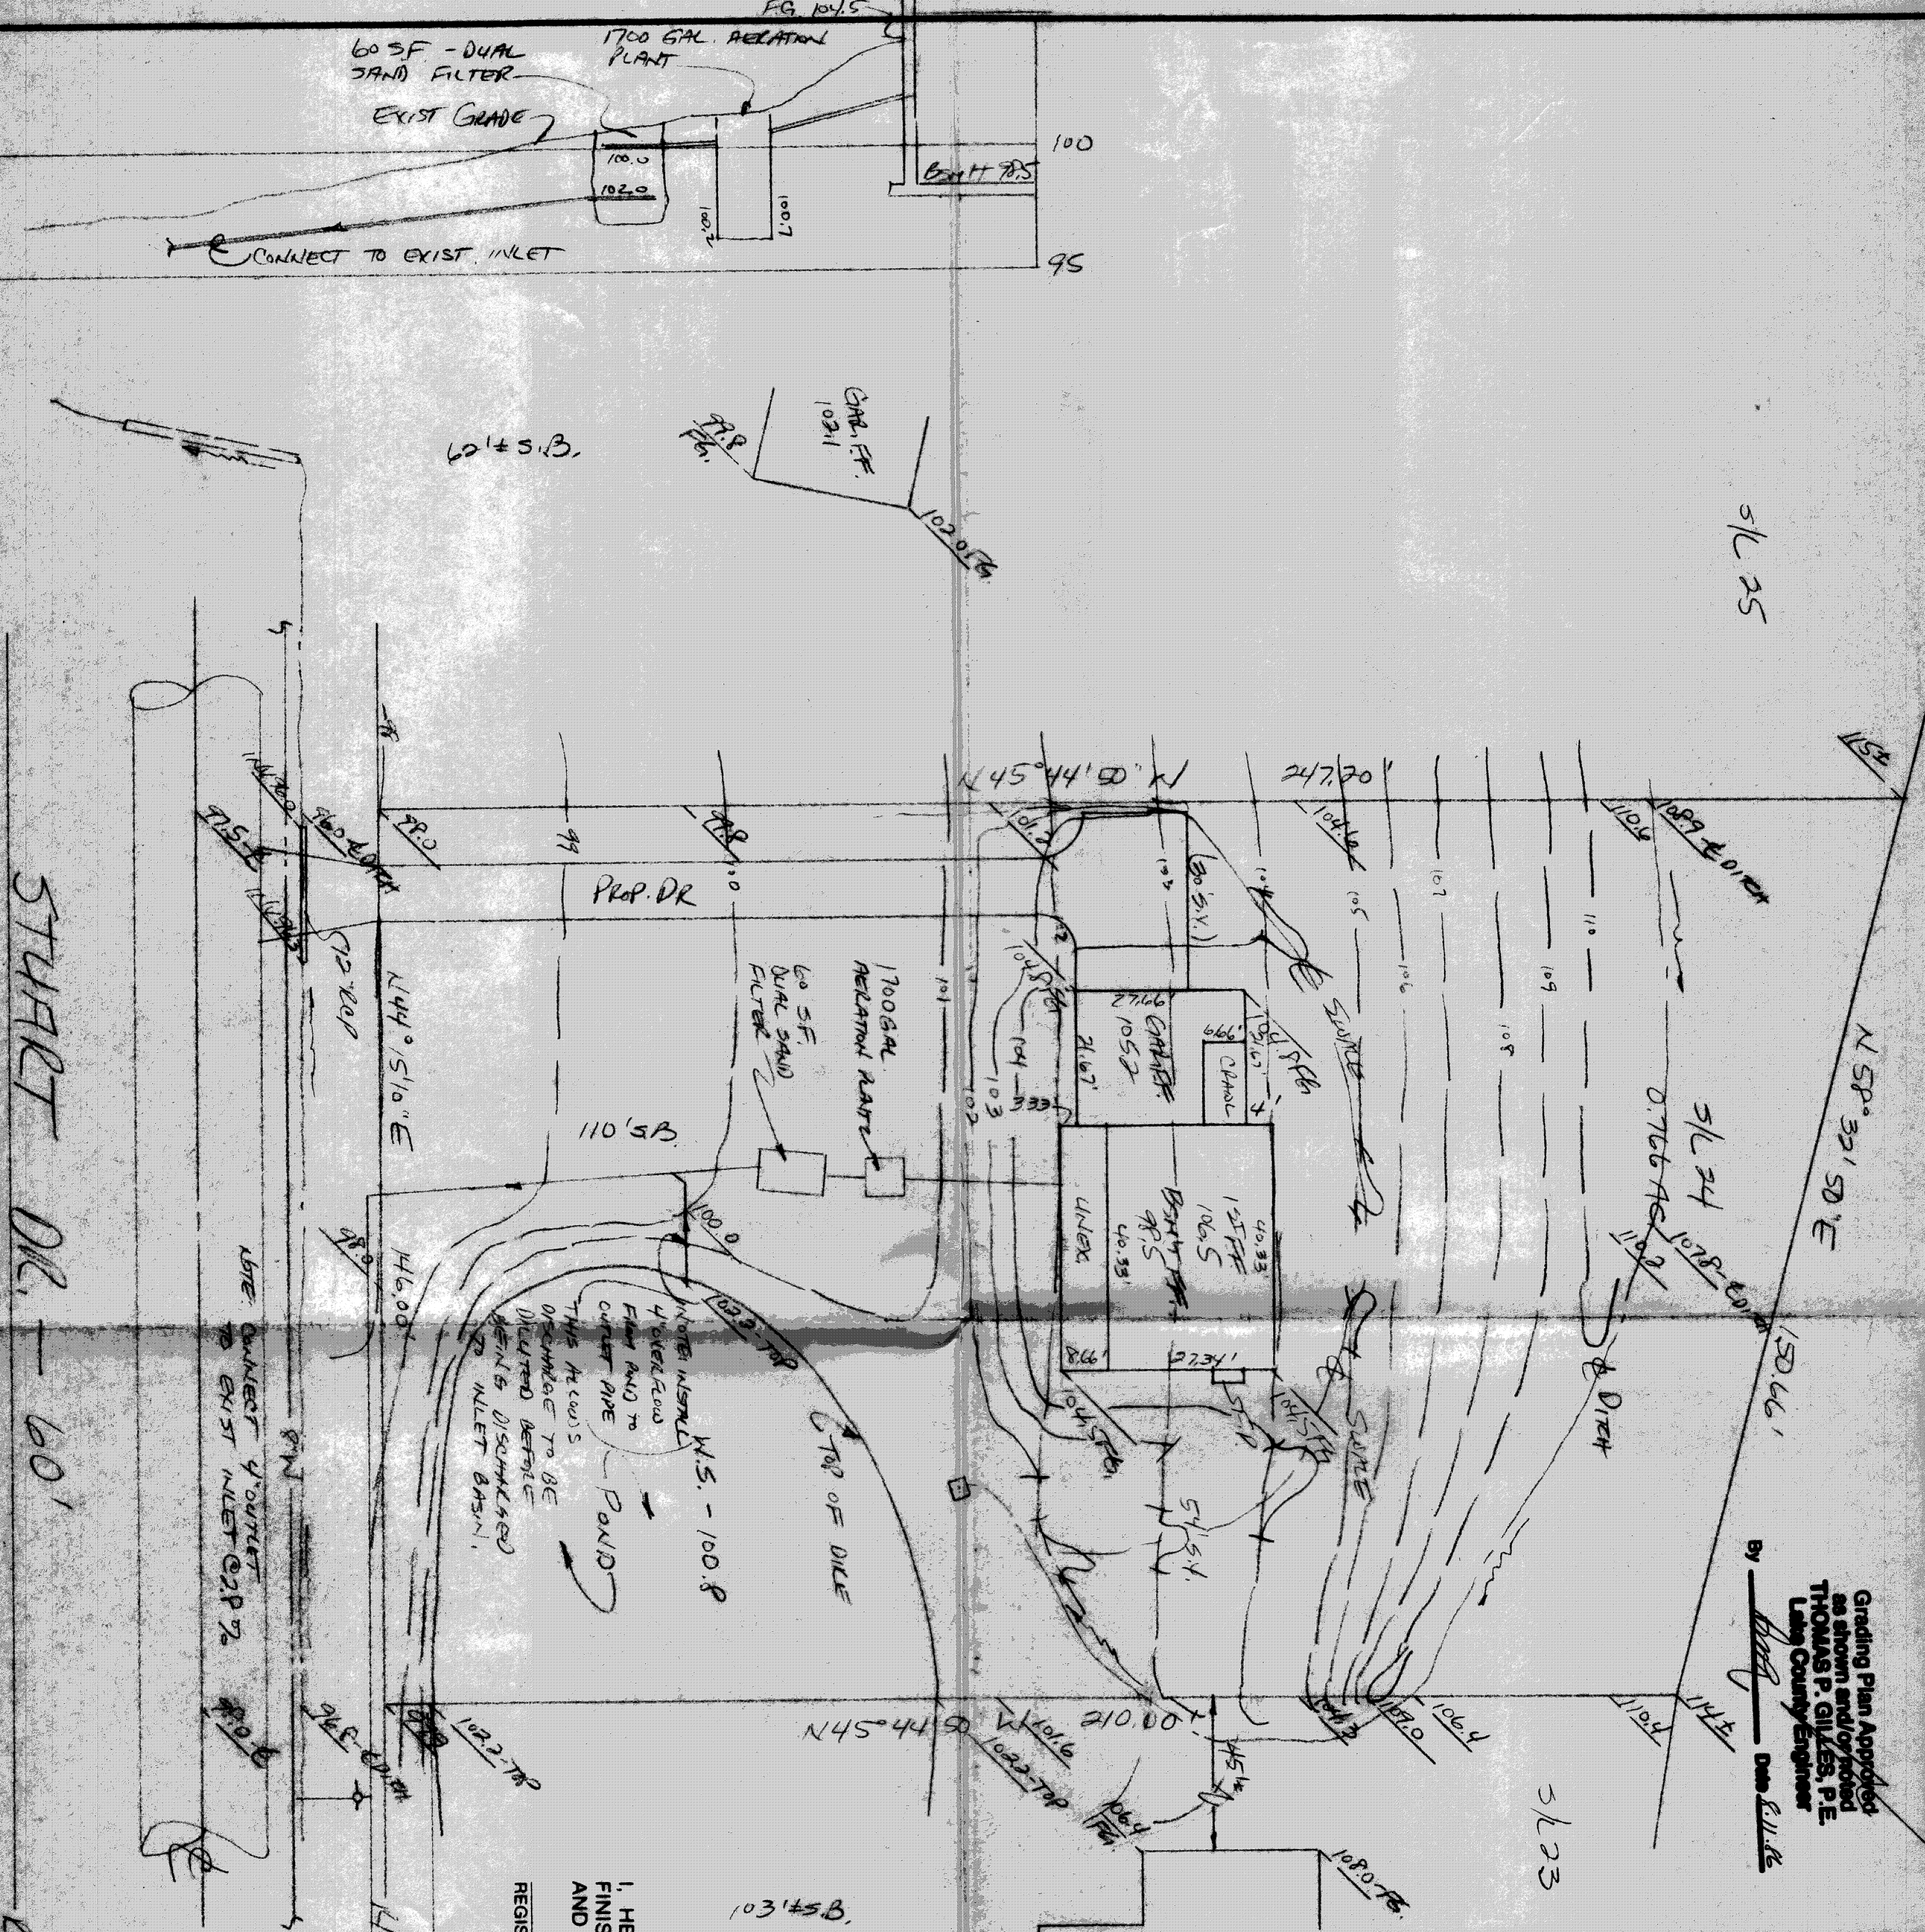

STUART DR. - 60' RW

T.B.M. - T.S.F.H. - ELEV. - 100.00