


- ☐ Lake Co. Sanitary Engineer
☒ Lake Co. Eng. Dept.
☐ Lake Co. Planning Comm.
☒ Lake Co. Building Dept.
☒ Lake Co. Soil & Water Cons. Dist.

NOTE: TEMPORARY SEEDING REQUIRED
IN DISTURBED AREAS.

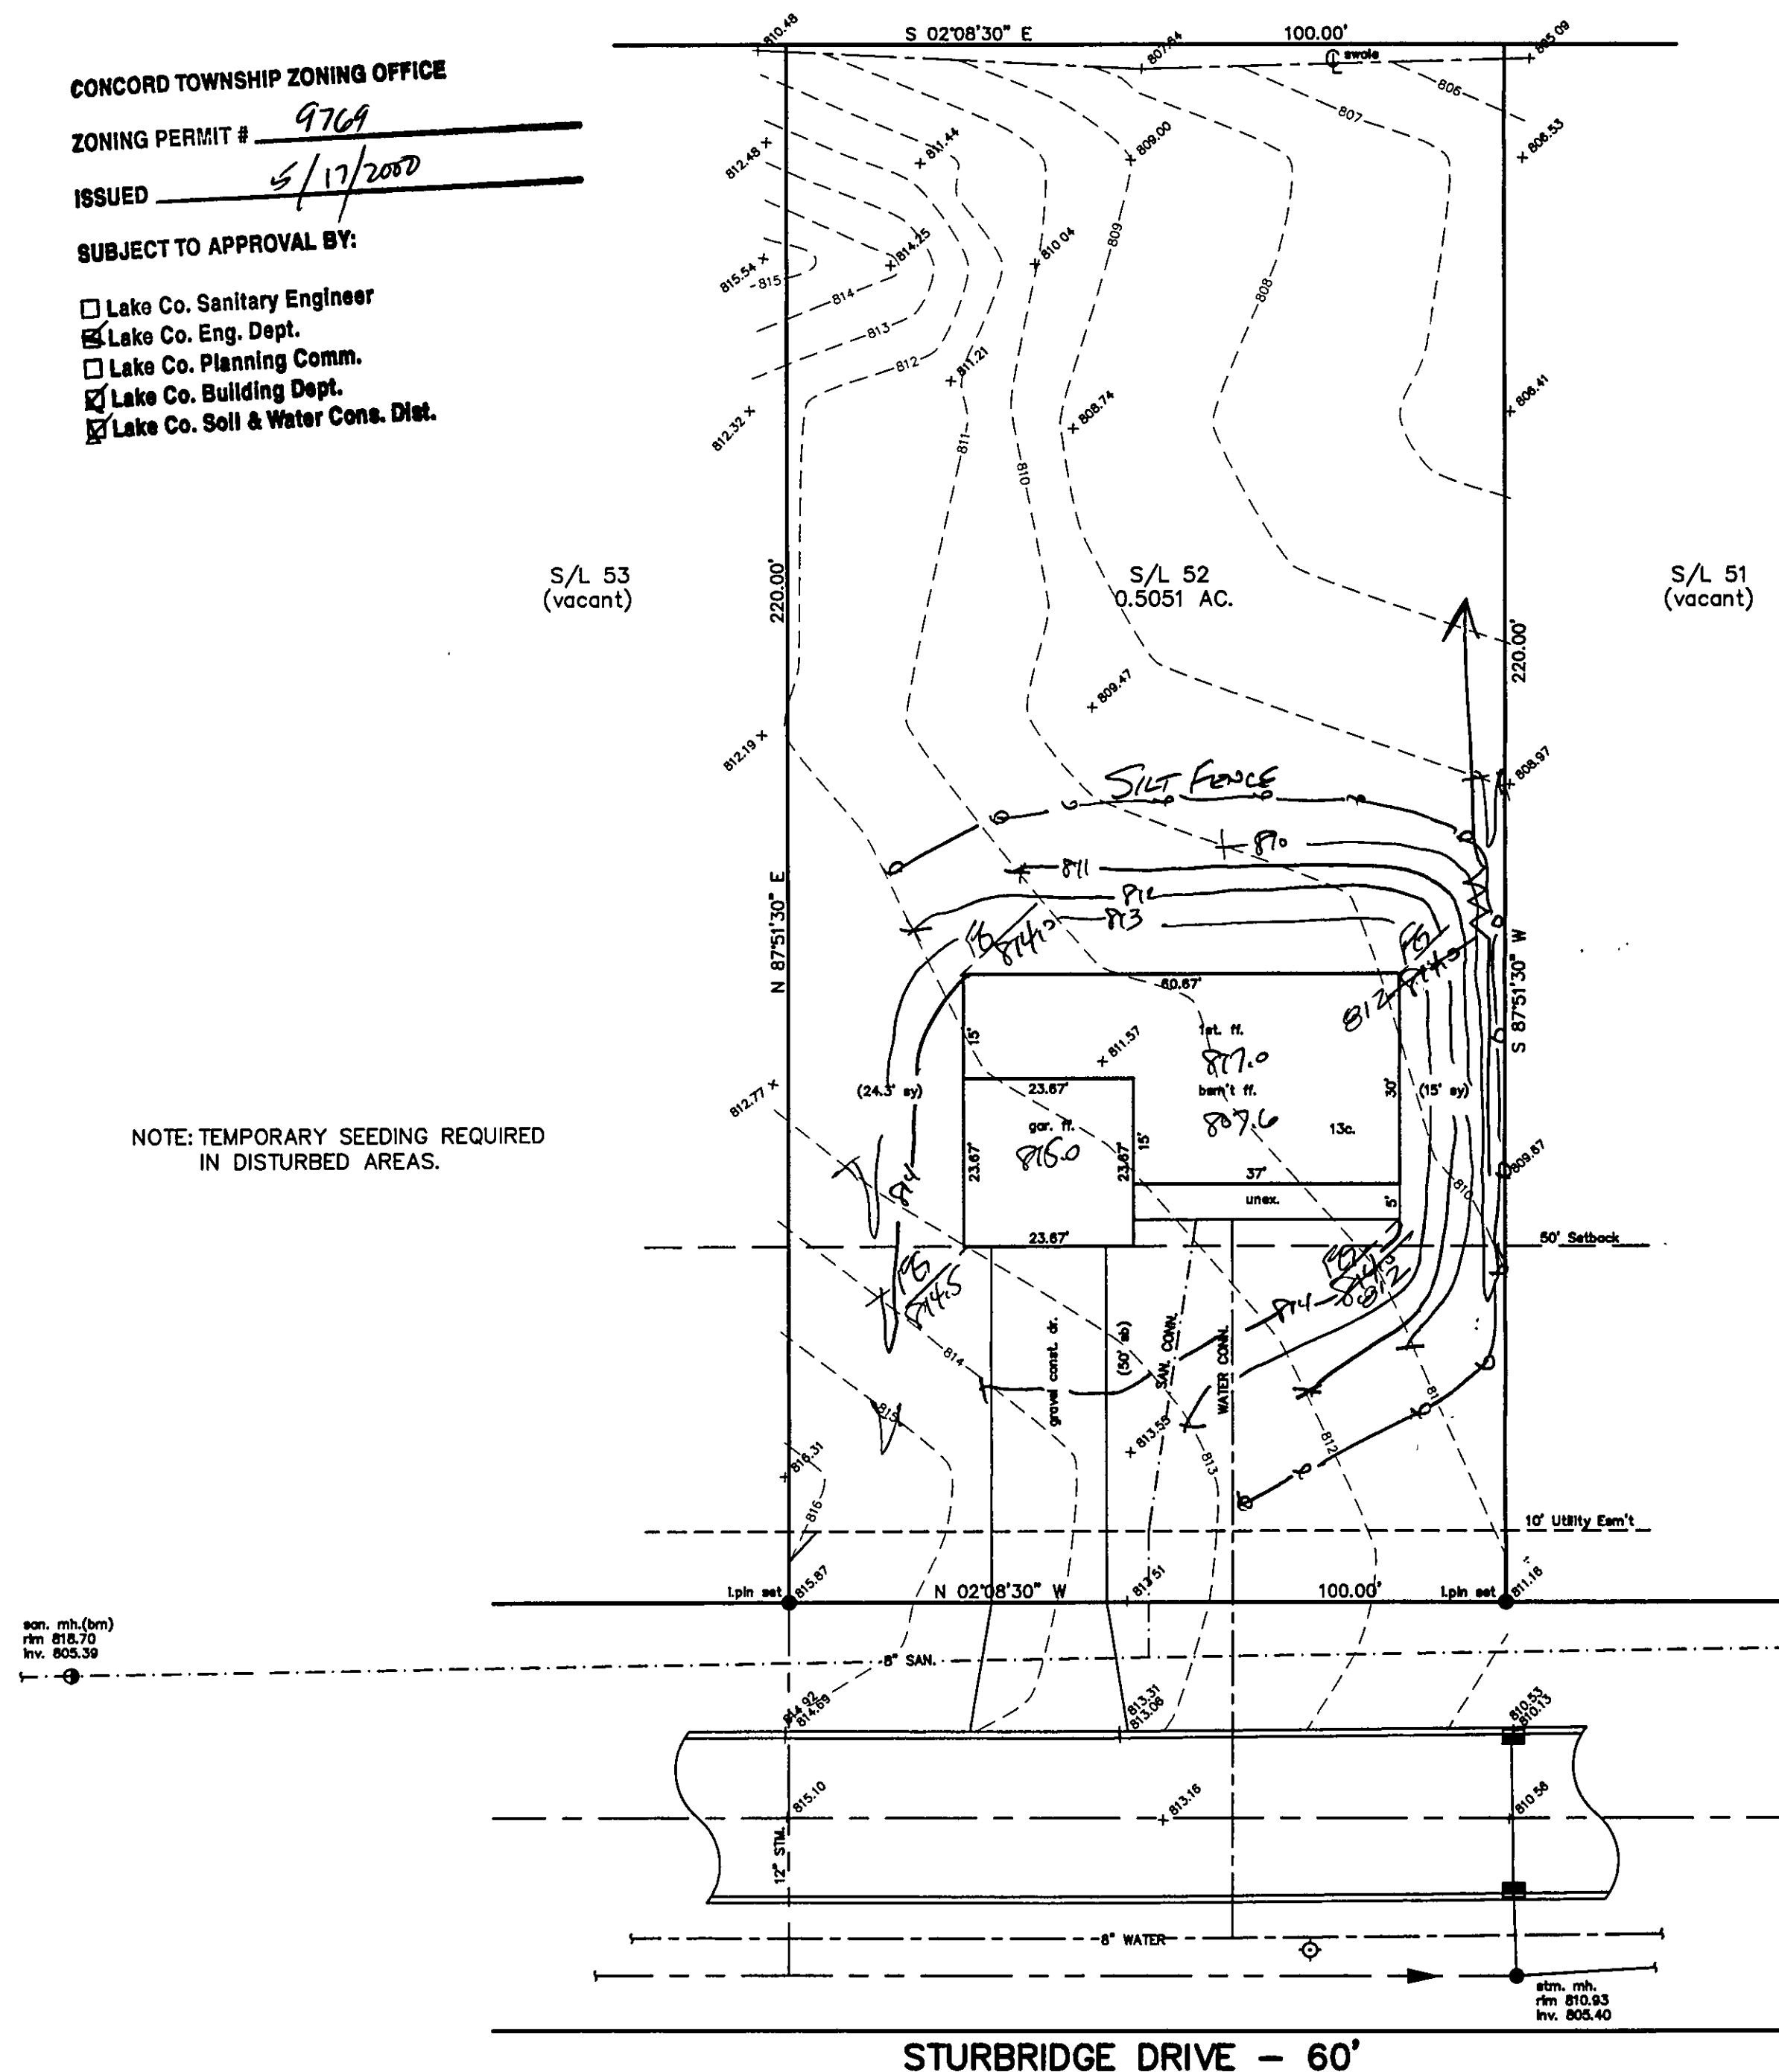

SITE PLAN

CONCORD TOWNSHIP.LAKE COUNTY, OHIO

for: STADEN HOMES

101. STADEN HOMES			
CLIENT		OWNER	
ADDRESS	STREET	CITY	ZIP

STURBRIDGE SUB.			
SUBDIVISION	27-25	NAME	TRACT
	VOL-Pg		STREET
52		STURBRIDGE DR.	LOT
SUBLOT NO.		STREET	VOL-Pg
			PERM. PARCEL NO.

LEGEND

SANITARY MANHOLE ----- ●
 STORM MANHOLE ----- ■
 INLET OR CATCH BASIN ----- □
 HYDRANT ----- ◇
 EXISTING CONTOURS -----
 PROPOSED CONTOURS -----

EXIST. ELEV. = 100.0 PROP. ELEV. = 100.0
 AS BUILT ELEVATION
 INDICATES DIRECTION OF SURFACE DRAINAGE

REMARKS

ALL BOUNDARY DATA SHOWN WAS OBTAINED FROM (DEEDS, RECORDED
SUBDIVISION PLAT OR OTHER PUBLIC RECORDS)

LOCATIONS AS SHOWN OF ADJACENT WELLS AND SEPTIC TANKS OBTAINED FROM
LAKE COUNTY HEALTH DEPARTMENT

DESIGN CERTIFICATION

THIS PLAT WAS PREPARED BY ME, AND IS CORRECT
TO THE BEST OF MY KNOWLEDGE AND BELIEF.

NAME John SURVEYOR John REGISTRATION NO. 1234

CHECK LIST

NO. OF BEDROOMS	WATER MAIN SIZE, LOCATION
DIMENSIONS	SAN. SEWER SIZE & GR. LOC.
BEARINGS	SAN. MH. CAST. ELEV. INV. ELEV.
TIE TO NEAREST STREET	SAN. CONN. SIZE, LOC. DEPTH
SUBLOT NO. PARCEL NO.	STORM SEWER SIZE & GR. LOC.
SURROUNDING OWNERS	STORM MH. CAST ELEV. INV. ELEV.
BLDG. DIMENSIONS FIN GR.	PAVT TYPE GRADE CURBS
BLDG. TIES FL'R. GRADES	GAS LINE LOC. SIZE PRESSURE
APRON TYPE WIDTH THICKNESS	SEPTIC TANK LOCATION & DUPLICATION AREA
SIDEWALK TYPE WIDTH THICKNESS	WELL LOCATION
CULVERT TYPE DIA. LENGTH	ISOLATION RADIUS FROM WELL
ROCK OUTCROPPINGS	

REVISIONS			 BABCOCK · JONES & ASSOCIATES, INC. PAINESVILLE, OHIO		
NO.	DATE	BY			
1			DRAWN BY T.R. SCALE 1" = 20' PHONE NO. 440-357-1811 CHK'D. H.J. DATE 5/12/00 DRAWING NO. 93-172-52 CREW GAT K.J. APP'D H.J.		
2					
3					
4					
5					

"AS BUILT" CERTIFICATION

I, HEREBY CERTIFY THAT THE CIRCLED GRADES ARE EXISTING
FINISH GRADES CHECKED IN THE FIELD ON _____, 20____
AND ARE CORRECT TO THE BEST OF MY KNOWLEDGE AND BELIEF.

REGISTERED SURVEYOR

REG. NO.

BM-SANITARY MH.
RIM=818.70

**Grading Plan Approved
as shown and/or noted
THOMAS P. GILLES, P.E.
Lake County Engineer**

By TAM Date 5/18/2000
Lower FG and Suite as shown

