


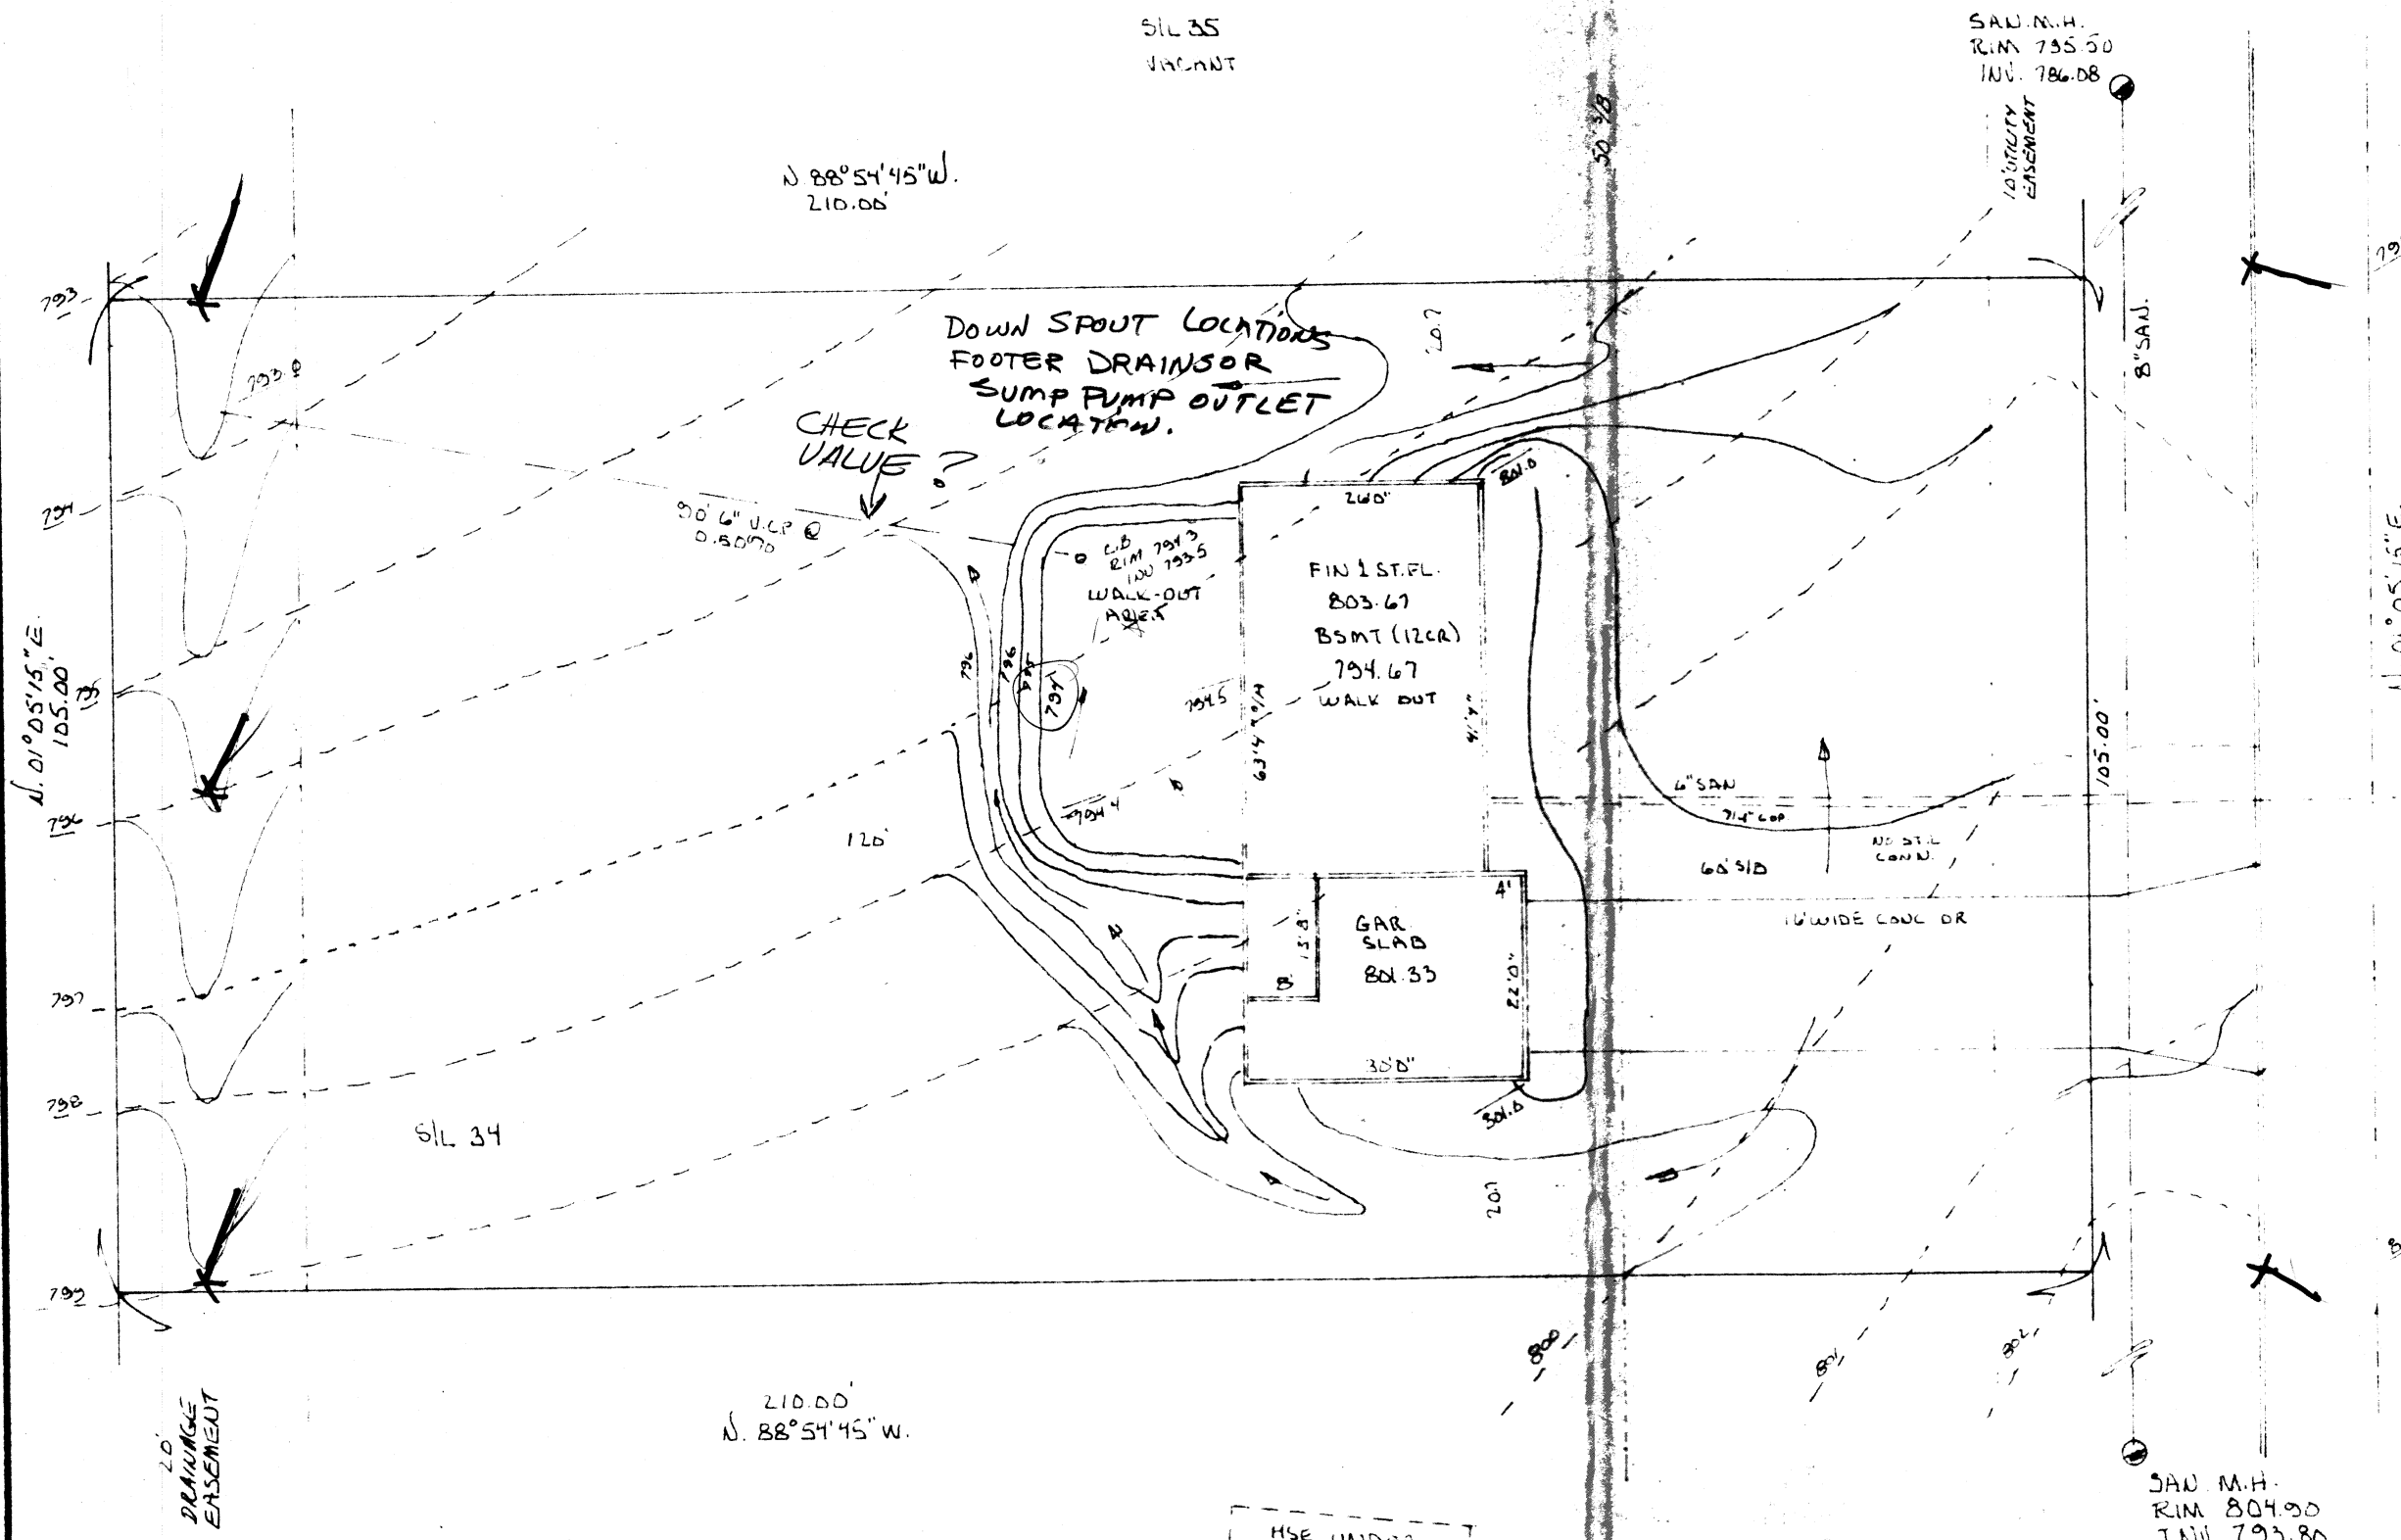

ZONING PERMIT #5675
 ISSUED 11-17-87
 SUBJECT TO APPROVAL BY:
 Lake County Sanitary Eng. ☐
 Lake County Eng. Dept. ☒
 Lake County Planning Comm. ☐
 Lake County Bldg. Dept. ☒
 Teno J. Marano

SITE PLAN FOR: IDEAL AMERICAN HOMES INC.		
SCALE: 1"=20'	APPROVED BY	DRAWN BY J.C.D.
DATE: NOV 87		
BEING SUBLOT 34 IN THE WYNDTREE SUBDIVISION		
TOWNSHIP OF CONCORD ~ COUNTY OF LAKE ~ STATE OF OHIO		
JOB # 87-631	DRAWING NUMBER 87-631	