

SITE PLAN

10000 Township, Lake County, Ohio

for: LAH HOMES
CLIENT 7221 Sutherland Dr, Chicago
ADDRESS CHICAGO
CITY ILLINOIS
STATE ILLINOIS
ZIP 60640

Sub 38 NAME Sutherland Dr
SUBDIVISION 38 VOL. 124 PAGE 12
SUBLOT NO. 12 PERM. PARCEL NO. 12 STREET 12

LEGEND	TRACT
SANITARY MANHOLE	LOT
STORM MANHOLE	VOLUME
INLET OR CATCH BASIN	PAGE
HYDRANT	STREET
EXISTING CONTOURS	
PROPOSED CONTOURS	
EXIST. ELEV. 100.0	
PROP. ELEV. 100.0	

REMARKS
ALL BOUNDARY DATA SHOWN WAS OBTAINED FROM IDEEDS, RECORDED
SUBDIVISION PLAT OR OTHER PUBLIC RECORDS
LOCATIONS AS SHOWN OF ADJACENT WELLS AND SEPTIC TANKS OBTAINED FROM
LAKE COUNTY HEALTH DEPARTMENT

DESIGN CERTIFICATION
THIS PLAT WAS PREPARED BY ME, AND IS CORRECT
TO THE BEST OF MY KNOWLEDGE AND BELIEF
NAME THOMAS P. GILLES, P.E.
SURVEYOR REGISTRATION NO. 5-6343

CHECK LIST	WATER MAIN SIZE, LOCATION
NO. OF BEDROOMS	SAN. SEWER SIZE % GR. LOC.
DIMENSIONS	SAN. MH. CAST. ELEV. INV. ELEV.
BEARINGS	SAN. CONN. SIZE, LOC. DEPTH
TIE TO NEAREST STREET	STORM SEWER SIZE % GR. LOC.
SUBLOT NO. PARCEL NO.	STORM MH. CAST. ELEV. INV. ELEV.
SURROUNDING OWNERS	PAV'T TYPE GRADE CURBS
BLOOD DIMENSIONS FIN. GR.	SEPTIC TANK LOCATION & DUPLICATION AREA
ADJACENT TYPE WIDTH THICKNESS	WELL LOCATION
CULVERT TYPE DIA. LENGTH	ISOLATION RADIUS FROM WELL
ROCK OUTCROPPINGS	

REVISIONS	PLAN PREPARED BY:
NO. DATE BY	BABCOCK • JONES & ASSOCIATES, INC.
1	PAINESVILLE, OHIO
2	
3	
4	
5	

"AS BUILT" CERTIFICATION



I, HEREBY CERTIFY THAT THE CIRCLED GRADES ARE EXISTING
FINISH GRADES CHECKED IN THE FIELD ON 19
AND ARE CORRECT TO THE BEST OF MY KNOWLEDGE AND BELIEF.

REGISTERED SURVEYOR REG. NO. 5740

THOMAS P. GILLES, P.E.
7221 Sutherland Dr
Chicago, IL 60640

ZONING PERMIT #5740
3-30-88

Lake County Health Department
Lake County Engineering
Tow 8. Marcus

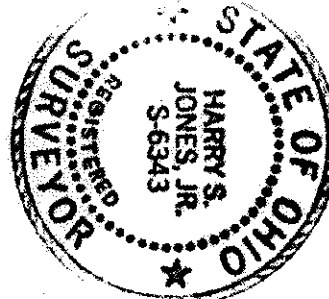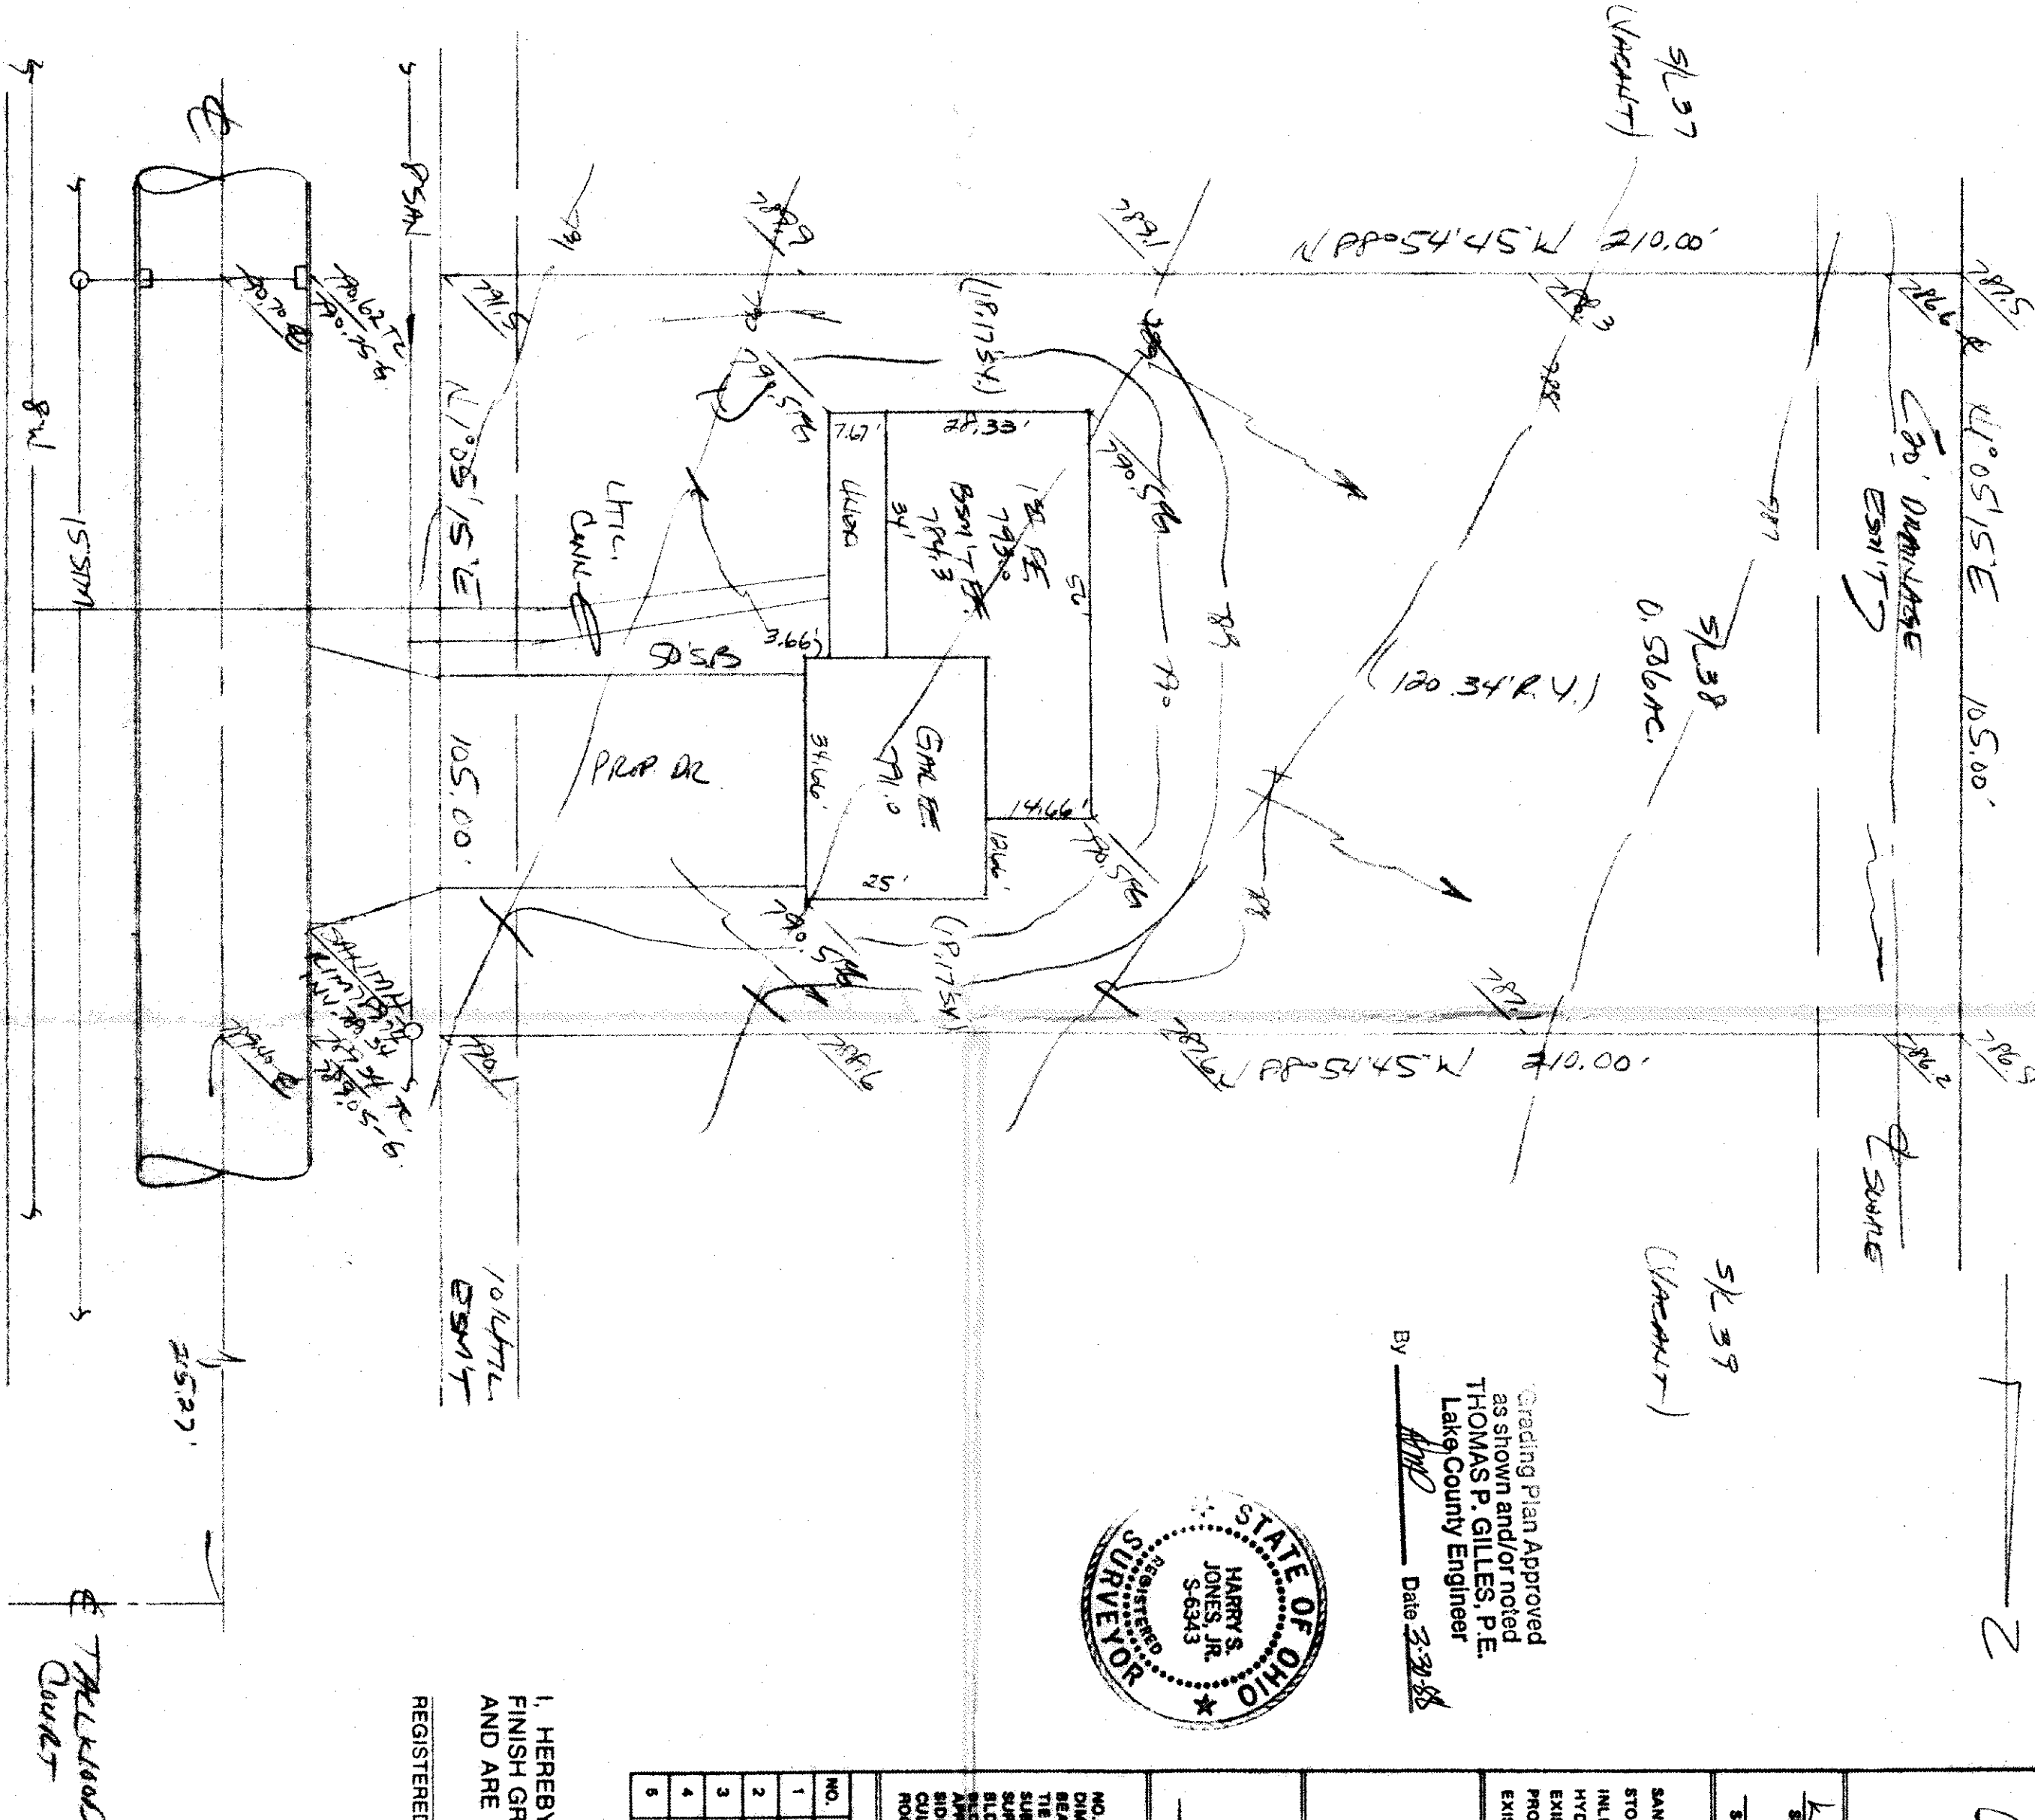

Grading Plan Approved
as shown and/or noted
THOMAS P. GILLES, P.E.
Lake County Engineer
By THP Date 3-30-88