


9-20-88

[illegible]

5000

Teno I. Martinez

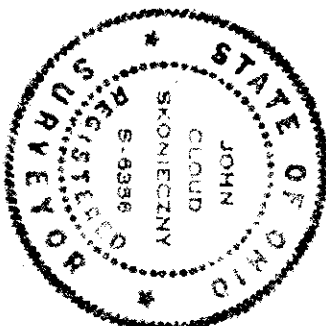

10 I CERTIFY THAT THIS PLAN
11 WAS PREPARED BY ME AND
12 IS CORRECT TO THE BEST OF
13 MY KNOWLEDGE AND BELIEF.

John C. Spencer
REG. SURVEYOR #00000

JOHN C. SKONIECZNY
7739 VIEWMOUNT DR.
PAINESVILLE, OHIO 44077
PH. 352-7742

Grading Plan Approved
as shown and/or noted
THOMAS P. GILLES, P.E.
Lake County Engineer

By *Thomas P. Gilles* 9/20/14

**SITE PLAN FOR:
IDEAL AMERICAN HOMES INC.**

SCALE: 1" = 30'	APPROVED BY
-----------------	-------------

DATE: **Aug 88**

BEING SUBLT 29 IN THE WYNDREE SUBDIVISION VOL. 3-8-1
TOWNSHIP DECAUCARD COUNTY OF LAKE STATE OF OHIO

1

DRAWING NUMBER

