

Abbreviated Site Plan - Erosion and Sediment Control Notes (Individual Homesites) (5-13-05)

Ingress-Egress

A stone access drive complete with under lying geo-textile fabric (20 feet wide and 50 feet long) for ingress and egress at the site shall be installed. This drive shall be the only entrance and exit to the site.

Silt Fence

All silt fence shall be installed prior to any earthwork activities at the site in the locations shown on the site plan as well as along the front of any lot that slopes towards the street.

Temporary Seeding

Disturbed areas of the site that are to remain idle for more than Twenty-one (21) days shall be properly seeded and straw mulched within seven (7) days of completion of initial grading. Temporary seeding and mulching of a thirty (30) foot strip of the entire front of the lot shall be maintained on the site once initial grading is complete.

Stabilization of critical areas within fifty (50) feet of any stream or wetland shall be complete within two (2) days of the disturbance if the site is to remain inactive for longer than fourteen (14) days.

Mulching

Straw-mulch shall be applied at a rate of 1 bale per every ten (10) feet of curb, at a width of thirty (30) feet of the entire length of the lot. Wood chips may also be used but must be spread at a minimum depth of four inches over the thirty-foot width and must be accompanied by a properly installed silt fence.


Maintenance

Erosion and sediment controls shall be inspected every seven (7) days or within 24 hours of a 0.5" or greater rainfall event. Necessary repairs shall be made at this time.

Note:



All erosion and sediment control specifications, applications, and timetables are based of the descriptions and standards of The Ohio Department of Natural Resources "Rainwater and Land Development Manual" and can be found in the Lake County Erosion and Sediment Control Rules as adopted December 21, 1999.

The specified erosion and sediment control standards are general guidelines and shall not limit the right of the county to impose, at any time, additional, more stringent requirements. Nor shall the standards limit the right of the county to

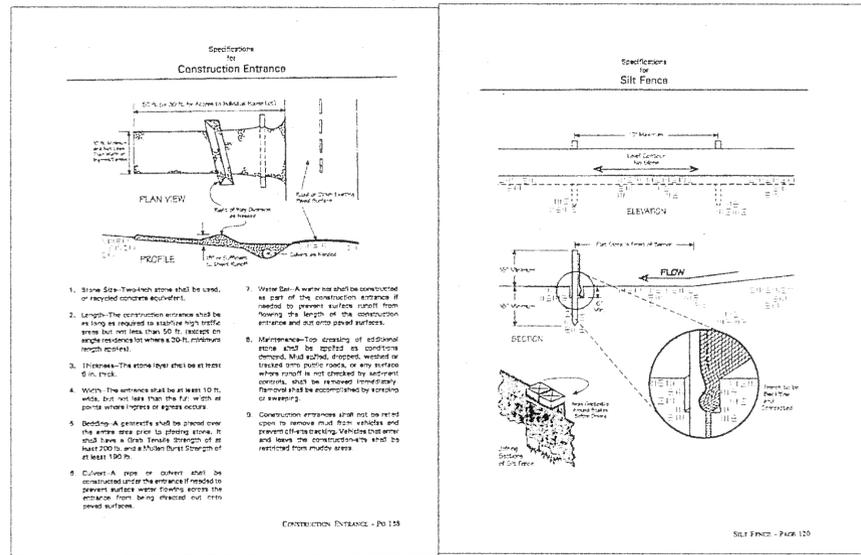

I, THE UNDERSIGNED, HEREBY CERTIFY THAT THIS TOPOGRAPHY, INDICATED BY 6", 1", OR 2" CONTOURS, AND ELEVATIONS SHOWN HEREON, REPRESENT AN ACTUAL FIELD SURVEY MADE BY ME ON THE 26th DAY OF Feb. 2005 AND THAT THE ELEVATIONS WERE TAKEN AT APPROPRIATE INTERVALS AND THAT AS OF THAT DATE THEY EXISTED AS INDICATED HEREON.

James R. Pegoraro Jr.
James R. Pegoraro Jr. PS 8150

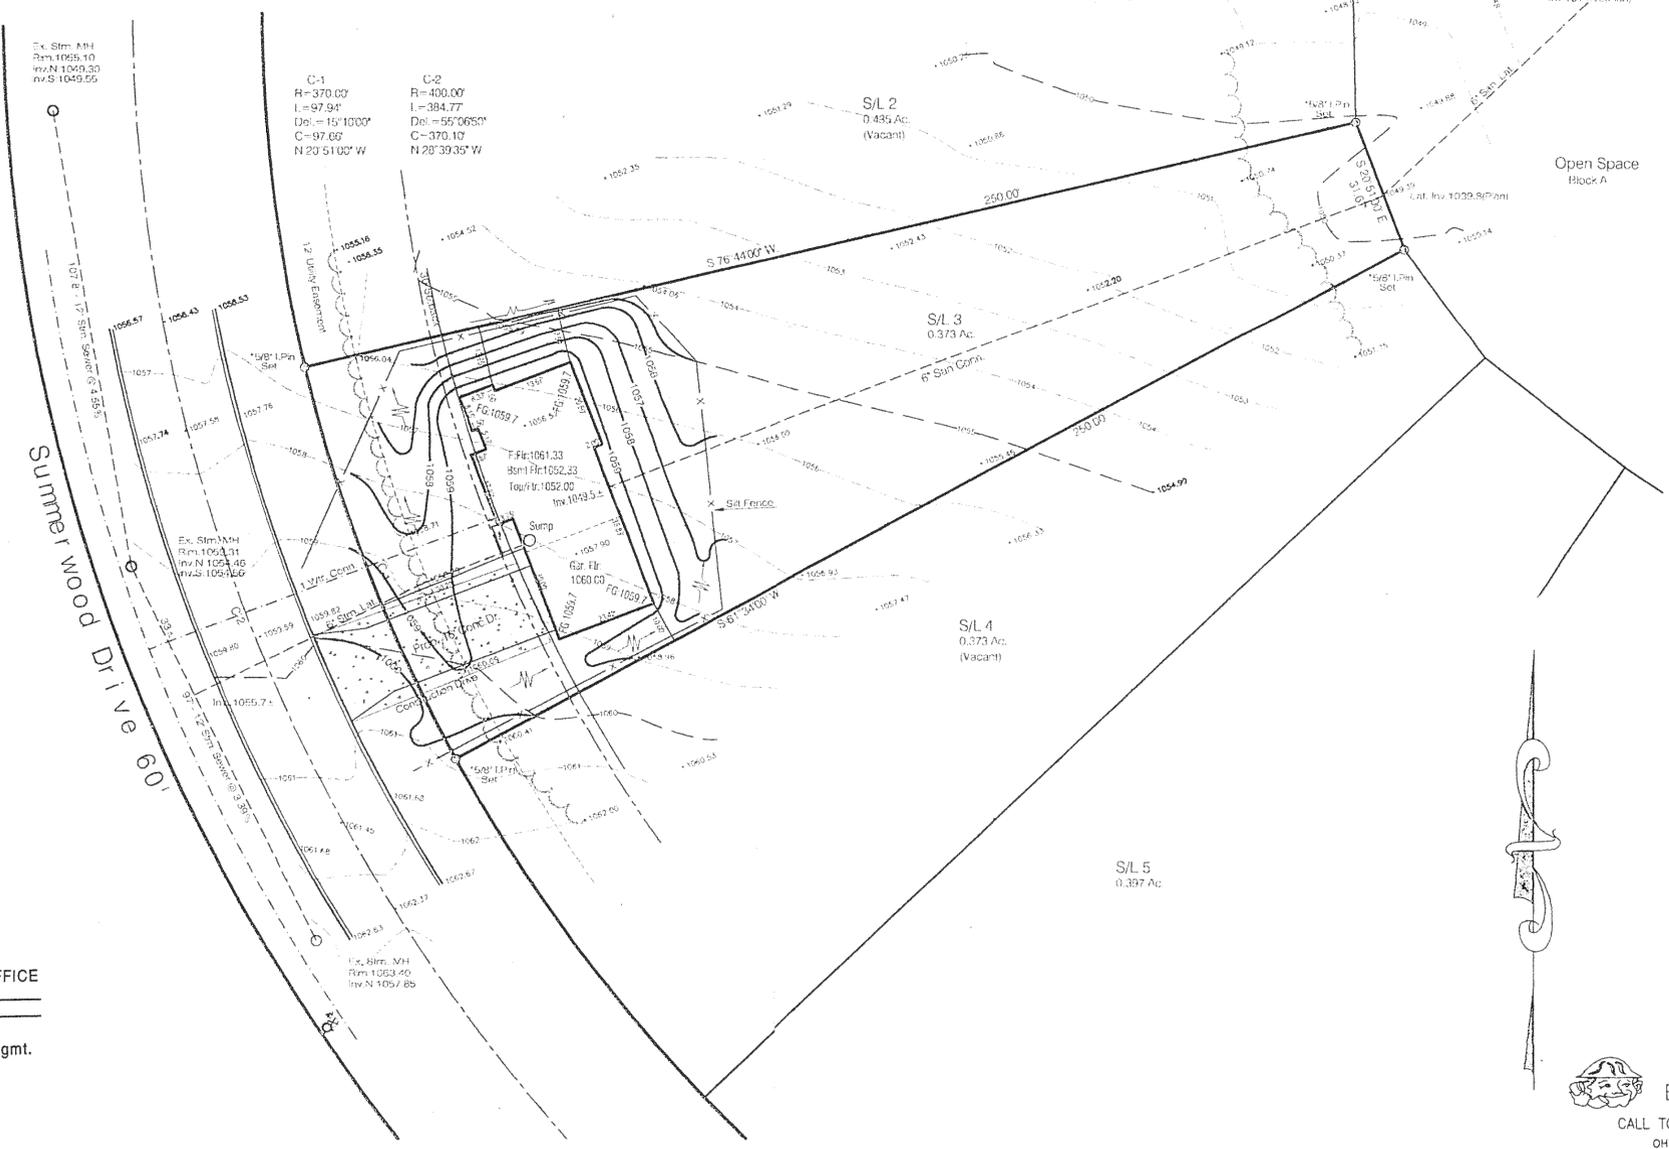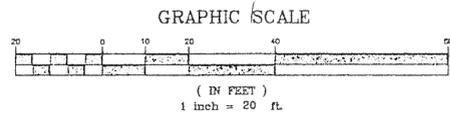

SITE PLAN

for: Vintage Homes CLIENT

7395 Ravenna Road STREET Concord CITY

3 Summerwood Pht 1 48 30
SUBLOT No. SUBDIVISION NAME VOL PAGE

4 1 Concord TOWNSHIP OHIO
LOT TRACT TOWNSHIP

LAND DESIGN consultants
w.w.l.d.cinc.o

ENGINEERS PLANNERS SURVEYORS

8565 East Avenue Mentor, Ohio 44050 1471 Lear Industrial Park, Avon, Ohio 44011
TEL: (440) 255-8463 FAX: (440) 951-LANDTEL: (440) 937-5601 (440) 937-5602
(440) 354-6938 FAX: (440) 255-9575 FAX: (440) 937-5603

DESIGN CERTIFICATION

THIS PLAT WAS PREPARED BY ME, AND IS CORRECT TO THE BEST OF MY KNOWLEDGE AND BELIEF.

James R. Pegoraro Jr. 7-12-05
NAME

CHECK LIST

LOT DIMENSIONS & BEARINGS TO NEAREST STREET
SUBLOT NO. (PARCELS No.)
SURROUNDING OWNERS
BOUNDING DIMENSIONS
SETBACK, STEWARD, REARWARD
DRAINAGE DITCHES
SEWER TYPE, WIDTH, DEPTH
SEWER MAIN SIZE, LOCATION
SAN. SEWER SIZE, GRADE, LOC.
SAN. IN. CAST. ELEV., INV. ELEV.
STORM SEWER SIZE, GRADE, LOC.
STORM IN. CAST. ELEV., INV. ELEV.
SAV. TYPE, GRADE, CHISEL
GAS LINE LOC., SIZE
SEPTIC TIGHTEN & DUPLICATION
WELL LOCATION & ISOLATION RADIUS

STATE OF OHIO
REGISTERED PROFESSIONAL SURVEYOR
JAMES R. PEGORARO, JR.
S-8150

"AS BUILT" CERTIFICATION

I HEREBY CERTIFY THAT THE CIRCLED INFORMATION IS EXISTING AS OBTAINED ON THE SITE 20/05 AND IS CORRECT TO THE BEST OF MY KNOWLEDGE AND BELIEF.

NAME

LEGEND	DRAWN BY	SCALE
	JRP	1"=20'
STORM MANHOLE SANITARY MANHOLE EXISTING CONTIGUOUS PROPOSED CONTIGUOUS	CHK'D BY	DATE
	1	2/05
EXST. ELEV. 100.0 100.0 PROP. F.I.E.V.	2	Site/Grde 7/12/05
DIRECTION OF SURFACE DRAINAGE	CLIENT	DATE

BENCHMARK:

TBM: Top/ Hydrant Opposite S/L 4
1066.33

Rim Storm Manhole Opposite S/L 3
1059.31

Specifications for Temporary Seeding

Seeding Date	Species	Sp./1,000 ft ²	Per Ac.
March 1 to August 15	Grass	3	4 bushel
	Timothy	1	40 lb.
	Annual Ryegrass	1	40 lb.
	Perennial Ryegrass	1	40 lb.
August 15 to November 1	Timothy	3	2 bushel
	Timothy	1	40 lb.
	Wheat	3	2 bushel
	Annual Ryegrass	1	40 lb.
November 1 to Spring Seeding	Timothy	1	40 lb.
	Timothy	1	40 lb.
	Annual Ryegrass	1	40 lb.
	Annual Ryegrass	1	40 lb.

Note: One acre seed amount may be substituted.

CONCORD TOWNSHIP ZONING OFFICE
Zoning Permit # 0205-12323
Date Issued 7/26/05
Subject to Approval By:
 Lake Co. Engineer/Storm Water Mgmt.
 Lake Co. Utilities Dept.
 Lake Co. Soil + Water District
 Lake Co. Health District
 Lake Co. Building Dept.

2 WORKING DAYS BEFORE YOU DIG

CALL TOLL FREE 800-362-2764
OHIO UTILITIES PROTECTION SERVICE

LDCE DWG. NAME
Vinth1-0502

Stormwater Management Plan
Approved as shown and/or noted
JAMES R. PEGORARO, JR., P.E.
County Drainage Engineer
By: *James R. Pegoraro Jr.* Date: 7/27/05