

CURVE	RADIUS	ARC	DELTA	TANGENT	CHORD	CHORD BR.
C4	530.00'	85.18'	97.230°	42.68'	85.08'	S84.32°41'W

DESIGN CERTIFICATION
THIS PLAN WAS PREPARED BY ME, AND IS CORRECT TO THE BEST OF MY KNOWLEDGE.
JOSEPH GUTOSKEY P.S. #7567
DATE 12/3/07

"AS-BUILT" CERTIFICATION
I HEREBY CERTIFY THAT THE CIRCLED INFORMATION IS EXISTING AS OBTAINED ON THE SITE 20 AND IS CORRECT TO THE BEST OF MY KNOWLEDGE AND BELIEF.
JOSEPH GUTOSKEY P.S. #7567

LEGEND	SCALE	DATE
STORM MANHOLE	GA	10/2007
EXISTING CONTOURS	JG	10/24/07 GAR, ELEV, FOUND.
PROPOSED CONTOURS	100	11/7/07 FOUND.
100.0 PROP. ELEV.	REV	11/20/07 PER COUNTY REV.
DIRECTION OF SURFACE DRAINAGE	REV	11/28/07 GRADING

12/3/07 GRADING

NOTE: SEEDING OR MULCHING SHALL BE COMPLETED WITHIN 30 DAYS OF COMPLETION OF HOUSE.
LIMIT OF DISTURBANCE: ALL OF LOT.

BENCHMARK: TOP NUT HYDRANT
ELEV. 1036.71

2 WORKING DAYS BEFORE YOU DIG
CALL TOLL FREE 800-362-2764
OHIO UTILITIES PROTECTION SERVICE
CONTRACTOR SHALL VERIFY ELEVATIONS OF LATERAL INVERTS IN THE FIELD AT THE TIME OF FOUNDATION EXCAVATION.

* DRIVE APRON SHALL BE 6" THICK CONCRETE.
APPROVED AS SHOWN BY ENGINEER
JAMES R. GILLIS, P.E.
By Date 12/10/07
ORIGINALY APPROVED 11/21/07





CONCORD TOWNSHIP ZONING OFFICE
Zoning Permit # 1102-13354
Date Issued 12/6/07
Subject to Approval By:
Lakota Co. Engineer/Storm Water Mgmt.
Lakota Co. Utilities Dept.
Lakota Co. Soil + Water District
Lakota Co. Health District
Lakota Co. Building Dept.

CONCURRED
11/28/07 GRADING

LOT LIST
LOT NO. (PARCEL NO.)
TO NEAREST STREET
SURROUNDING OWNERS
BUILDING DIMENSIONS
SETPACK, SIDEYARD, REARYARD
FINISHED GRADES
DRIVE & APRON TYPE, WIDTH, THICKNESS
SIDEWALK TYPE, WIDTH, THICKNESS
CULVERT TYPE, DIAM., LENGTH
WATER MAIN SIZE, LOCATION
SAN. SEWER SIZE, GRADE, LOCATION
SAN. M.H. CAST, INV. ELEV.
SAN. CONN. SIZE, GRADE, LOCATION
STORM SEWER SIZE, GRADE, LOCATION
STORM M.H. CAST, INV. ELEV.
PAVT. TYPE, GRADE, CURBS
GAS LINE LOC. SIZE
SEPTIC SYSTEM & DUPICATION
WELL LOCATION & ISOLATION RADIUS

CHECK LIST
APPROVED AS SHOWN BY ENGINEER
JAMES R. GILLIS, P.E.
By Date 12/10/07
ORIGINALY APPROVED 11/21/07

CONTRACT NO. 05-2000-73

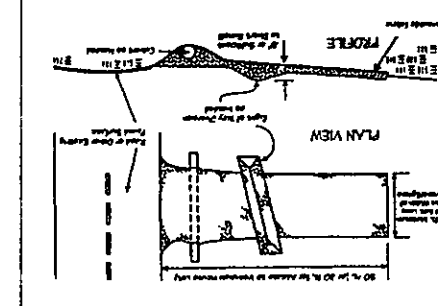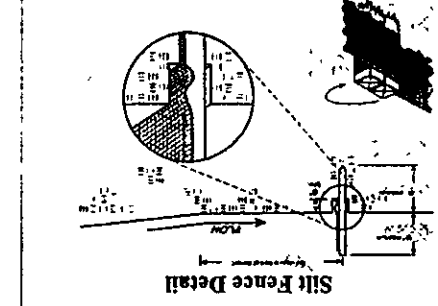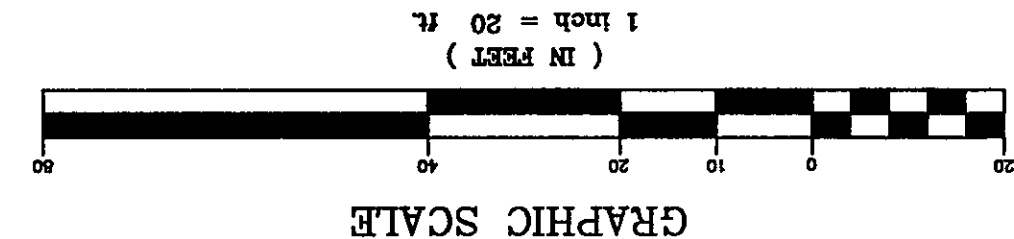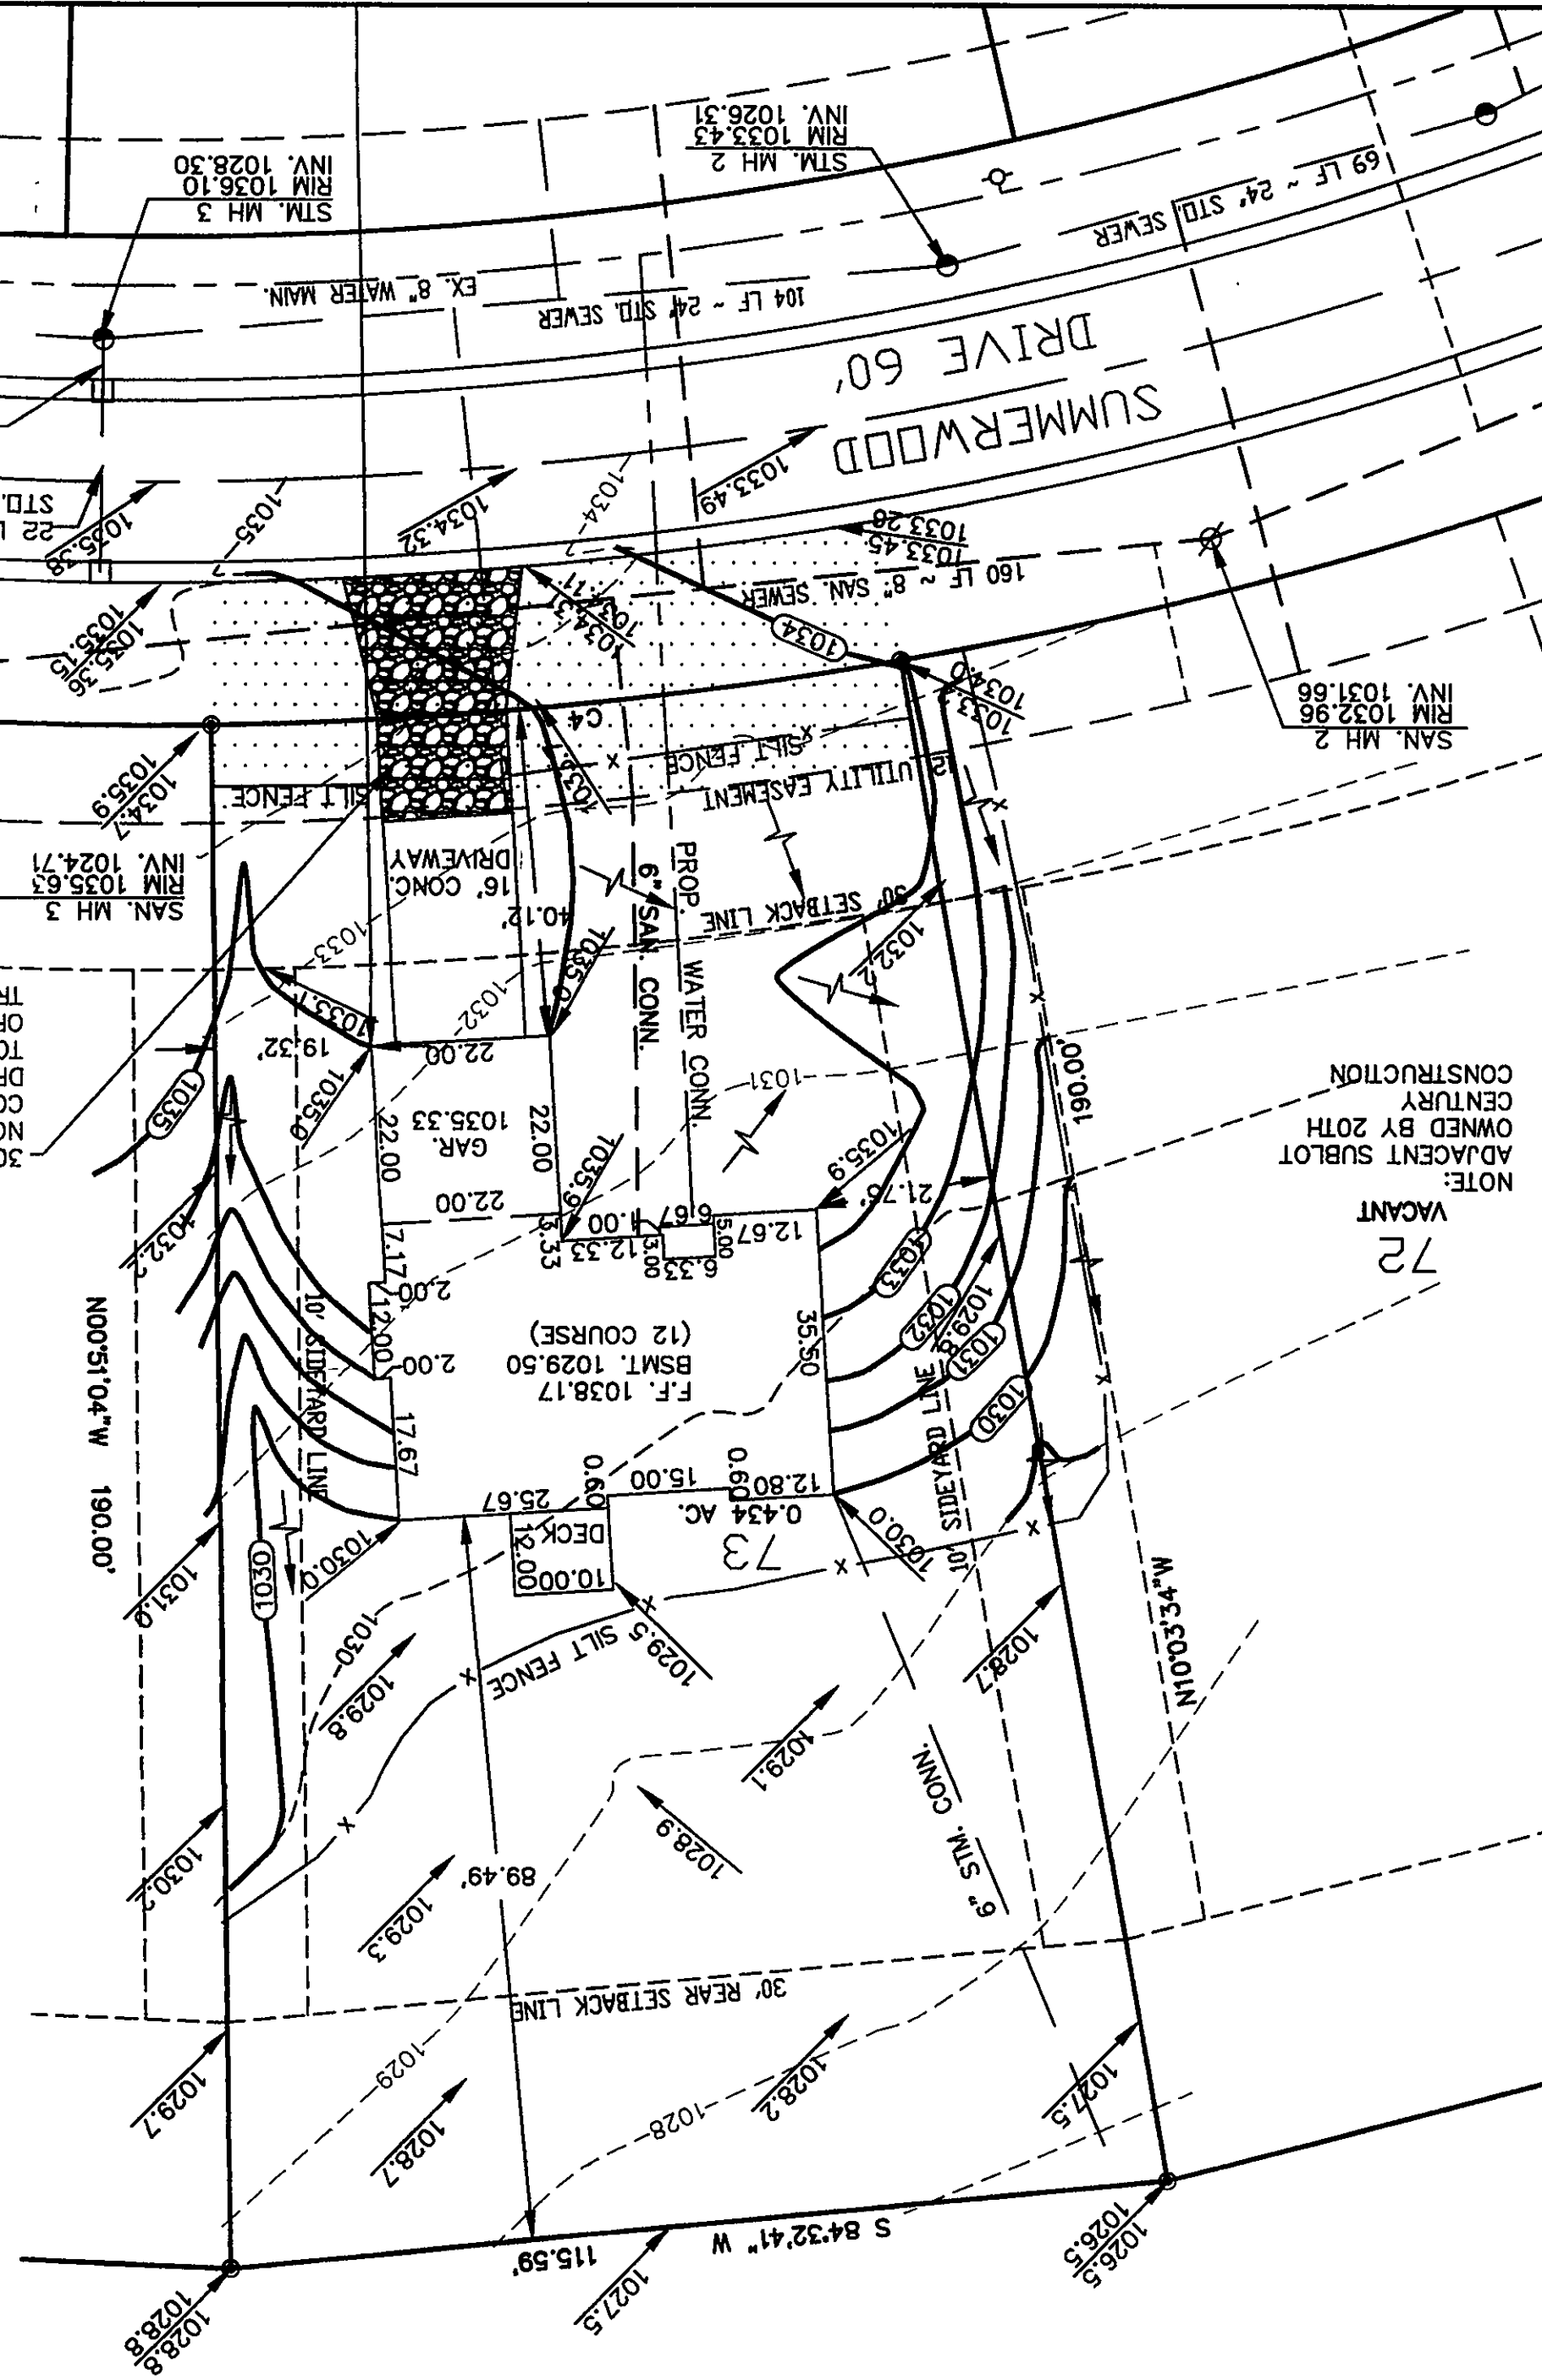

Stabilization of critical areas within fifty (50) feet of any stream or wetland shall be completed within two (2) days of the disturbance of the site is to remain inactive for longer than fourteen (14) days.
Mulching
Snow-mulch shall be applied at a rate of 1 bale per every ten (10) feet of curb, at a width of thirty (30) feet of the entire length of the lot. Flood chips may also be used but must be spread at a minimum depth of four inches over the thirty-foot width and must be accompanied by a properly installed silt fence.
Maintenance
Erosion and sediment controls shall be inspected every seven (7) days or within 24 hours of a 0.5" or greater rainfall event.
Necessary repairs shall be made at this time.