


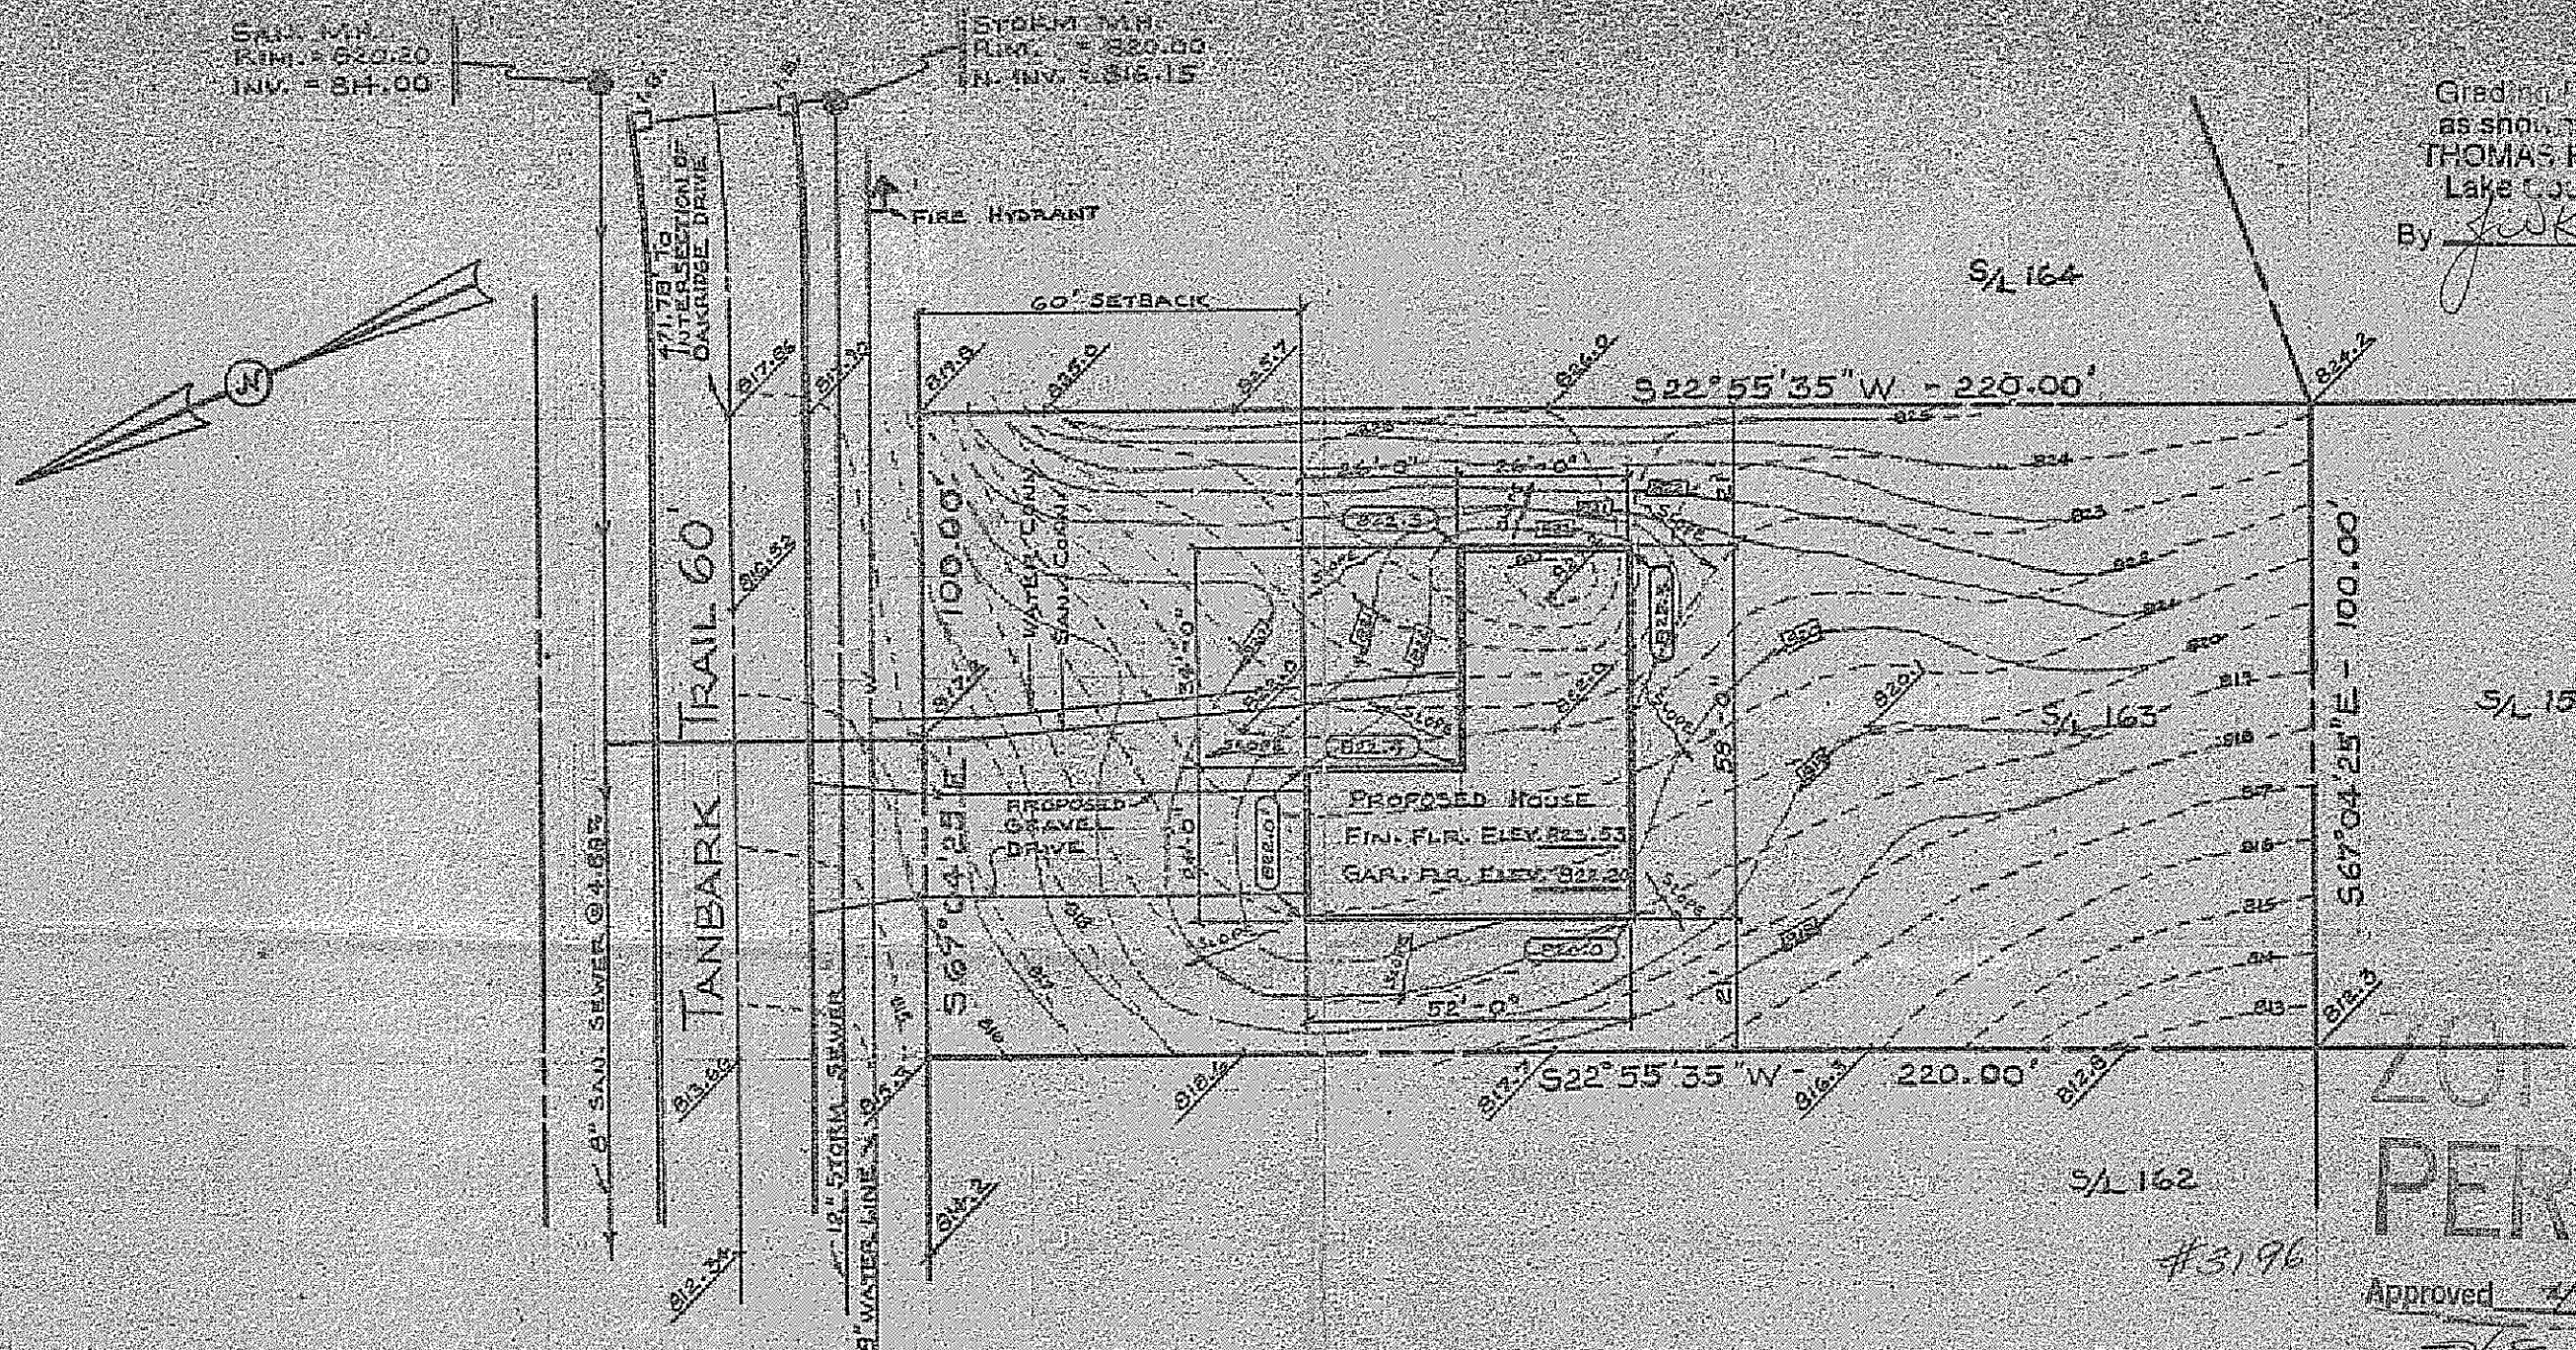

Grading to be done as shown and or note
THOMAS P. GILLES, P.
Lake County Engineer
By gwk Date 4-12-77

SITE PLAN FOR:

SHANDLE CONST.
8353 MENTOR AVENUE
MENTOR, OHIO

BEING SUBLT NUMBER 163
IN THE MORLEY HILLS ESTATES
SUBDIVISION No. 3 IN CONCORD
TOWNSHIP, LAKE COUNTY, OHIO

PREPARED BY:

WM. R. GRAY ASSOC. INC.
7457 MENTOR AVENUE
MENTOR, OHIO

SCALE: 1" = 30'
DATE: MARCH 30, 1977

CERTIFICATION:

I HEREBY CERTIFY
THAT THIS PLAN IS
CORRECT TO THE BEST
OF MY KNOWLEDGE.

BY: Wm. R. Gray
WM. R. GRAY REG. SURV. #2752

