


APPLICANT: MALCOLM E. BLATNIK
2152 ARDEN DRIVE
MENTOR, OHIO 44060

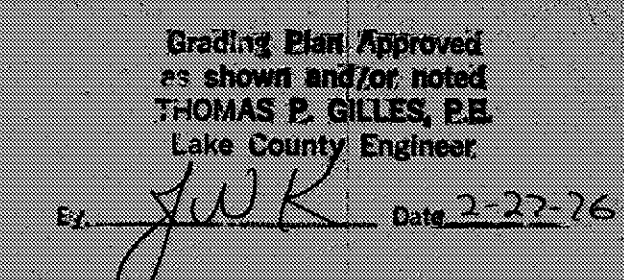

Approved 1/30/76 R. H. H. H. H.
#2974

DATE: _____

ROBERT J. ALBANI, P.E.
REGISTERED CIVIL ENGINEER AND LAND SURVEYOR