

UNGRAPHIC SURVEY AND IMPROVEMENT PLAN

LEGEND:


- I. PIN FD. OR SET
- OO EXISTING ELEV.
- OO PROPOSED ELEV.

T.B.M. TOP HYD ELY.	715.78
FIRST FLOOR	718.00
GARAGE FLOOR	716.00
BASEMENT FLOOR	710.00
TOP FOOTING	709.67


SUBLOT NO. 23
PERMANENT PARCEL NO. _____
STREET ADDRESS TANGLEWOOD TRAIL
TANGLEWOOD TRACT 2 PARCELS 1 & 2
CONCORD TOWNSHIP, LAKE COUNTY, OHIO
PREPARED FOR ANGELA DIFINI
DATE 4-2-96 SCALE 1"=40'

Note: Builder will move house
back 5' to meet 80'
building setback from ZONING PERMIT #0496-8407
center line of road
ISSUED 4/17/96
Requirement.


SUBJECT TO APPROVAL BY:
☐ Lake County Sanitary Eng.
☒ Lake County Eng. Dept.
☒ Lake County Planning Comm.
☒ Lake County Bldg. Dept.

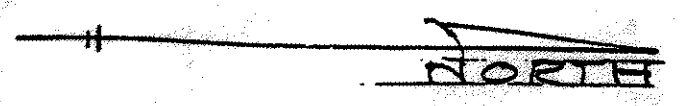

PARCEL 'B'

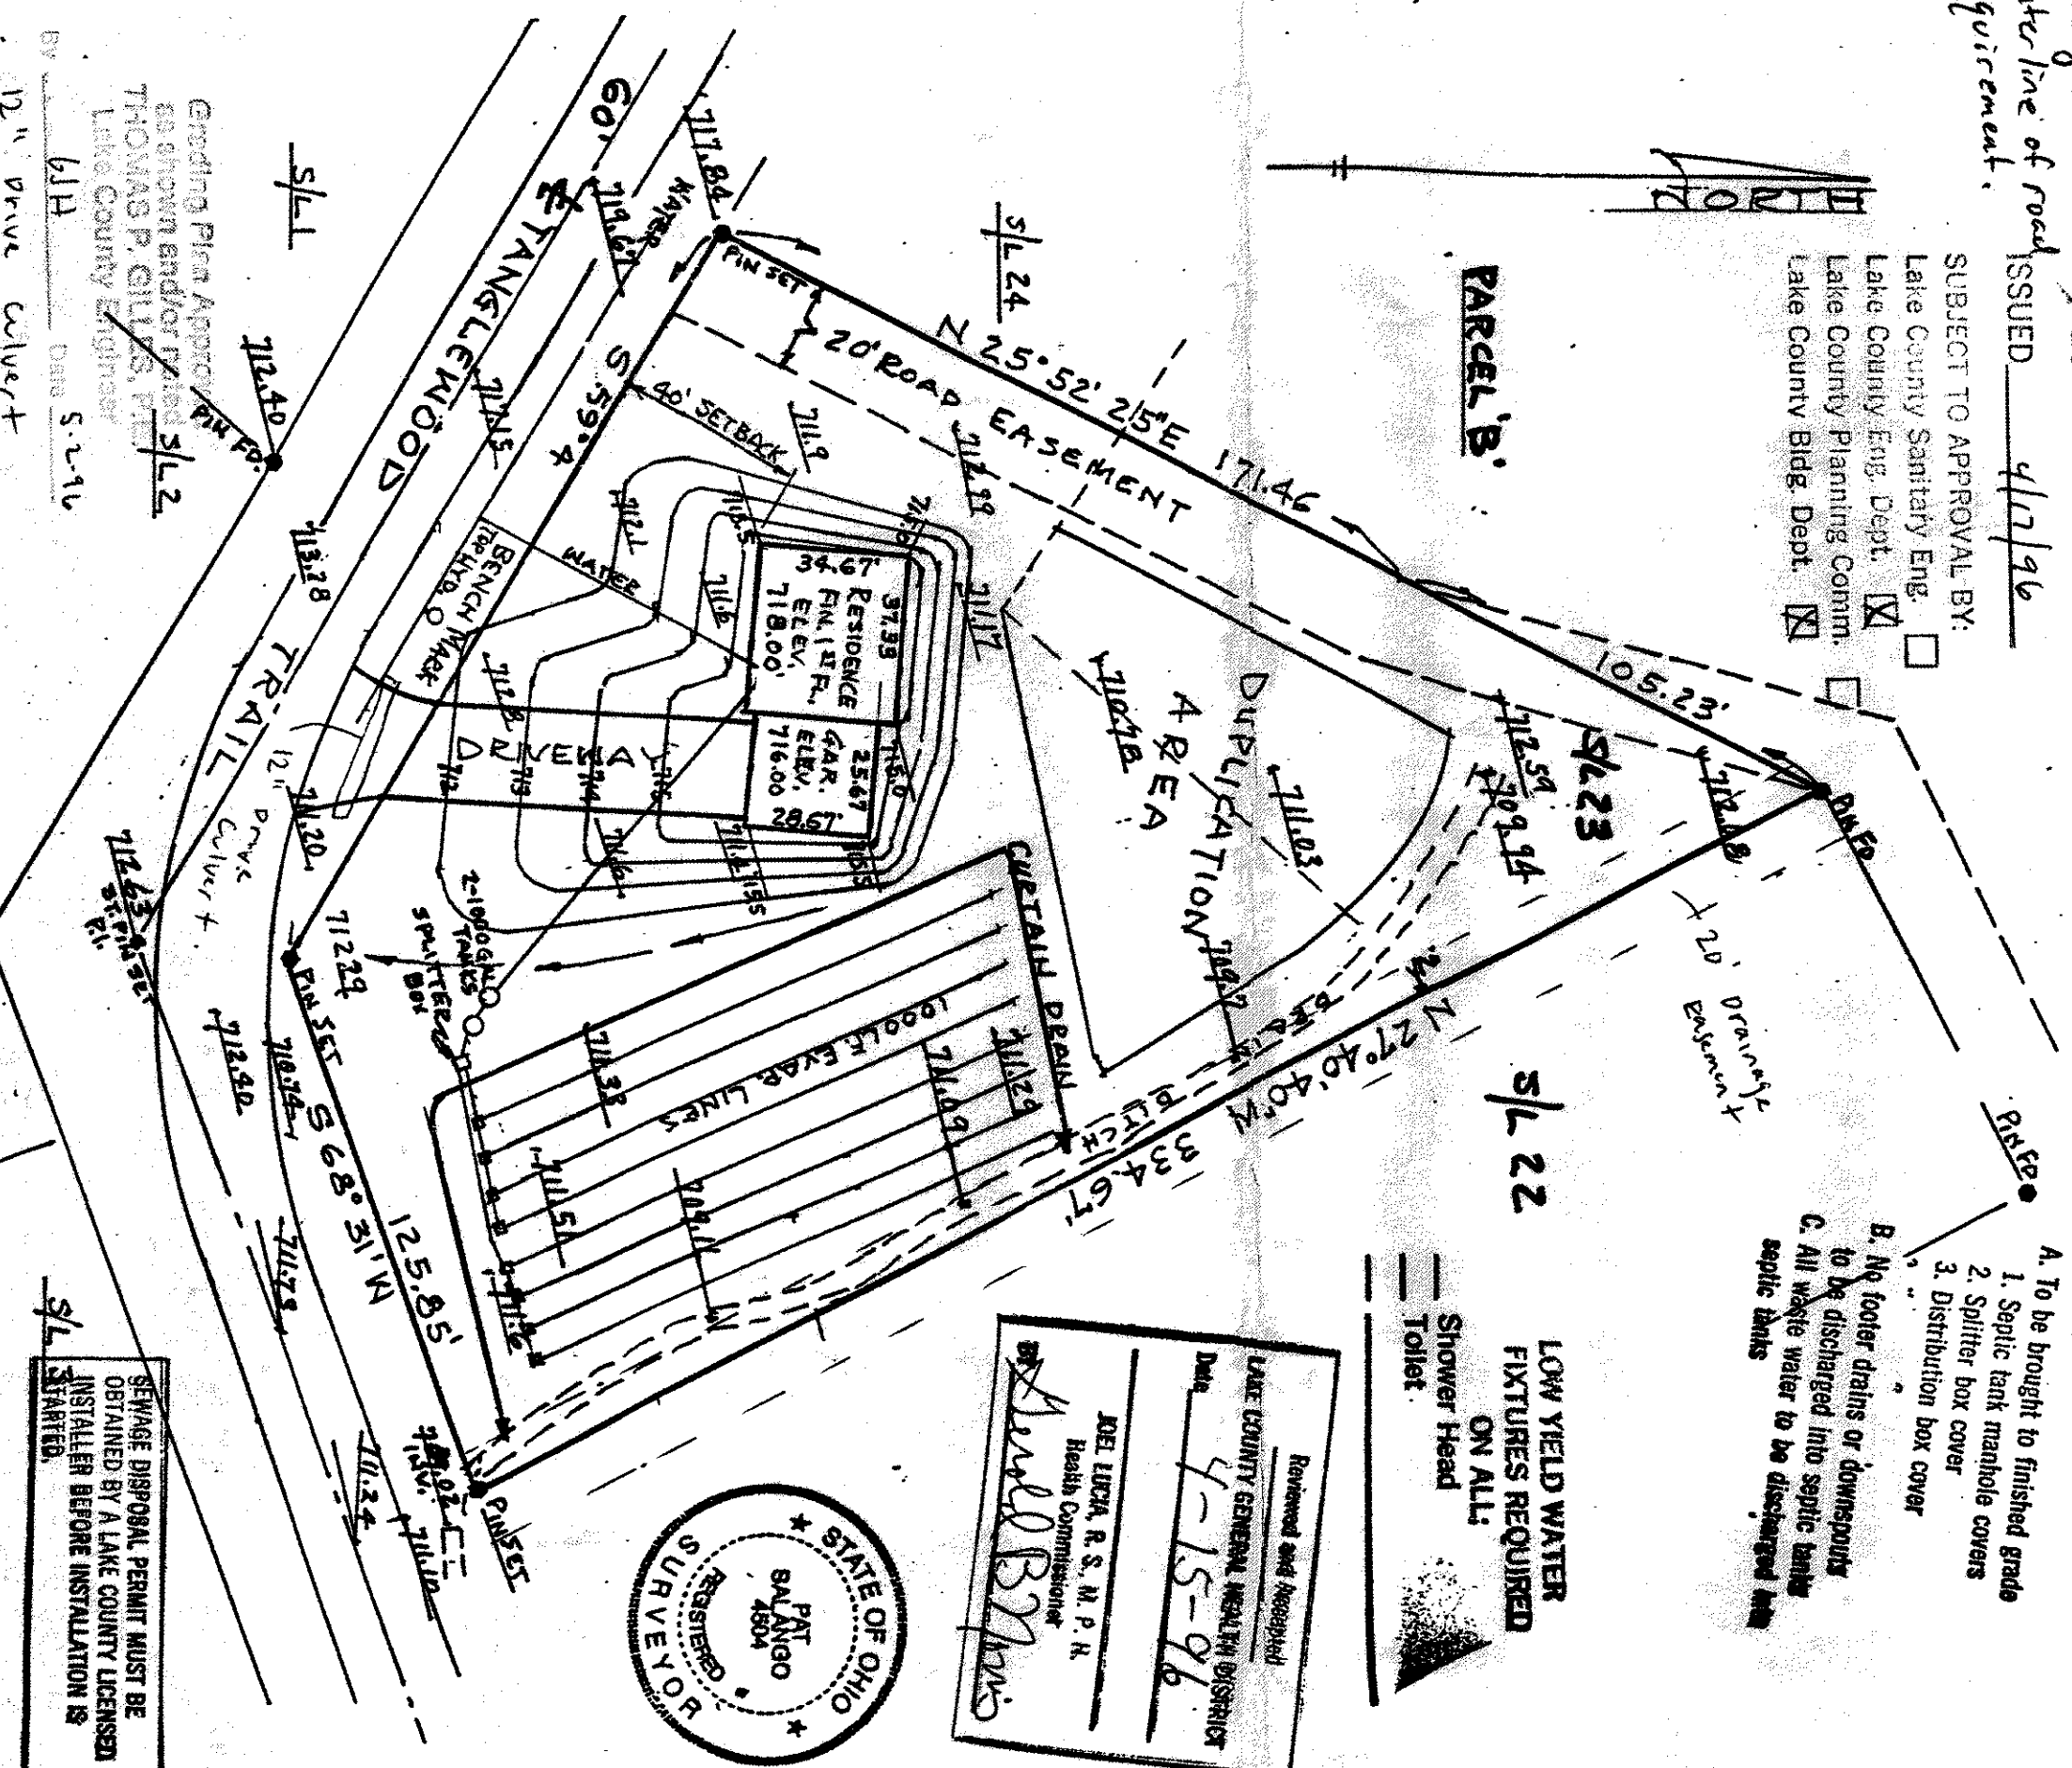

Reviewed and Accepted
LAKE COUNTY GENERAL HEALTH DISTRICT
Date 4-15-96
JULIE LUCIA, R.S., M.P.H.
Health Commissioner
by David B. Davis

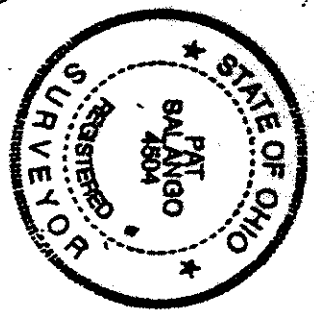

- LOW YIELD WATER
FIXTURES REQUIRED
ON ALL:
- Shower Head
 - Toilet
- A. To be brought to finished grade
1. Septic tank manhole covers
2. Splitter box cover
3. Distribution box cover
- B. No footer drains or downspouts
to be discharged into septic tanks
- C. All waste water to be discharged into
septic tanks

SEWAGE DISPOSAL PERMIT MUST BE
OBTAINED BY A LAKE COUNTY LICENSED
INSTALLER BEFORE INSTALLATION IS
STARTED.

12" Drive Culvert
Installed pipe as shown on attached Sheet
CERTIFICATION
DIMENSIONS ARE EXPRESSED IN FEET AND DECIMAL PARTS THEREOF.
MON'S ARE AT POINTS SHOWN AND ARE CERTIFIED CORRECT.
Pat Salango
REGISTERED SURVEYOR NO. 4504