
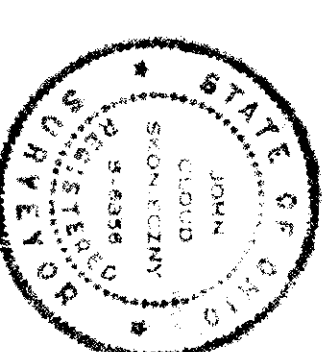
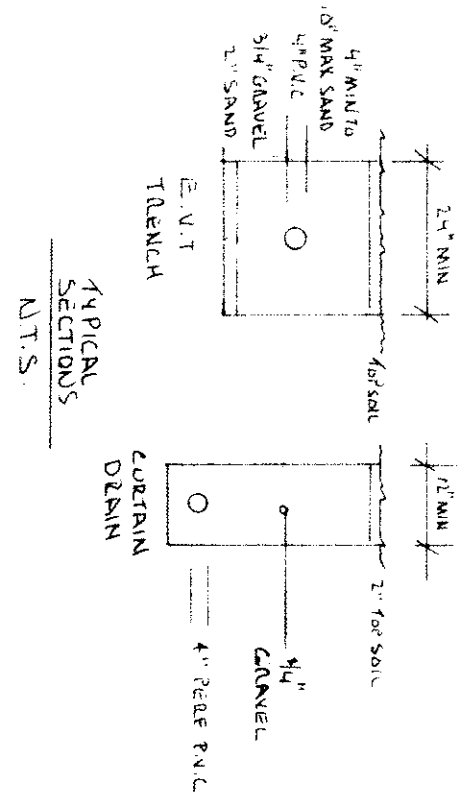


Handwritten signature


EXISTING DITCH TO BE MAINTAINED BY PROPERTY OWNERS.

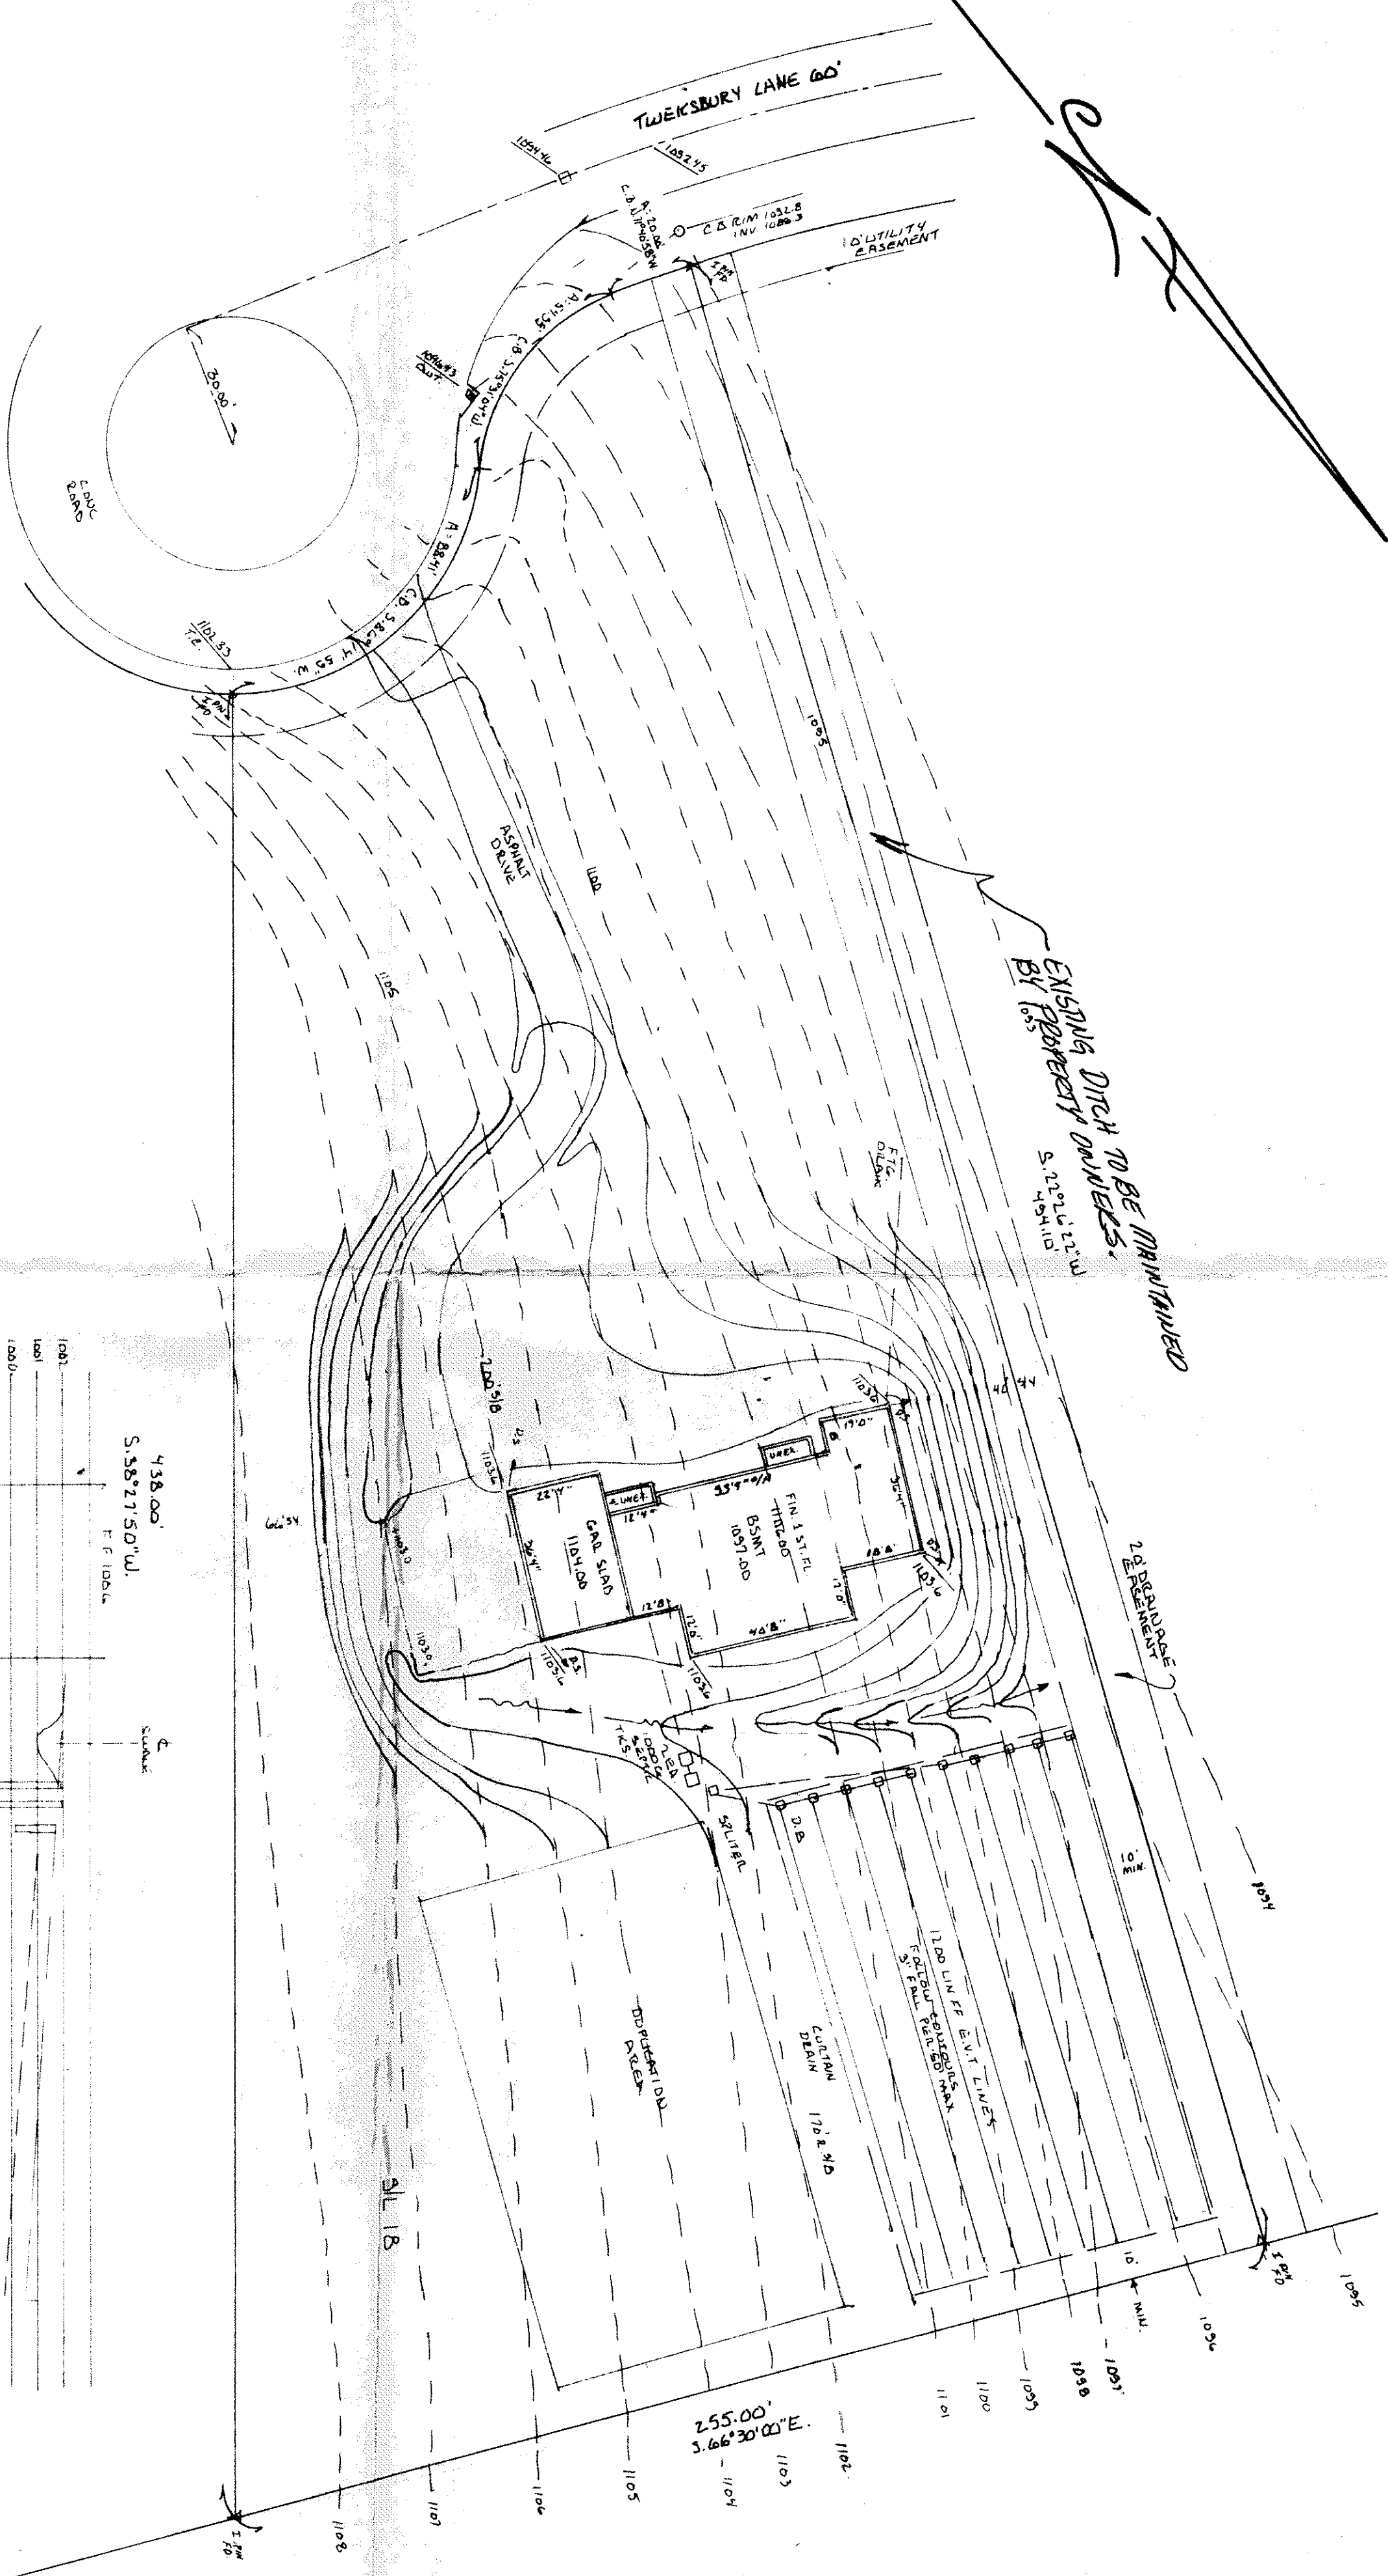

JOHN C. SKONECZNY
7739 VIEWMOUNT DR.
PAINESVILLE, OHIO 44077
PH. 352-7742

Grading Plan Approved
as shown and/or noted
by **THOMAS P. GILLES, P.E.**
Lake County Engineer
By *[Signature]* Date *8/26/88*

PROFILE
HORIZ. 1"=30'
VERT. 1"=5'

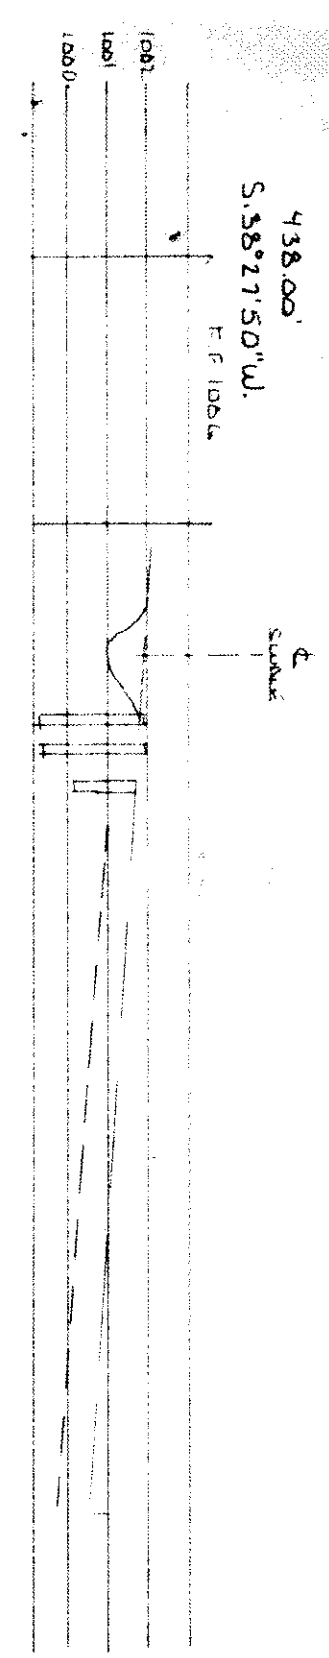

#5913
ZONING PERMIT
ISSUED **8-26-88**
SUBJECT TO APPROVAL BY:
Lake County Eng. Dept. ☒
Lake County Planning Comm. ☒
Lake County Reg. Dept. ☒
Leno H. Weaver

SITE PLAN FOR: IDEAL AMERICAN HOMES INC.		
SCALE: 1"=30'	APPROVED BY	DRAWN BY <i>jcl</i>
DATE: JULY 88		
BEING SUBMIT IN THE HARTWOOD II SUBDIVISION TOWNSHIP OF CONCORD COUNTY OF LAKE STATE OF OHIO		
DRAWING NUMBER		