

SITE PLAN

located Town of Lake County, Ohio

for: JERRY BAILING

CLIENT

OWNER

ADDRESS STREET CITY ZIP

SUBDIVISION NAME LOT VOLUME TRACT
VOL. NO. 1234567890 PAGE
SUBLOT NO. 1234567890 STREET

PERMIT NO. 1234567890

LEGEND

WATER VALVE (GAS) ---
WATER METER (GAS) ---
AS BUILT ELEVATION
HYDRAUNT ---
EXISTING CONTOURS ---
PROPOSED CONTOURS ---
EXIST. ELEV. ---
PROP. ELEV. ---
INDICATES DIRECTION OF SURFACE DRAINAGE

REMARKS

ALL BOUNDARY DATA SHOWN WAS OBTAINED FROM (DEEDS, RECORDED SUBDIVISION PLAT OR OTHER PUBLIC RECORDS)
LOCATIONS AS SHOWN OF ADJACENT WELLS AND SEPTIC TANKS OBTAINED FROM LAKE COUNTY HEALTH DEPARTMENT

DESIGN CERTIFICATION

THIS PLAN WAS PREPARED BY ME, AND IS CORRECT TO THE BEST OF MY KNOWLEDGE AND BELIEF

NAME: JERRY BAILING SURVEYOR REGISTRATION NO. 12345

CHECK LIST

NO. OF BEDROOMS
DRAININGS
THE TO NEAREST STREET
SUBLOT NO. PARCEL NO.
SURROUNDING OWNERS
BLDG. DIMENSIONS FIN. GR.
BLDG. TIES FLN. GRADERS
APPROX. TYPE WIDTH THICKNESS
SIDEWALK TYPE WIDTH THICKNESS
CULVERT TYPE DIA. LENGTH
ROCK OUTCROPPINGS
WATER MAIN SIZE, LOCATION
SAN. SEWER SIZE, GR. LOC.
SAN. WH. CAST. ELEV. INV. ELEV.
SAN. CONN. SIZE, LOC. DPTH.
STORM SEWER SIZE, GR. LOC.
STORM WH. CAST. ELEV. INV. ELEV.
PAV'T TYPE, GRADE CURVES
GAS LINE LOC. SIZE PRESSURE
SEPTIC TANK LOCATION & DUPPLICATION AREA
WELL LOCATION
ISOLATION RADIUS FROM WELL

PLAN PREPARED BY: BABCOCK • JONES & ASSOCIATES, INC. PAINESVILLE, OHIO


NO.	DATE	BY	SCALE	PHONE NO.
1	12/18/77	JTB	1" = 30'	357-1811
2				
3				
4				
5				

"AS BUILT" CERTIFICATION

I, HEREBY CERTIFY THAT THE CIRCLED FINISH GRADES CHECKED IN THE FIELD ON 1978 ARE CORRECT TO THE BEST OF MY KNOWLEDGE AND BELIEF.


REGISTERED SURVEYOR REG. NO. 12345

75177 - 12177 SAN. WH. 11.4 - 51.2
ELEV. = 797.77

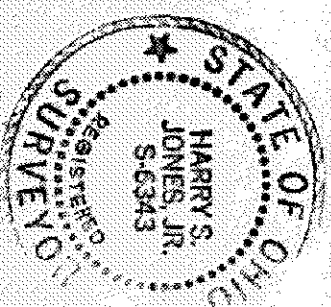

Grading Plan Approved as shown and/or noted THOMAS P. GILLES, P.E. Lake County Engineer Date 12/18/77

1/4" = 1' DETAIL DETAIL SCALE: 1" = 30' SAW CUT EXISTING PIPE TO ACCEPT 8" VIT

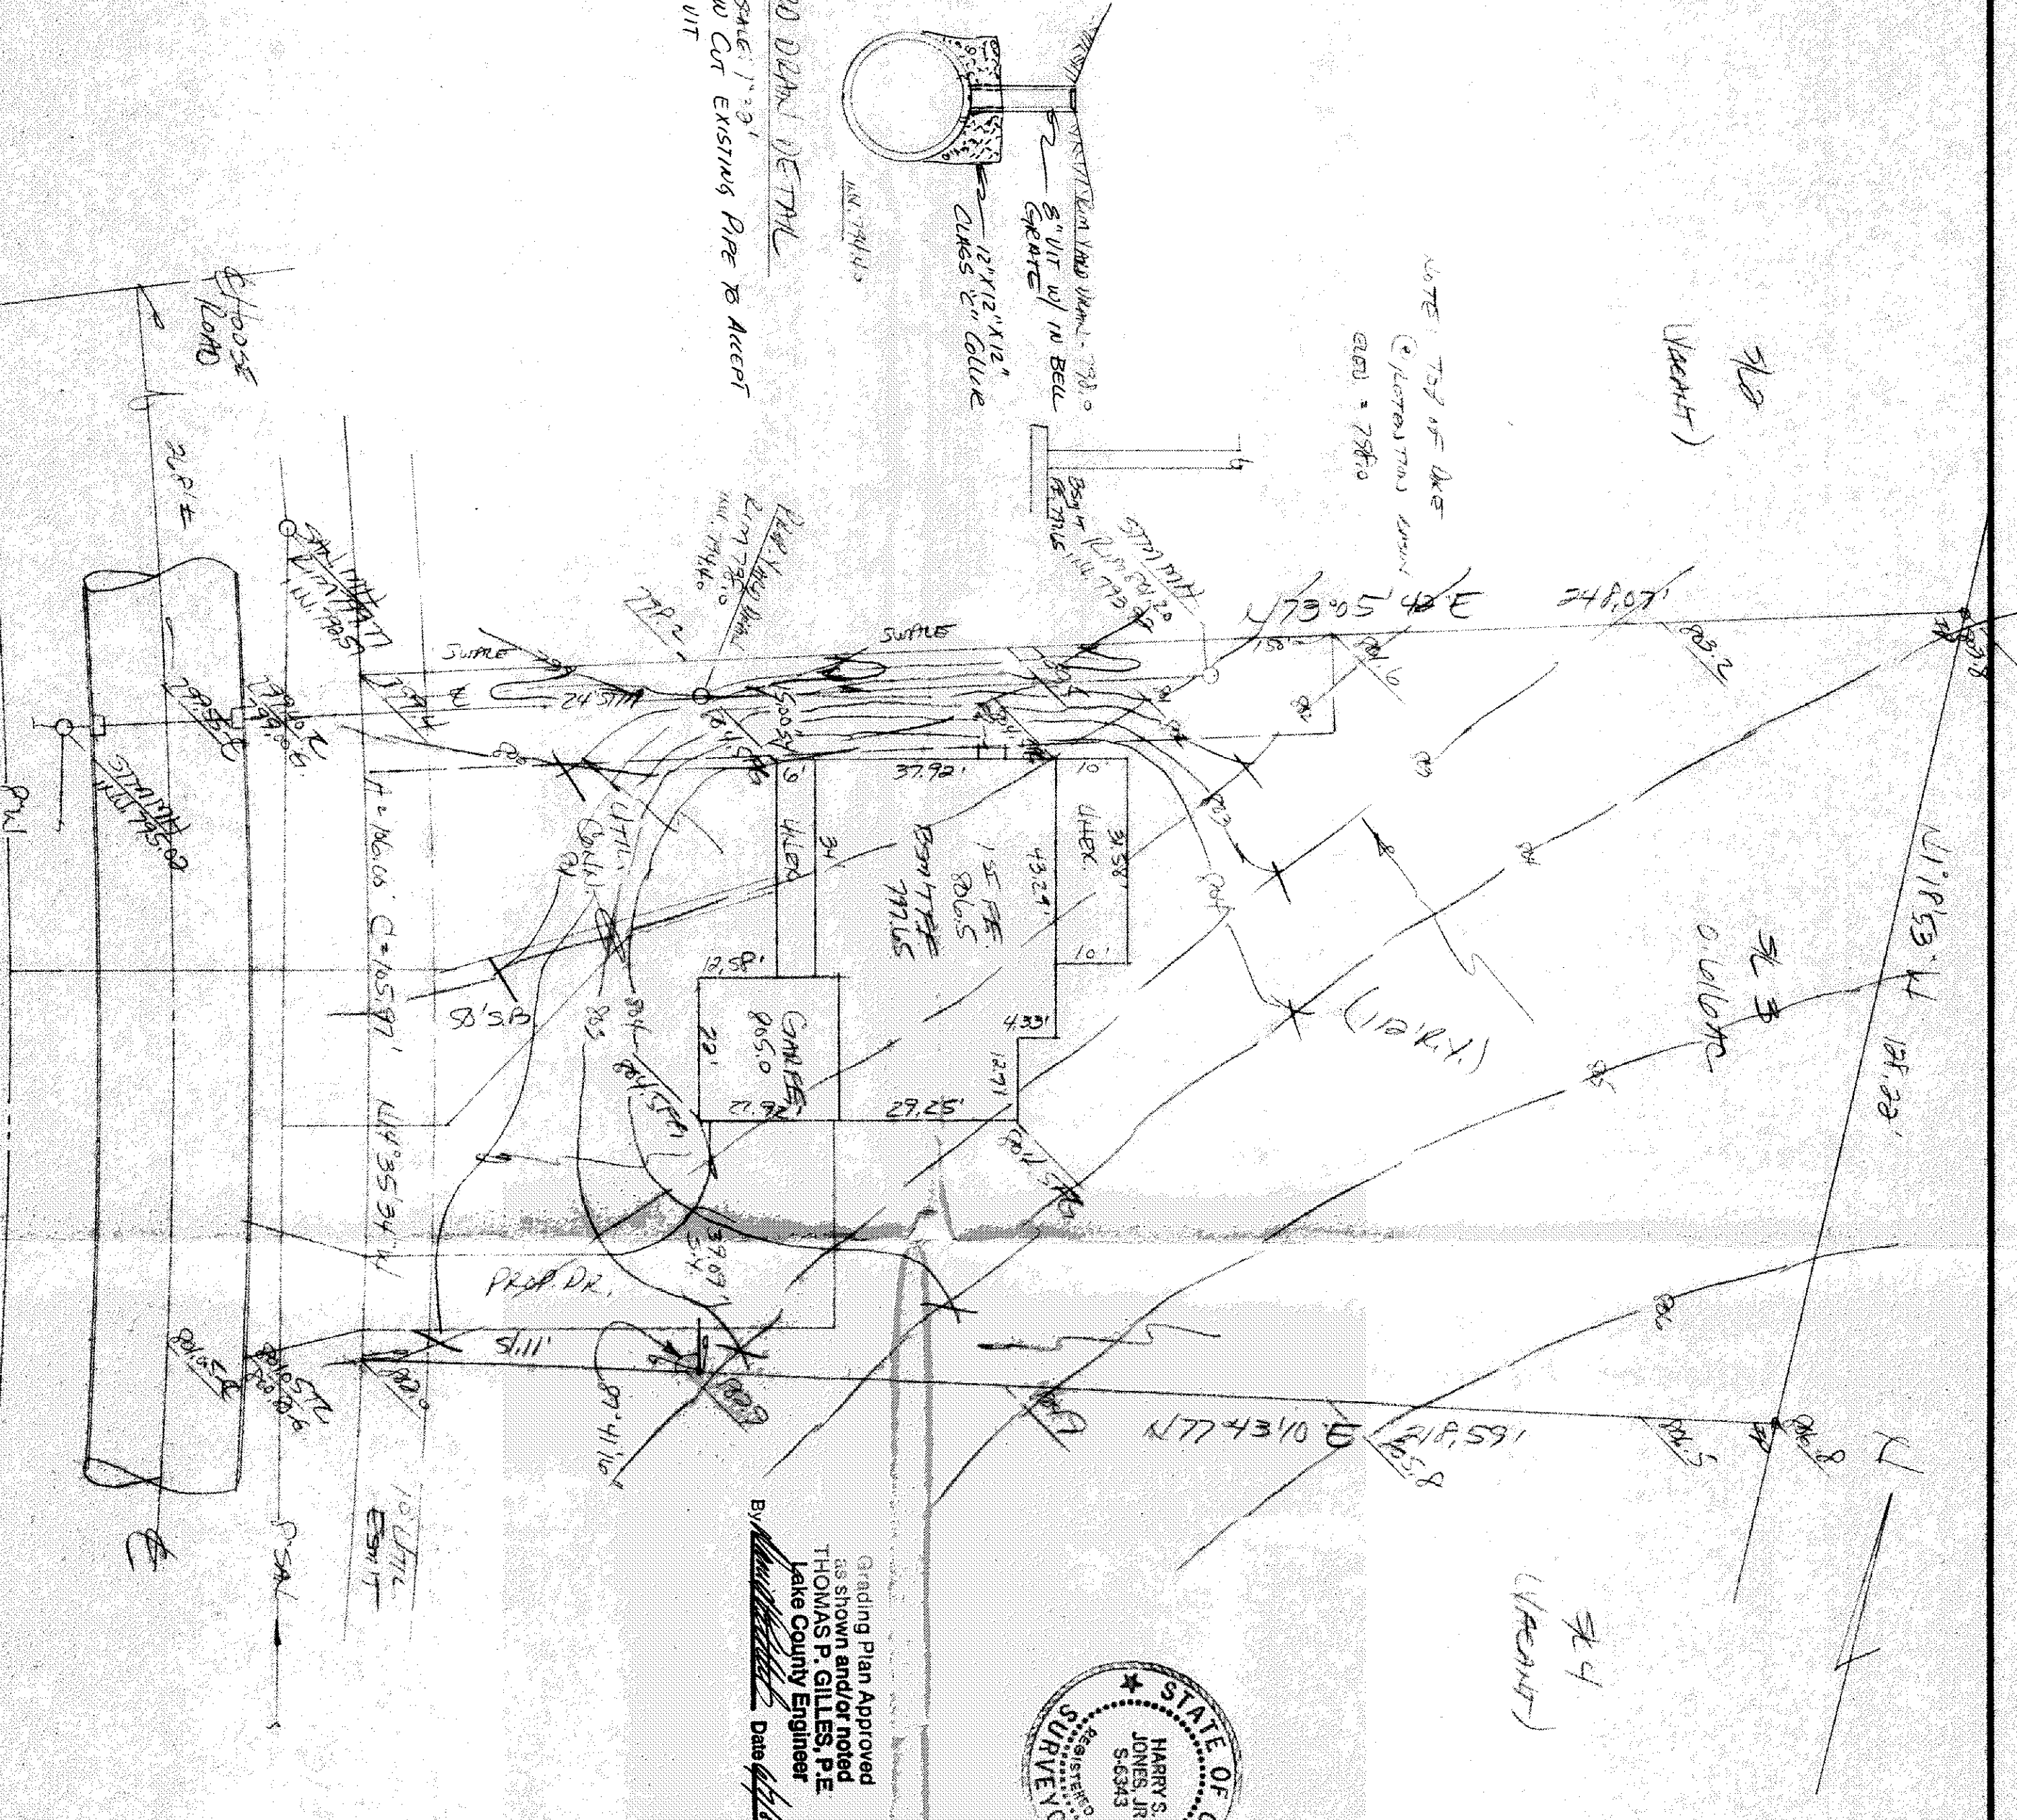

THATCHUM CARLE-60