

— x — x — SILT FENCE

 CONSTRUCTION ENTRANCE

NOTES:

- 1.) Down spouts shall be splashblocked.
- 2.) Field verify depth of Existing Sanitary Lateral to determine availability of basement sanitary service.
- 3.) Utilities include Gas, Phone, Electric, and Cable. Contractor to field verify location and provide connection at utility.
- 4.) Water Lateral to be 3/4" Copper Type "K".
- 5.) Sanitary Lateral to be 6" Poly Vinyl Chloride SDR 26, 0 Ring Joints @ 1.0% min slope.
- 6.) 6" Storm Connection to "Daylight" with house construction.

Stormwater Management Plan
 Approved as shown and/or noted
 JAMES M. GILLS, P.E.
 County Drainage Engineer
 By L.S. Date 11/29/06

County Drainage Engineer
By *L.S.* Date *11/29/08*

for : R.L. Moore Builders
CLIENT
1360 Madison Avenue Painesville OH 44077
ADDRESS CITY STATE ZIP

80 Nature Preserve North 50 4
SUBLOT No. SUBDIVISION NAME VOL. PAGE

2 2 Concord Township Ohio
LOT TRACT CITY STATE


Foresight Engineering Group
440 286-1010
440 286-1034 fax
320 Center Street, Unit F
Chardon, Ohio 44024

**Engineers &
Surveyors**

SCALE : 1" = 20	1	
FILE NAME: I:\RLM10605\Sublot 80	2	
DATE : November 9, 2006	3	

BENCHMARK: Fire Hydrant as noted.

SHEET NO.
1/2

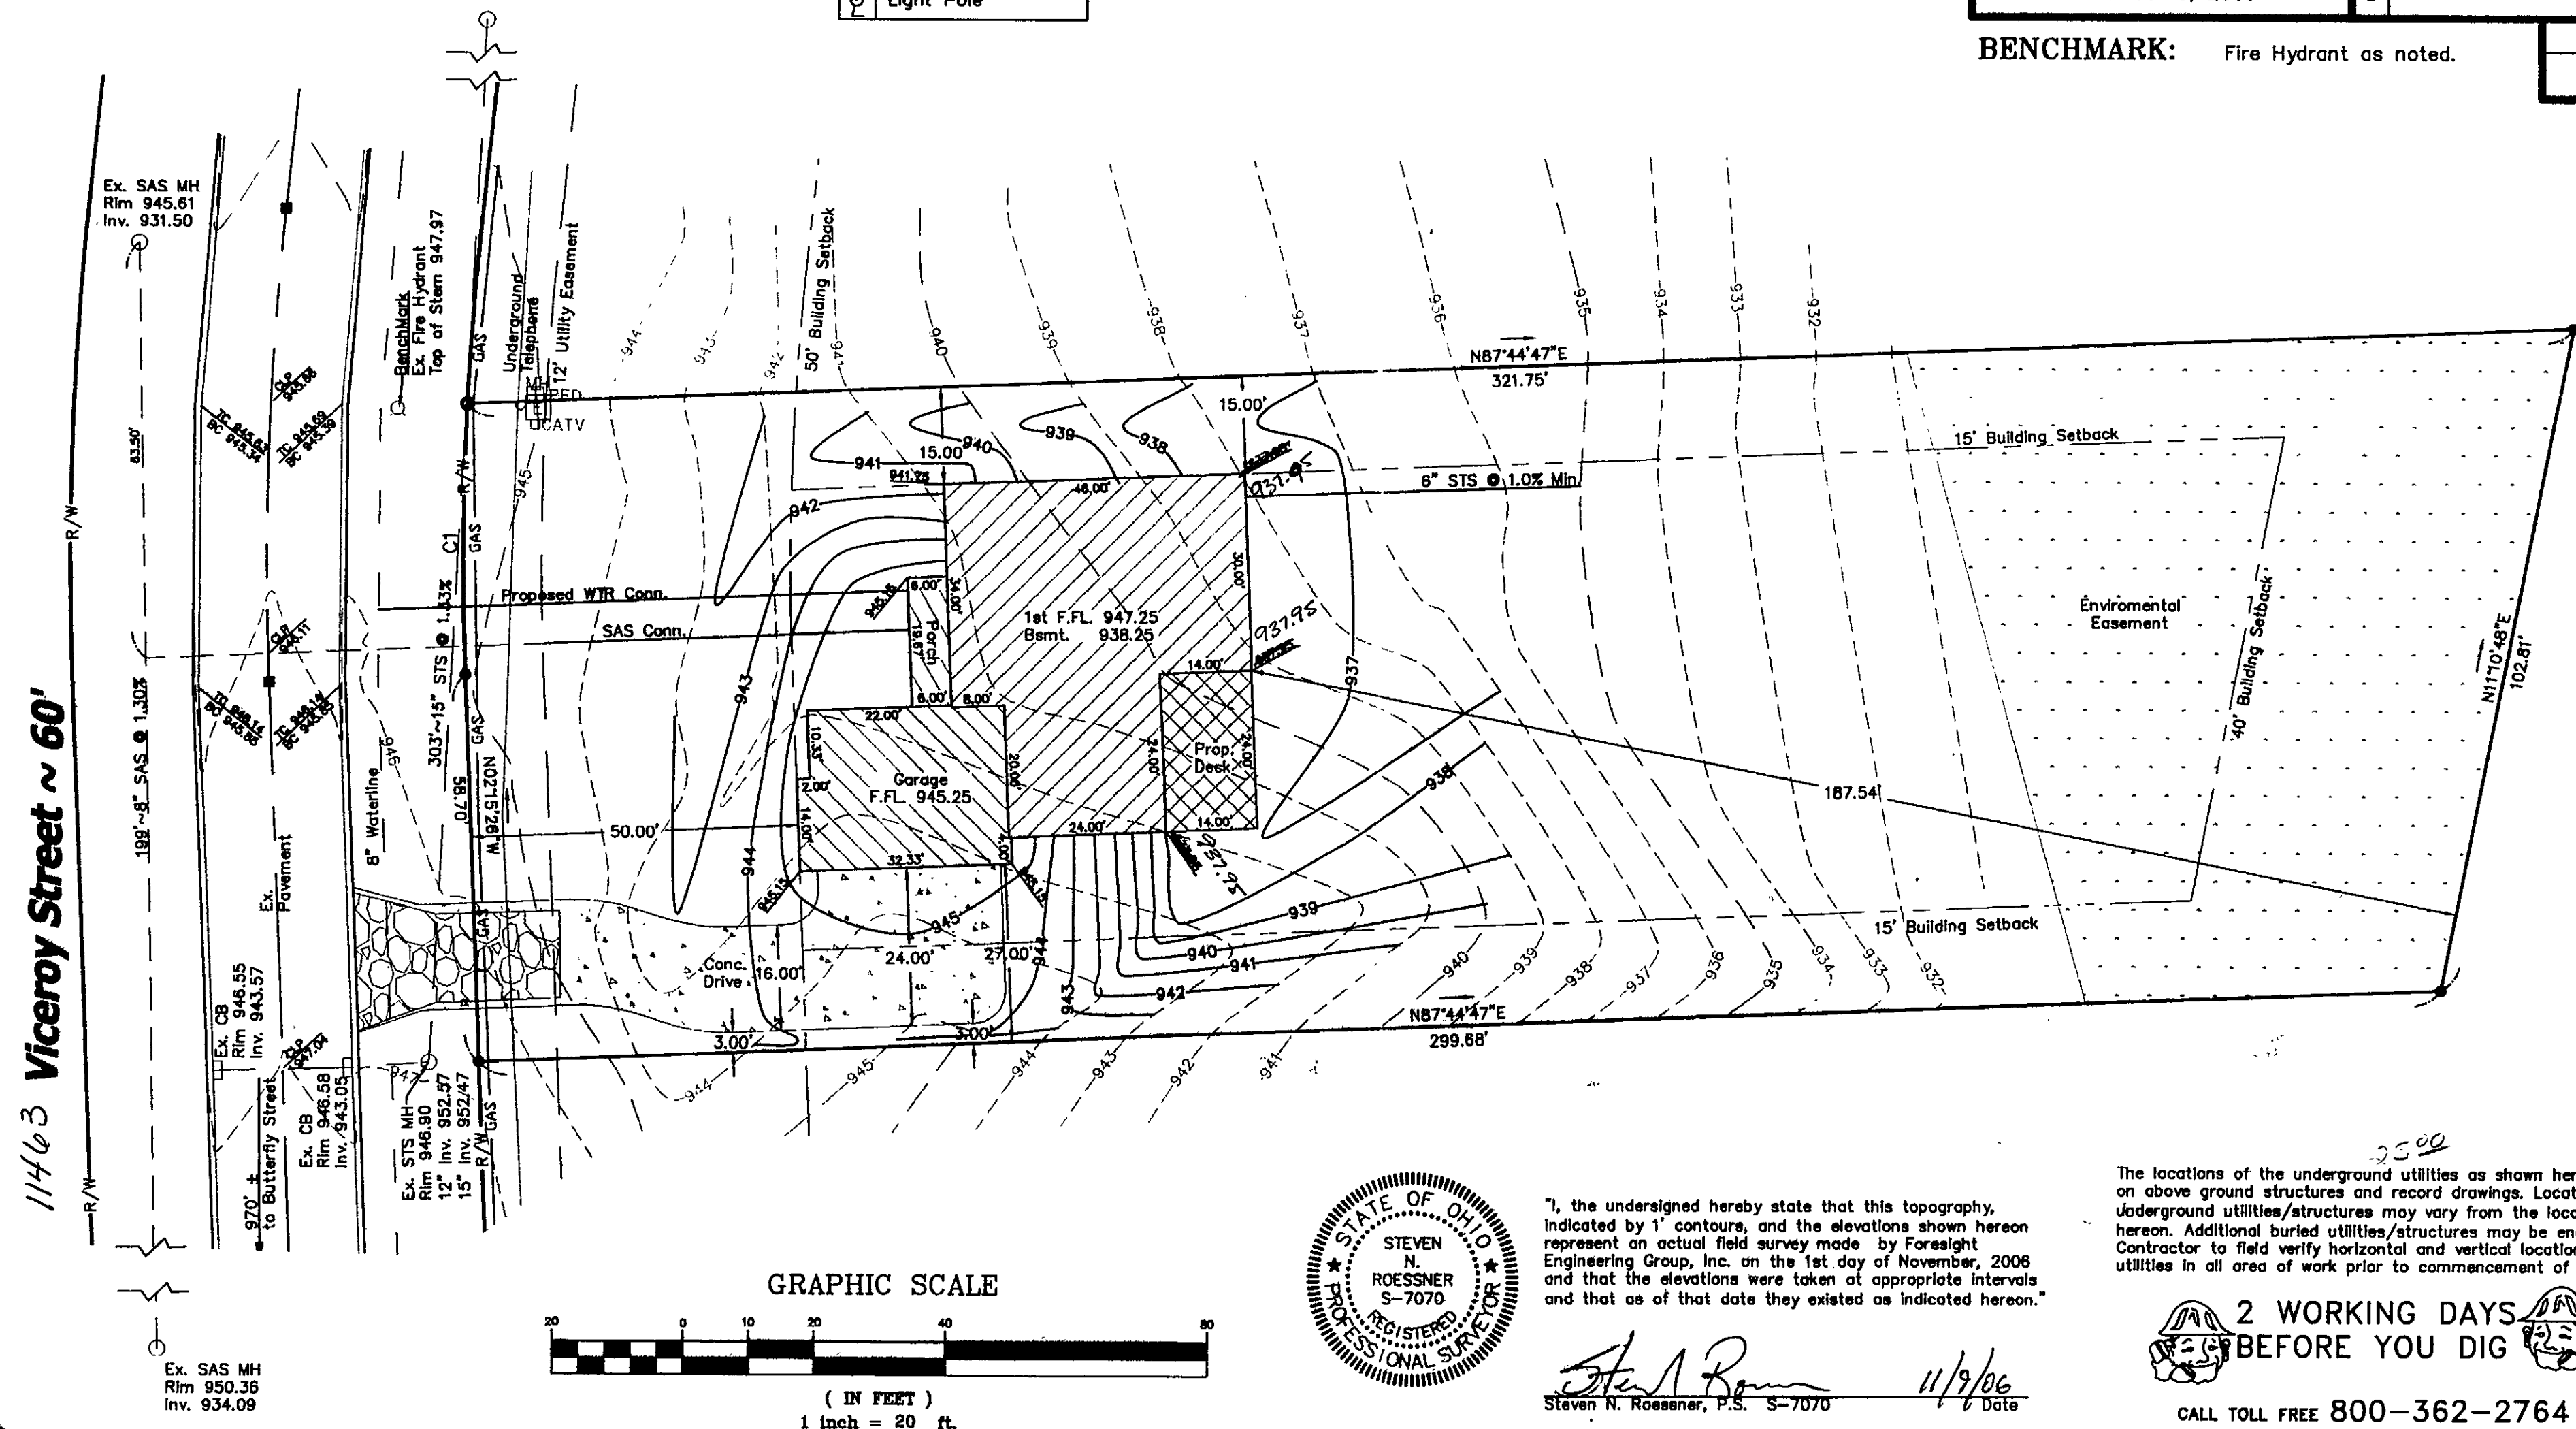

"I, the undersigned hereby state that this topography, indicated by 1' contours, and the elevations shown hereon represent an actual field survey made by Foresight Engineering Group, Inc. on the 1st day of November, 2008 and that the elevations were taken at appropriate intervals and that as of that date they existed as indicated hereon."

The locations of the underground utilities as shown hereon are based on above ground structures and record drawings. Locations of underground utilities/structures may vary from the locations shown hereon. Additional buried utilities/structures may be encountered. Contractor to field verify horizontal and vertical location of all utilities in all area of work prior to commencement of work.

 2 WORKING DAYS
BEFORE YOU DIG 

CALL TOLL FREE 800-362-2764