


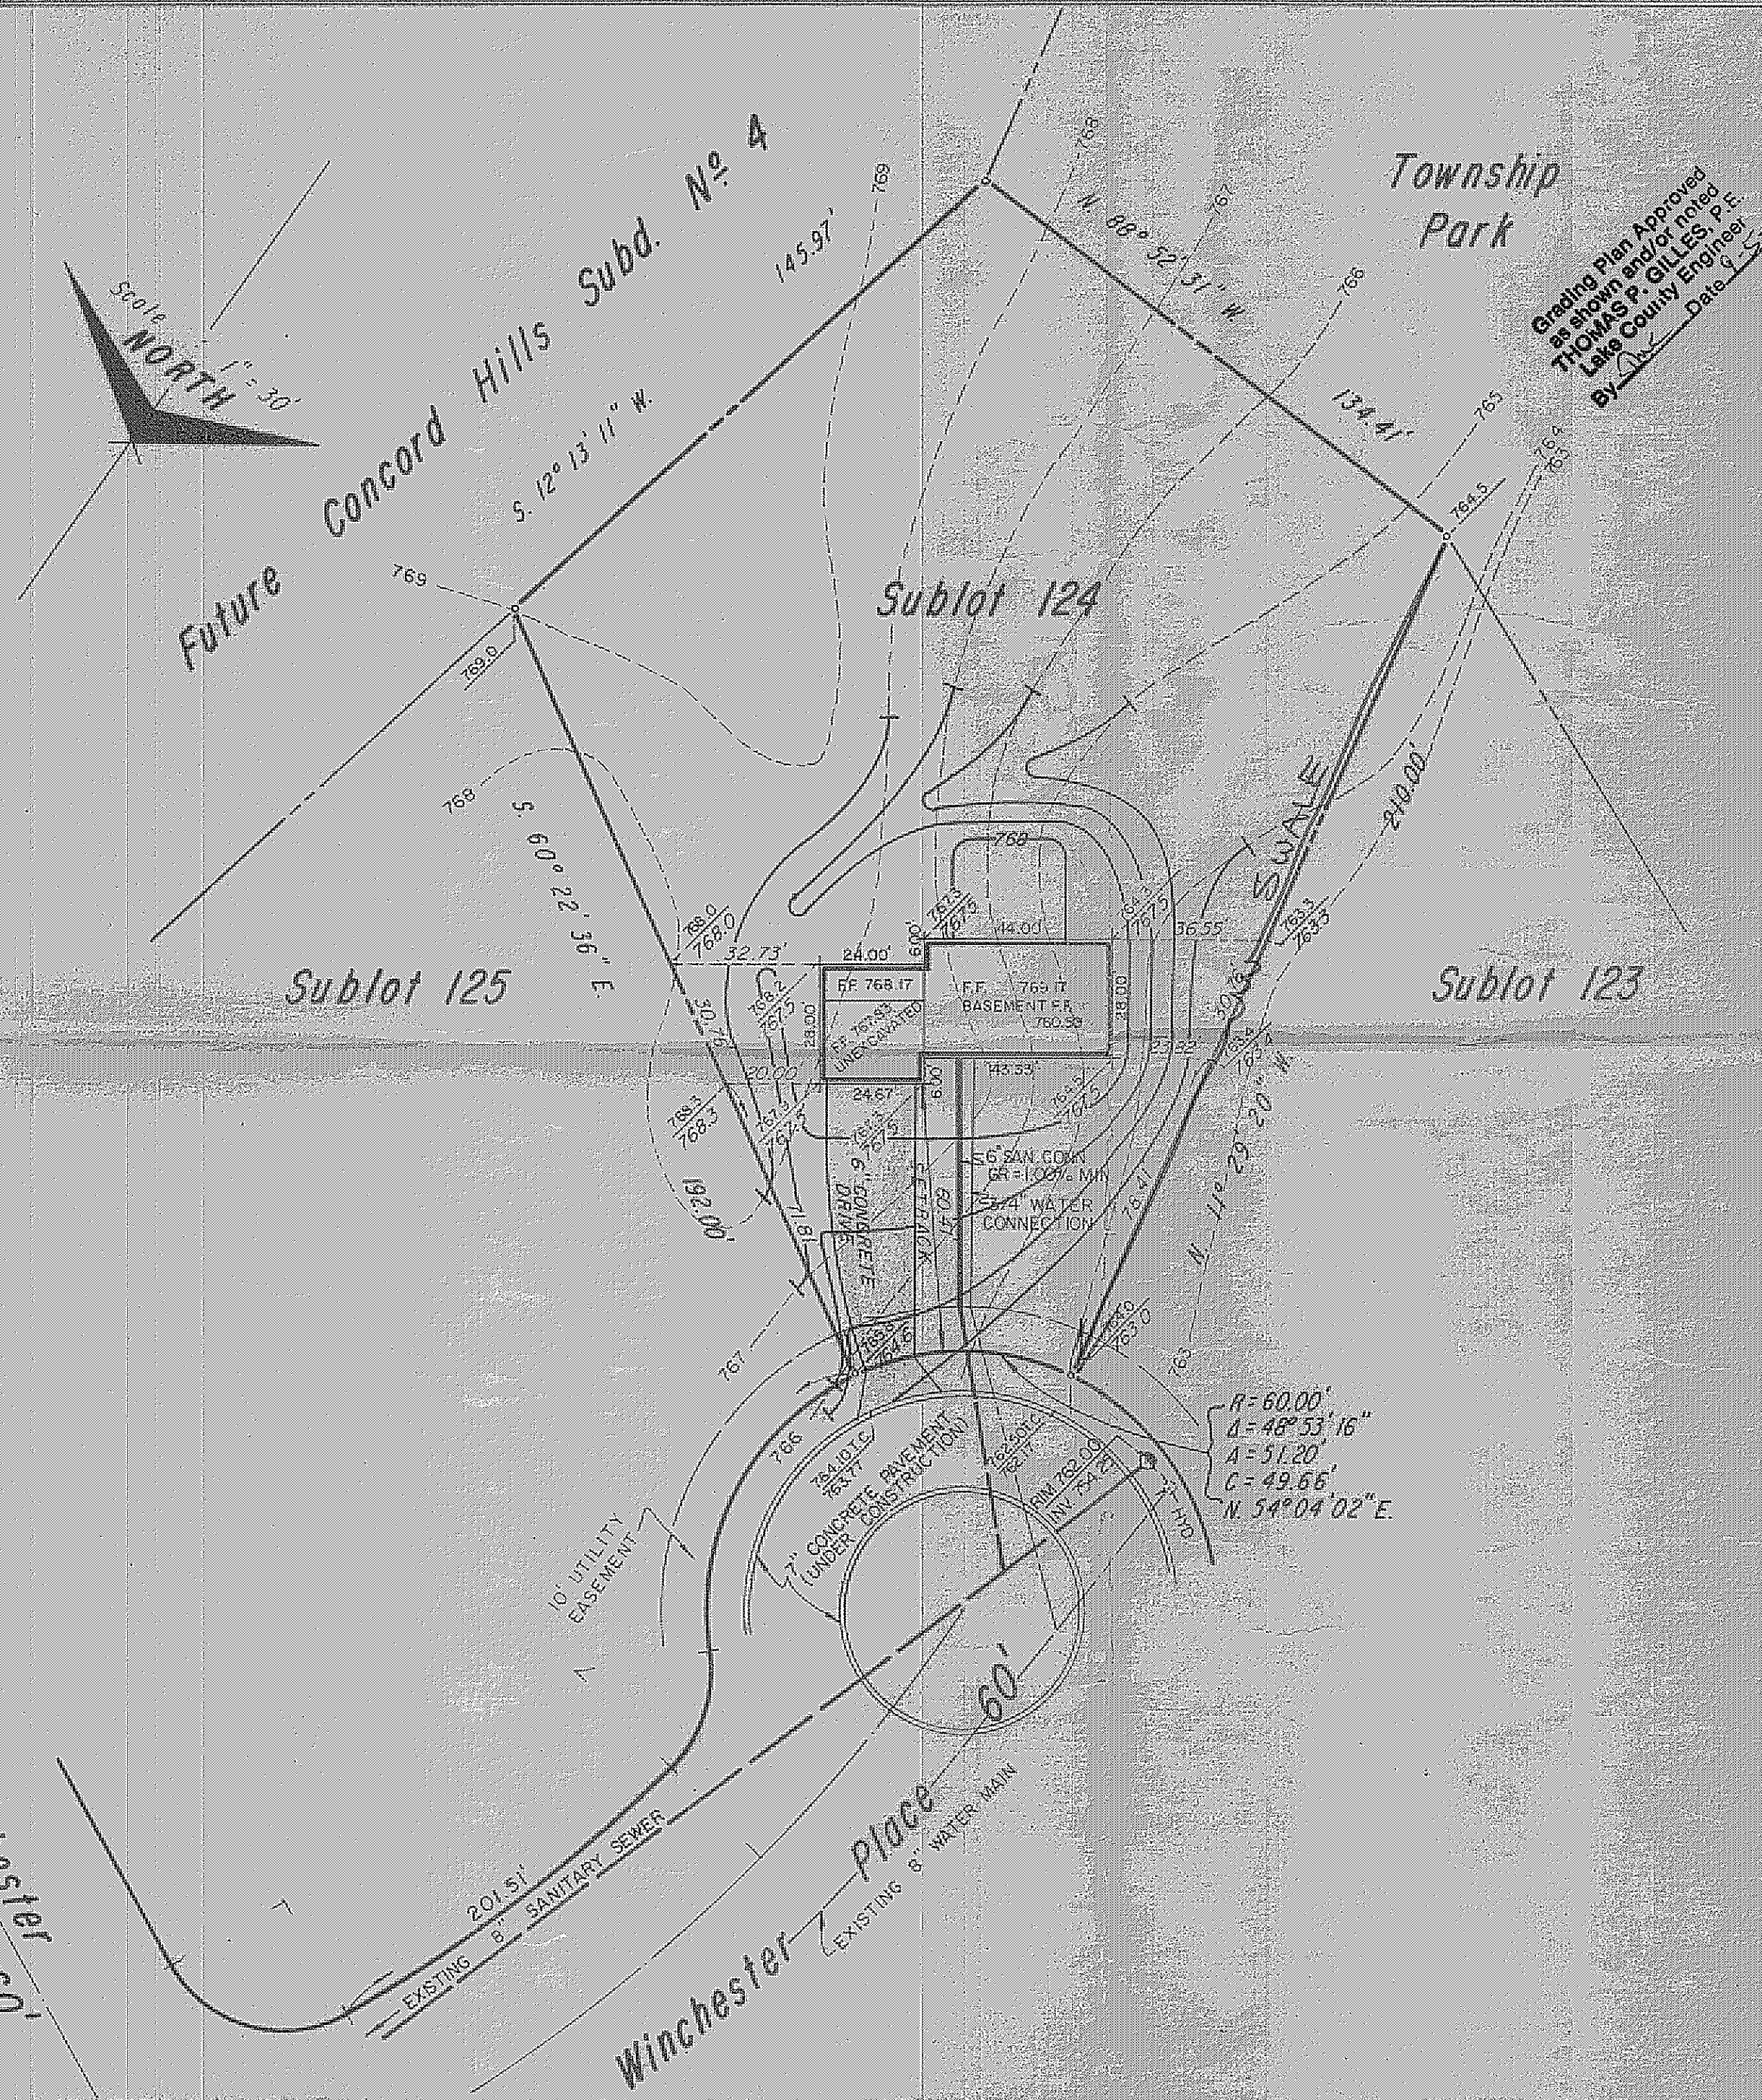

SITE PLAN

for <i>Kenneth T. Sowul</i>	OWNER
CLIENT	
ADDRESS	STREET CITY
<i>124 Concord Hills Subd. No. 2</i>	<i>X - 11</i>
SUBLOT NO.	SUBDIVISION NAME VOL. PAGE
	<i>Concord Township</i> OHIO
LOT, TRACT	

REMARKS
ALL BOUNDARY DATA SHOWN WAS OBTAINED FROM (DEEDS, RECORDED SUBDIVISION PLAT OR OTHER PUBLIC RECORDS). LOCATIONS AS SHOWN OF ADJACENT WELLS AND SEPTIC TANKS OBTAINED FROM LAKE COUNTY HEALTH DEPARTMENT.

LEGEND	
SANITARY MANHOLE	WATER VALVE (GAS)
PROPOSED CONTOURS	DIRECTION OF SURFACE DRAINAGE
EXIST. ELEV. → 100.0	
100.0 ← PROP. ELEV.	

CHECK LIST	
NO. OF BEDROOMS	WATER MAIN SIZE, LOCATION
DIMENSIONS	SAN. SEWER SIZE, GR. LOC.
BEARINGS	SAN. MH. CAST. ELEV. IN. ELEV.
TIE TO NEAREST STREET	SAN. CONN. SIZE, LOC. DEPTH
SUBLOT NO., PARCEL NO.	STORM SEWER SIZE, GR. LOC.
SURROUNDING OWNERS	STORM MH. CAST. ELEV. INV. ELEV.
BLDG. DIMENSIONS FIN. GR.	PAVT. TYPE, GRADE, CURBS
BLDG. TIES H. R. GRADES	GAS LINE LOC. SIZE, PRESSURE
APRON TYPE, WIDTH, THICKNESS	SEPTIC TANK LOCATION & DUPPLICATION AREA
SIDEWALK TYPE, WIDTH, THICKNESS	WELL LOCATION
CULVERT TYPE, DIA., LENGTH	ISOLATION RADIUS FROM WELL
ROCK OUTCROPPINGS	

DESIGN CERTIFICATION
THIS PLAT WAS PREPARED BY ME, AND IS CORRECT TO THE BEST OF MY KNOWLEDGE AND BELIEF.

NAME	SURVEYOR REGISTRATION NO.
"AS BUILT" CERTIFICATION	
I HEREBY CERTIFY THAT THE CIRCLED GRADES ARE EXISTING GRADES OBTAINED ON THE SITE ON	
10-1-78 AND ARE CORRECT TO THE BEST OF MY ACKNOWLEDGMENT AND BELIEF.	



LAND DESIGN consultants, inc.
ONE JACKSON STREET MENTOR, OHIO 44060
TELEPHONE 216-944-8772 or 354-6646

1	DRAWN BY <i>JR.</i>	SCALE <i>1" = 30'</i>	DRAWING NO.
2	CHK'D	DATE <i>7/5/78</i>	<i>180 - 124</i>
3	CREW CHIEF	APPD	