

SITE PLAN

for: KEVIN BAKER CLIENT OWNER

1000 JONES DR. ADDRESS LAKE COUNTY CITY 43000 ZIP

1000 JONES DR. SUBLOT NO. 1 1000 VOL. - PG. 1 1000 NAME 1000 JONES DR. STREET

1000 LOT 1000 TRACT 1000 VOLUME 1000 PAGE 1000 PERM. PARCEL NO. 1000 STREET 1000

LEGEND

SANITARY MANHOLE 1000 WATER VALVE (GAS) 1000  
STORM MANHOLE 1000 WATER METER (GAS) 1000  
INLET OR CATCH BASIN 1000 AS BUILT ELEVATION 1000  
HYDRANT 1000 INDICATES DIRECTION OF SURFACE DRAINAGE  
EXISTING CONTOURS 1000  
PROPOSED CONTOURS 1000  
EXIST. ELEV. 1000 PROP. ELEV. 1000

REMARKS

ALL BOUNDARY DATA SHOWN WAS OBTAINED FROM IDEEDS, RECORDED SUBDIVISION PLAT OR OTHER PUBLIC RECORDS!  
LOCATIONS AS SHOWN OF ADJACENT WELLS AND SEPTIC TANKS OBTAINED FROM LAKE COUNTY HEALTH DEPARTMENT

DESIGN CERTIFICATION

THIS PLAT WAS PREPARED BY ME, AND IS CORRECT TO THE BEST OF MY KNOWLEDGE AND BELIEF.

NAME 1000 SURVEYOR 1000 REGISTRATION NO. 1000

CHECK LIST

NO. OF BEDROOMS 1000  
DIMENSIONS 1000  
BEARINGS 1000  
TIE TO NEAREST STREET 1000  
SUBLOT NO. PARCEL NO. 1000  
SURROUNDING OWNERS 1000  
BLOG. DIMENSIONS FIN GR. 1000  
BLOG. TIES FLR. GRADES 1000  
ADJON. TYPE, WIDTH, THICKNESS 1000  
CULVERT TYPE, DIA. LENGTH 1000  
ROCK OUTCROPPINGS 1000

WATER MAIN SIZE, LOCATION 1000  
SAN. SEWER SIZE, % GR. LOC. 1000  
SAN. MH. CAST. ELEV. INV. ELEV. 1000  
SAN. CONN. SIZE, LOC. DEPTH 1000  
STORM SEWER SIZE, % GR. LOC. 1000  
STORM MH. CAST. ELEV. INV. ELEV. 1000  
PAV'T TYPE, GRADE CURBS 1000  
GAS LINE LOC. SIZE, PRESSURE 1000  
SEPTIC TANK LOCATION & DUPLICATION AREA 1000  
WELL LOCATION 1000  
ISOLATION RADIUS FROM WELL 1000

PLAN PREPARED BY:

BABCOCK • JONES & ASSOCIATES, INC.

PAINESVILLE, OHIO

REVISIONS  
NO. DATE BY  
1 1000 1000  
2 1000 1000  
3 1000 1000  
4 1000 1000  
5 1000 1000

DRAWN BY 1000 SCALE 1" = 10' PHONE NO. 1000  
CHK'D. 1000 DATE 1000 DRAWING NO. 1000  
CREW CHIEF 1000 APP'D. 1000

"AS BUILT" CERTIFICATION

I, HEREBY CERTIFY THAT THE CIRCLED GRADES ARE EXISTING FINISH GRADES CHECKED IN THE FIELD ON 1000, 19 1000 AND ARE CORRECT TO THE BEST OF MY KNOWLEDGE AND BELIEF.

REGISTERED SURVEYOR

REG. NO.

#5639

ZONING PERMIT

ISSUED 9-23-87

SUBJECT TO APPROVAL BY:

☐ Lake County Engineer

☒ Lake County Health Comm.


☐ Lake County Planning Comm.

☒ Lake County Bldg. Dept.

Temo J. Marano

Grading Plan Approved  
as shown and/or noted  
THOMAS P. GILLES, P.E.  
Lake County Engineer

By 1000 Date 9-23-87

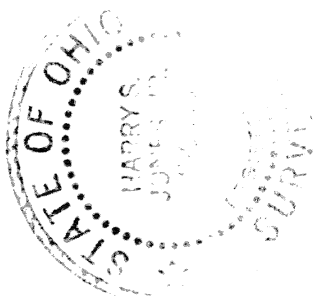

WEATHERSFIELD DR - 60'