

SITE PLAN

Bellevue Township, Lake County, Ohio

For: **2010 Century Construction**
253 Township Line Rd.
 ADDRESS: _____ CITY: _____ ZIP: _____

Survey: **Harold H. Hulse #2**
 SUBDIVISION: **B-12** NAME: _____
 VOLUME: _____ PAGE: _____
 SHEET: _____

LEGEND

SANITARY MANHOLE --- (M)
 STORM MANHOLE --- (S)
 INLET OR CATCH BASIN --- (IB)
 HYDRANT --- (H)
 EXISTING CONTOURS --- (E)
 PROPOSED CONTOURS --- (P)
 EXIST. ELEV. --- (E)
 PROP. ELEV. --- (P)

WATER VALVE (GAS) --- (V)
 WATER METER (GAS) --- (M)
 AS BUILT ELEVATION --- (A)
 INDICATES DIRECTION OF SURFACE DRAINAGE --- (D)

REMARKS

ALL BOUNDARY DATA SHOWN WAS OBTAINED FROM IDEEDS, RECORDED SUBDIVISION PLAT OR OTHER PUBLIC RECORDS.
 LOCATIONS AS SHOWN OF ADJACENT WELLS AND SEPTIC TANKS OBTAINED FROM LAKE COUNTY HEALTH DEPARTMENT

DESIGN CERTIFICATION

THIS PLAT WAS PREPARED BY ME, AND IS CORRECT TO THE BEST OF MY KNOWLEDGE AND BELIEF.

CHECK LIST

NO. OF BEDROOMS _____
 DISBURSING BEARINGS _____
 TIE TO NEAREST STREET SUBLOT NO. PARCEL NO. _____
 SURROUNDING OWNERS ELEC. DIMENSIONS FIN. GR. _____
 SLOD. TIE ELEV. GR. _____
 ASSON. TYPE WIDTH THICKNESS _____
 SIDEWALK TYPE WIDTH THICKNESS _____
 CULVERT TYPE DIA. LENGTH _____
 ROCK OUTCROPPINGS _____
 WATER MAIN SIZE, LOCATION _____
 SAN. SEWER SIZE & GR. LOC. _____
 SAN. INH. CAST. ELEV. INV. ELEV. _____
 SAN. CORR. SIZE, LOC. DEPTH _____
 STORM SEWER SIZE & GR. LOC. _____
 STORM INH. CAST. ELEV. INV. ELEV. _____
 PAVT. TYPE GRADE CURBS _____
 GAS LINE LOC. SIZE PRESSURE _____
 SEPTIC TANK LOCATION & DUPPLICATION AREA _____
 WELL LOCATION _____
 ISOLATION RADII FROM WELL _____

PLAN PREPARED BY: **BABCOCK • JONES & ASSOCIATES, INC.**
 PAINESVILLE, OHIO

NO.	DATE	BY
1	3/1/88	HT
2	3/1/88	HT
3		
4		
5		

DRAWN BY: **HT** SCALE: 1" = 30'
 CHK'D: **HT** DATE: **3/1/88** PHONE NO. 357-1811
 CHIEF: **HT** APP'D: **HT** DRAWING NO. 87-247-7

"AS BUILT" CERTIFICATION


I, HEREBY CERTIFY THAT THE CIRCLED GRADES ARE EXISTING FINISH GRADES CHECKED IN THE FIELD ON _____ 19____ AND ARE CORRECT TO THE BEST OF MY KNOWLEDGE AND BELIEF.

REGISTERED SURVEYOR _____ REG. NO. _____

T.B.M. - Rm 544 M.H.
 ELEV. - 870.34

#5742
 3-31-88

Toro 8. Marano

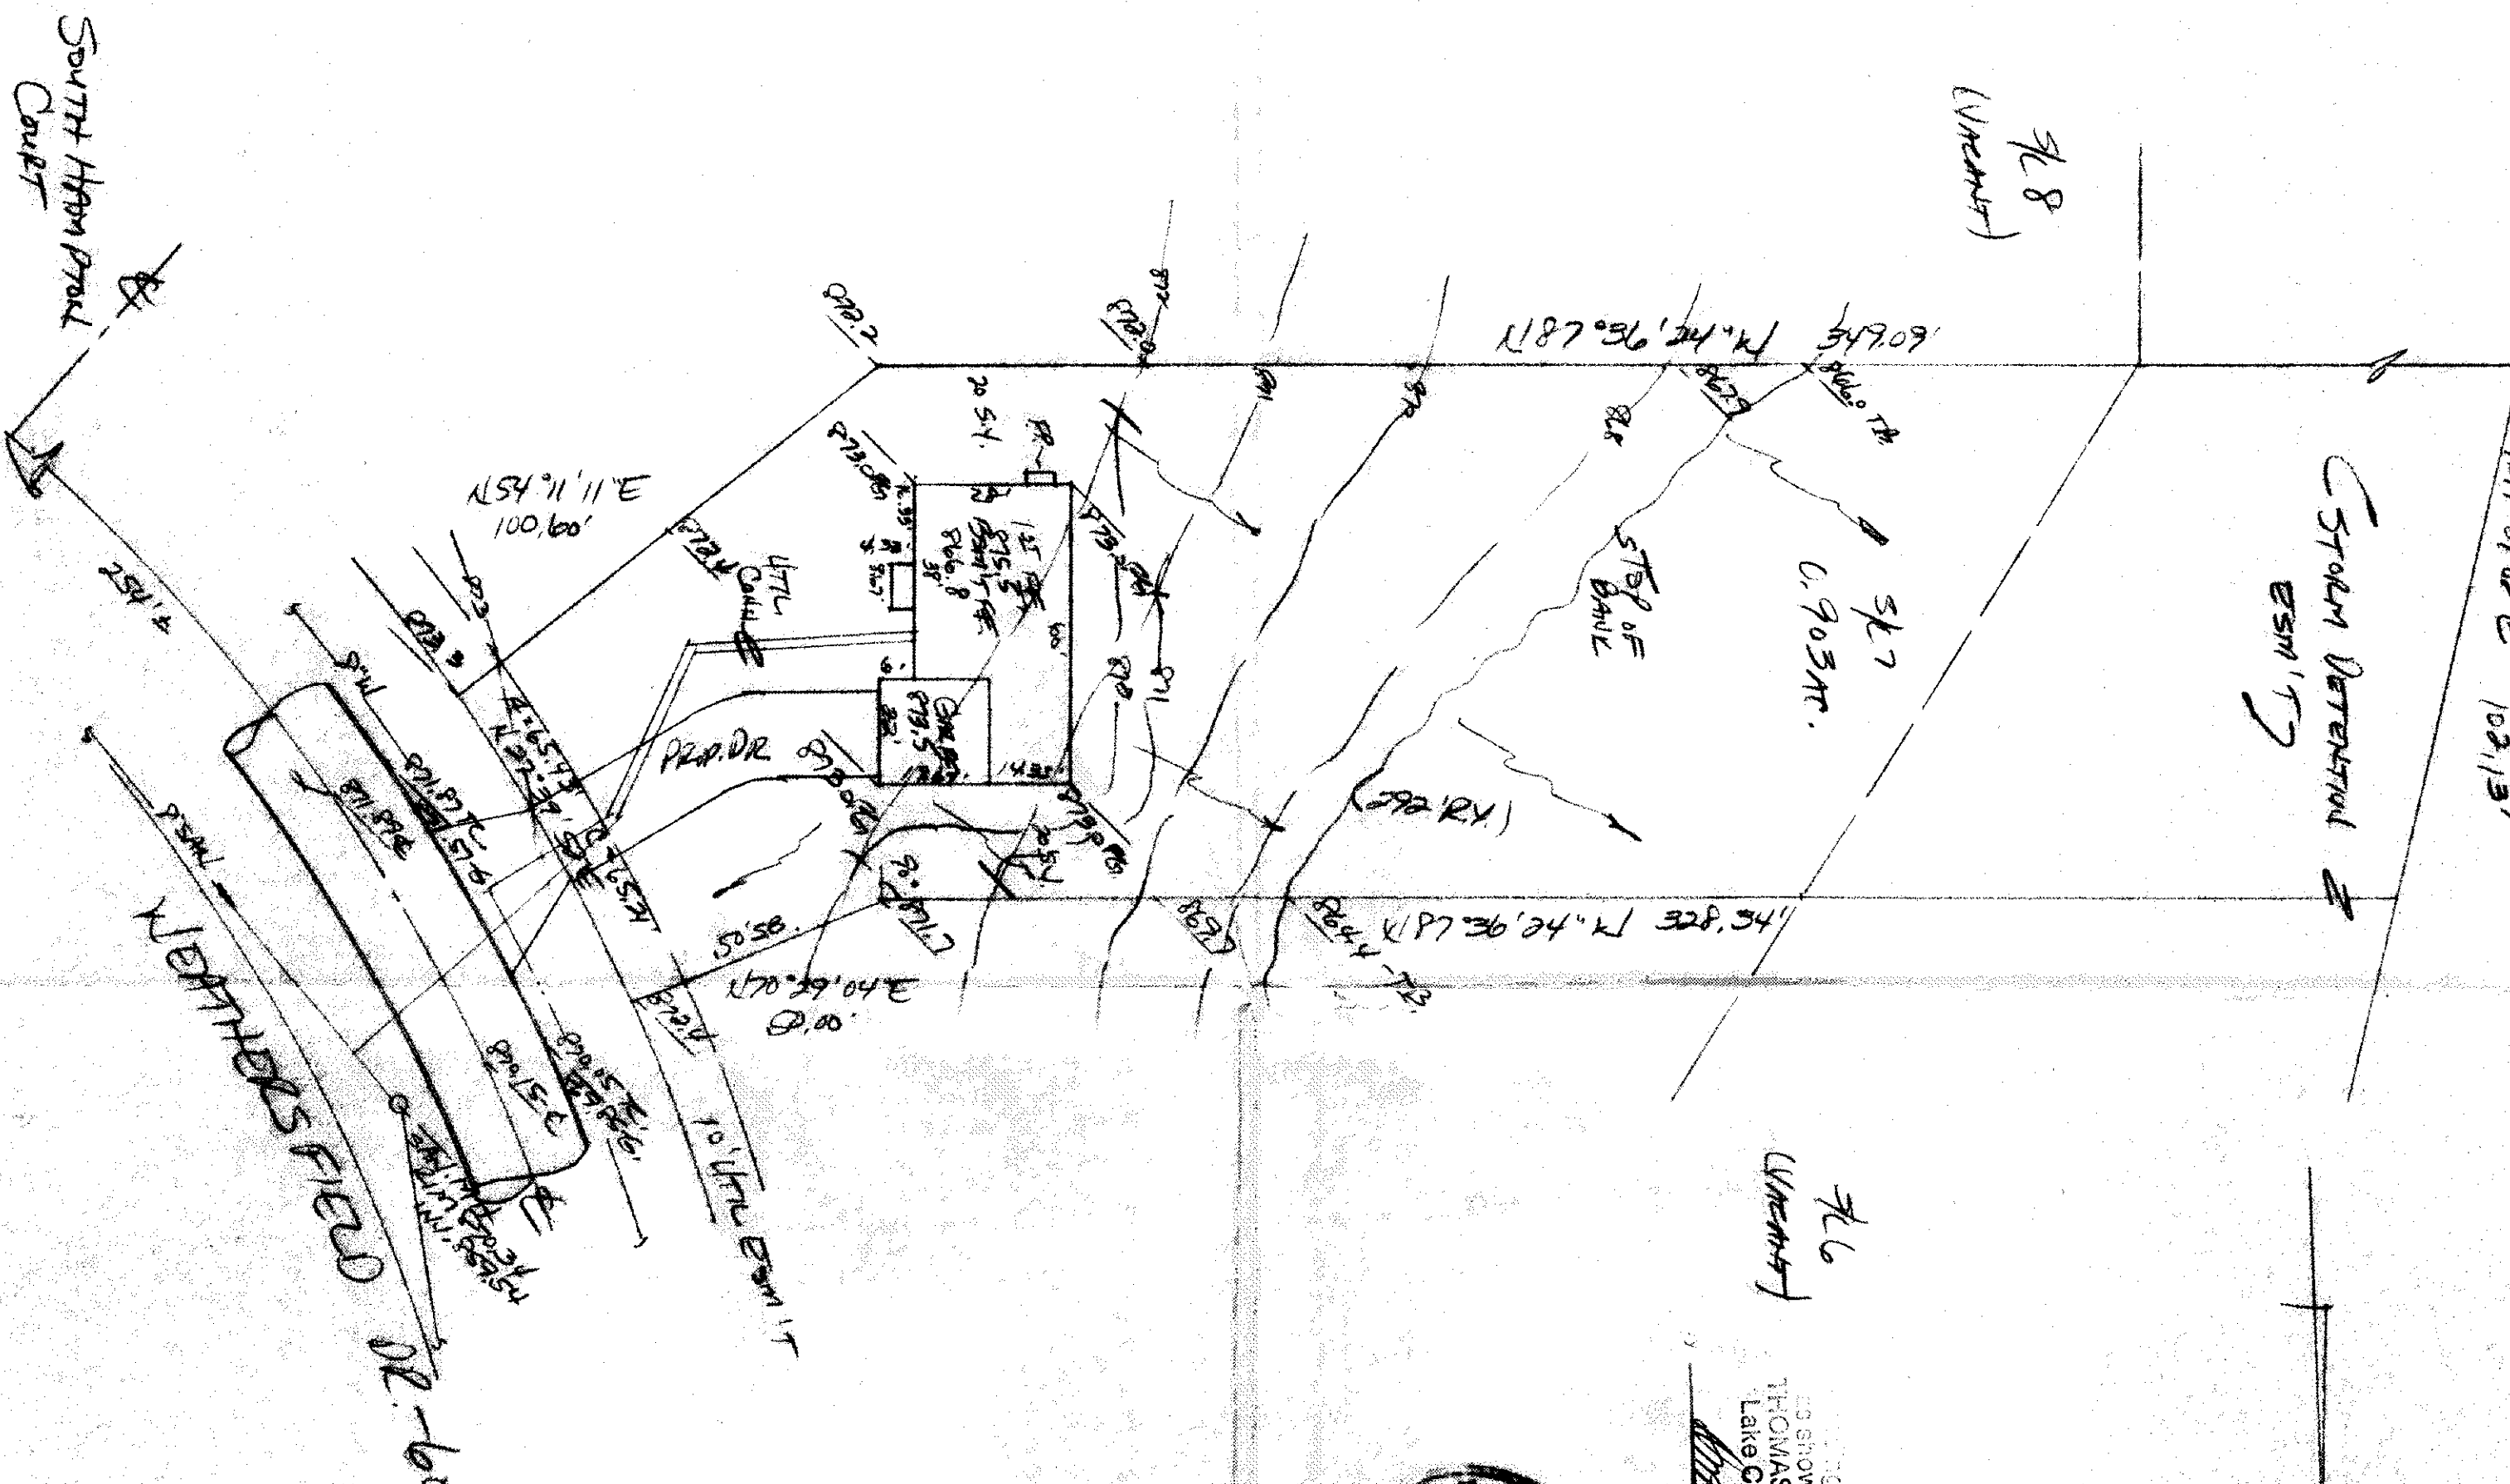

Plan Approved
 as shown and/or noted
THOMAS P. GILLES, P.E.
 Lake County Engineer
 Date: **4/1/88**