


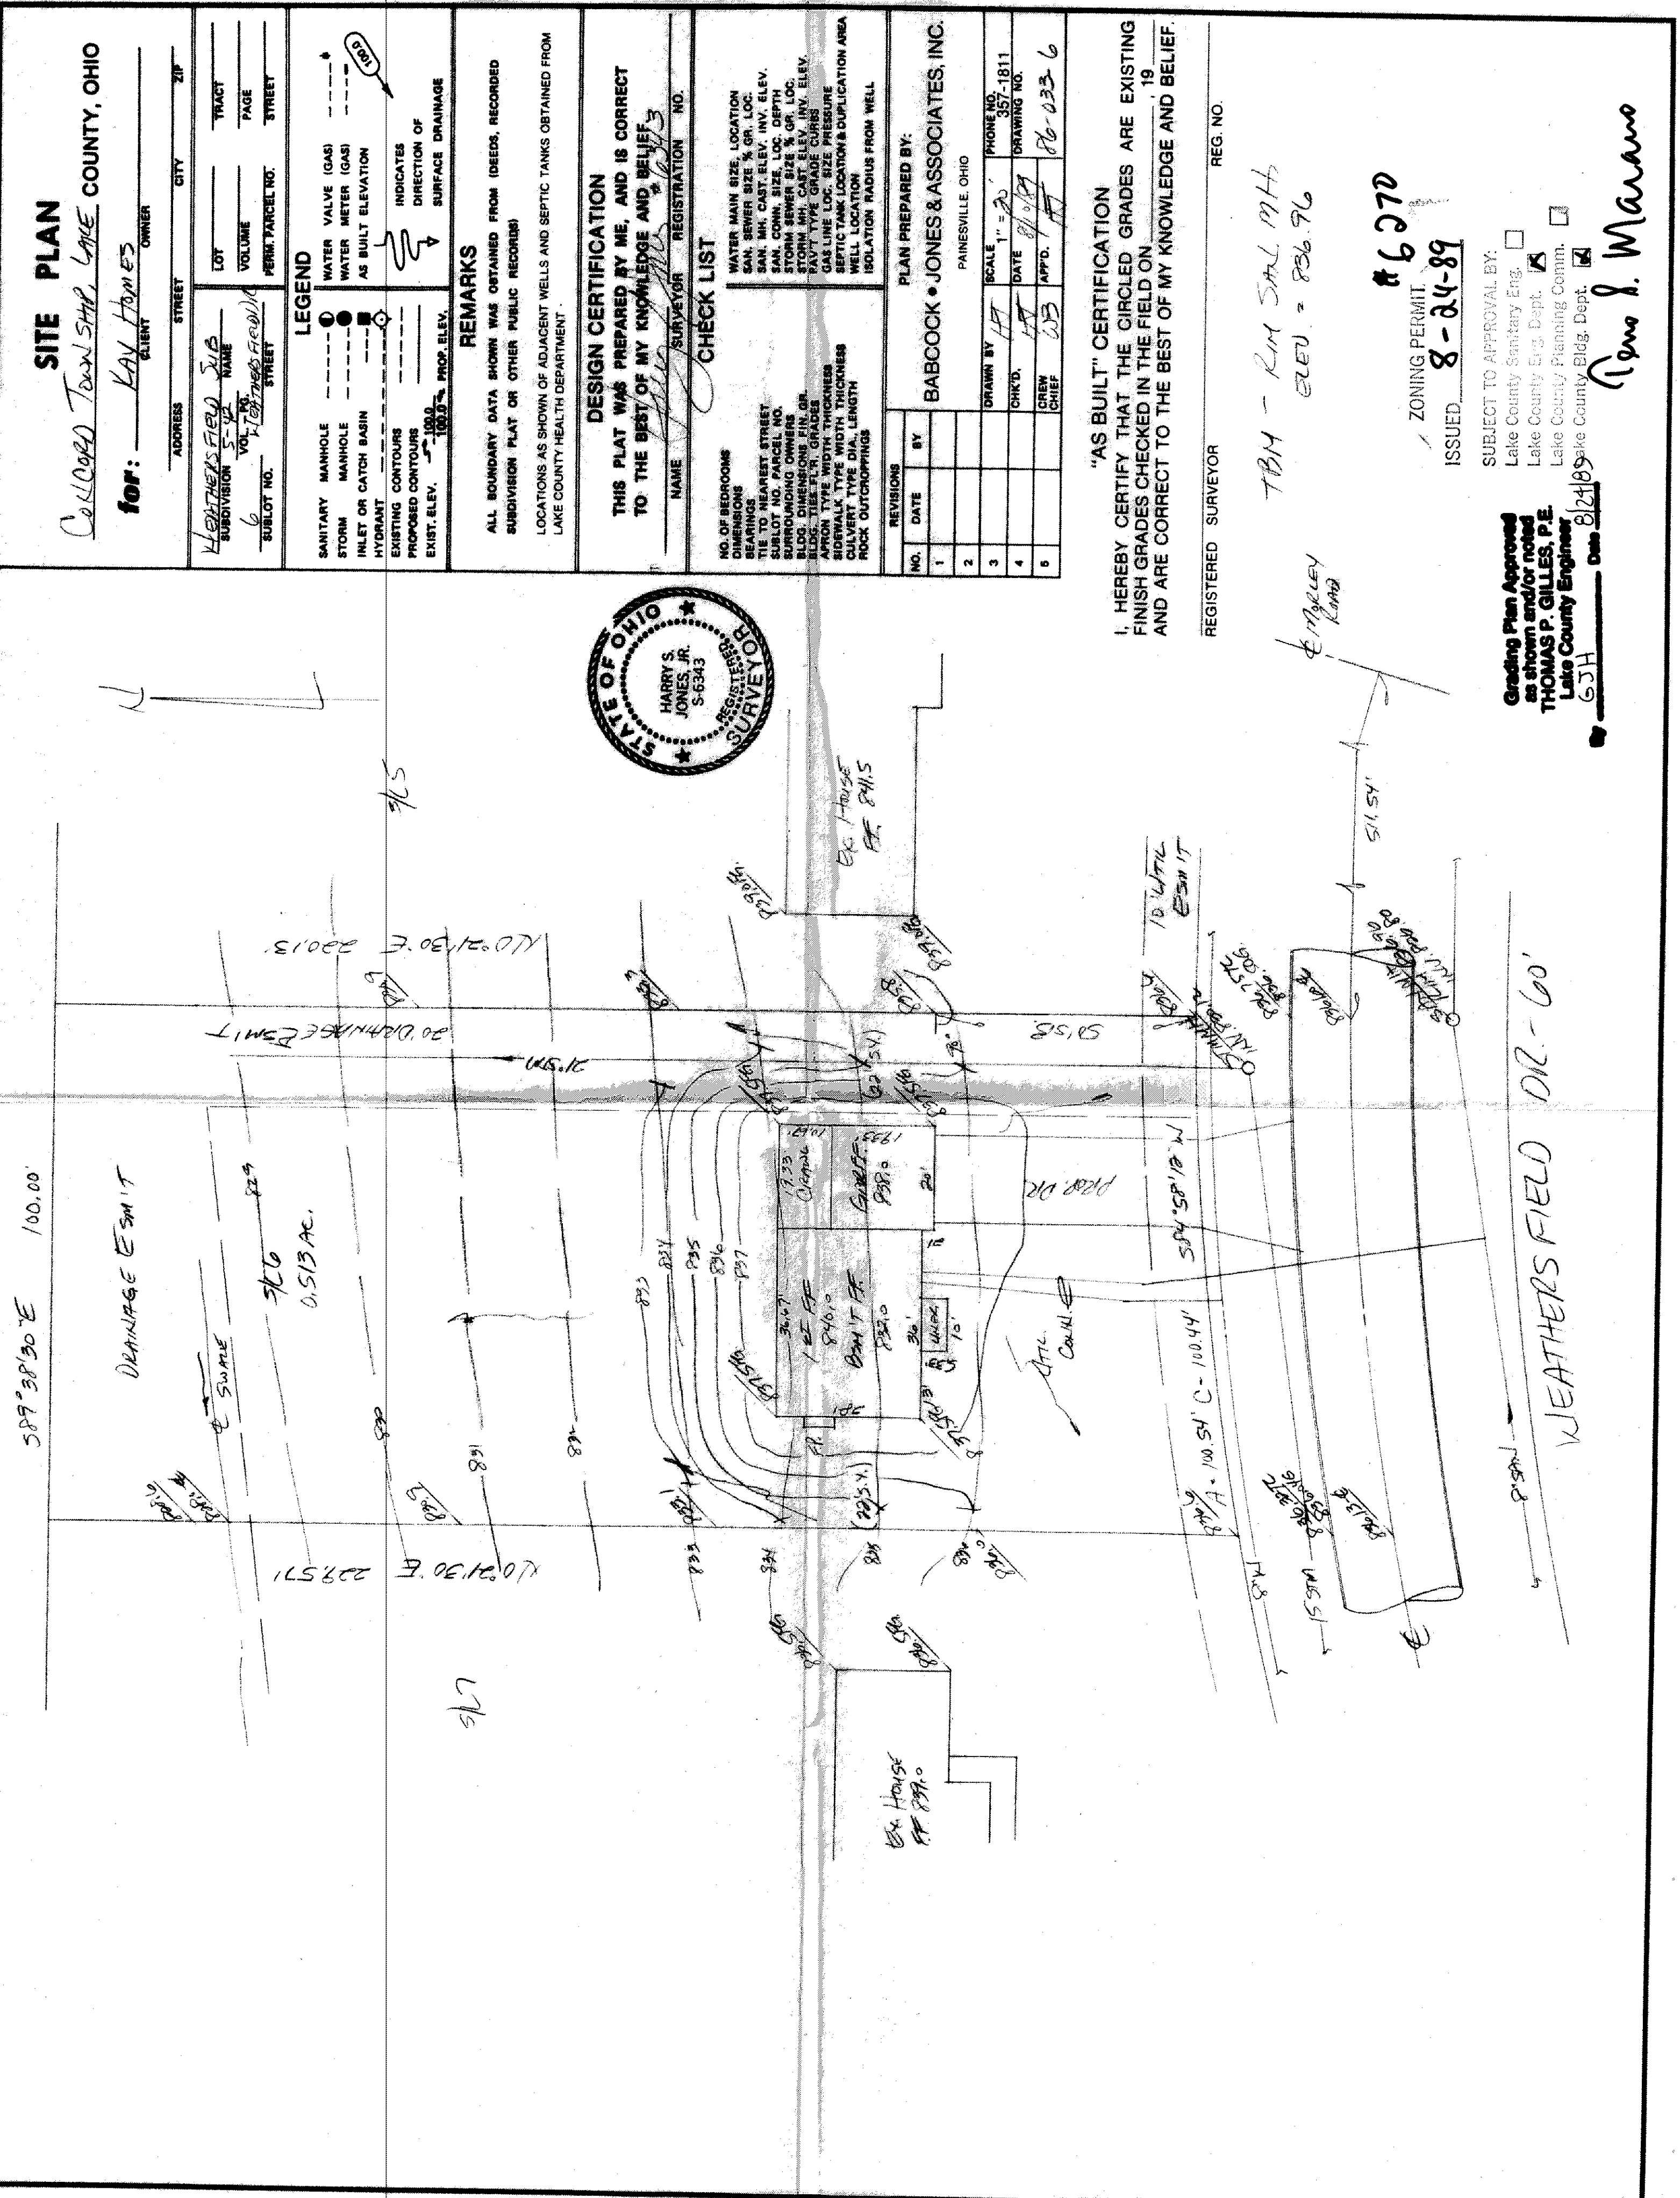

SITE PLAN

Colcord Township, Lake County, Ohio
for: KAY HOMES
CLIENT
OWNER

ADDRESS WEATHERS FIELD SUB CITY LAKE COUNTY, OHIO ZIP 43004
SUBDIVISION 5-22 NAME WEATHERS FIELD SUB LOT 1 TRACT 1
VOLUME 6 PERM. PARCEL NO. 1 PAGE 1 STREET 1

LEGEND
SANITARY MANHOLE 1 WATER VALVE (GAS) 1
STORM MANHOLE 1 WATER METER (GAS) 1
INLET OR CATCH BASIN 1 AS BUILT ELEVATION 1
HYDRANT 1 EXISTING CONTOURS 1 INDICATES DIRECTION OF SURFACE DRAINAGE
PROPOSED CONTOURS 1 EXIST. ELEV. 100.0 PROP. ELEV. 100.0

REMARKS
ALL BOUNDARY DATA SHOWN WAS OBTAINED FROM (DEEDS, RECORDED SUBDIVISION PLAT OR OTHER PUBLIC RECORDS)
LOCATIONS AS SHOWN OF ADJACENT WELLS AND SEPTIC TANKS OBTAINED FROM LAKE COUNTY HEALTH DEPARTMENT

DESIGN CERTIFICATION
THIS PLAT WAS PREPARED BY ME, AND IS CORRECT TO THE BEST OF MY KNOWLEDGE AND BELIEF

CHECK LIST
NAME HARRY S. JONES, JR. SURVEYOR REGISTRATION NO. 6343
WATER MAIN SIZE, LOCATION
SAN. SEWER SIZE, % GR. LOC.
SAN. MH. CAST. ELEV. INV. ELEV.
STORM SEWER SIZE, % GR. LOC.
STORM MH. CAST. ELEV. INV. ELEV.
RAV. TYPE GRADE CURVES
GAS LINE LOC. SIZE PRESSURE
SEPTIC TANK LOCATION & DUPLICATION AREA
WELL LOCATION
ISOLATION RADIUS FROM WELL

REVISIONS
NO. DATE BY
1
2
3
4
5
PLAN PREPARED BY: BABCOCK • JONES & ASSOCIATES, INC.
PAINESVILLE, OHIO
DRAWN BY HT SCALE 1" = 20' PHONE NO. 357-1811
CHK'D. HT DATE 8/10/89 DRAWING NO. 86-033-6
CREW CHIEF WB APP'D. HT

"AS BUILT" CERTIFICATION
I, HEREBY CERTIFY THAT THE CIRCLED GRADES ARE EXISTING FINISH GRADES CHECKED IN THE FIELD ON 19 19
AND ARE CORRECT TO THE BEST OF MY KNOWLEDGE AND BELIEF.

REGISTERED SURVEYOR REG. NO. 6343
TBM - RM 541.174
ELEV. = 836.96
ZONING PERMIT 86270
ISSUED 8-24-89
SUBJECT TO APPROVAL BY:
Lake County Sanitary Eng. ☐
Lake County Eng. Dept. ☒
Lake County Planning Comm. ☐
Lake County Bldg. Dept. ☒
Grading Plan Approved as shown and/or noted by THOMAS P. GILLES, P.E.
Lake County Engineer GJH Date 8/24/89
Tom J. Marano