


WEATHERSFIELD DR. 600

8" SAU

10' UTILITY
EASEMENT

BEUCHMALL
TOP STEIN OF HODLADT
ZLV. 939.47

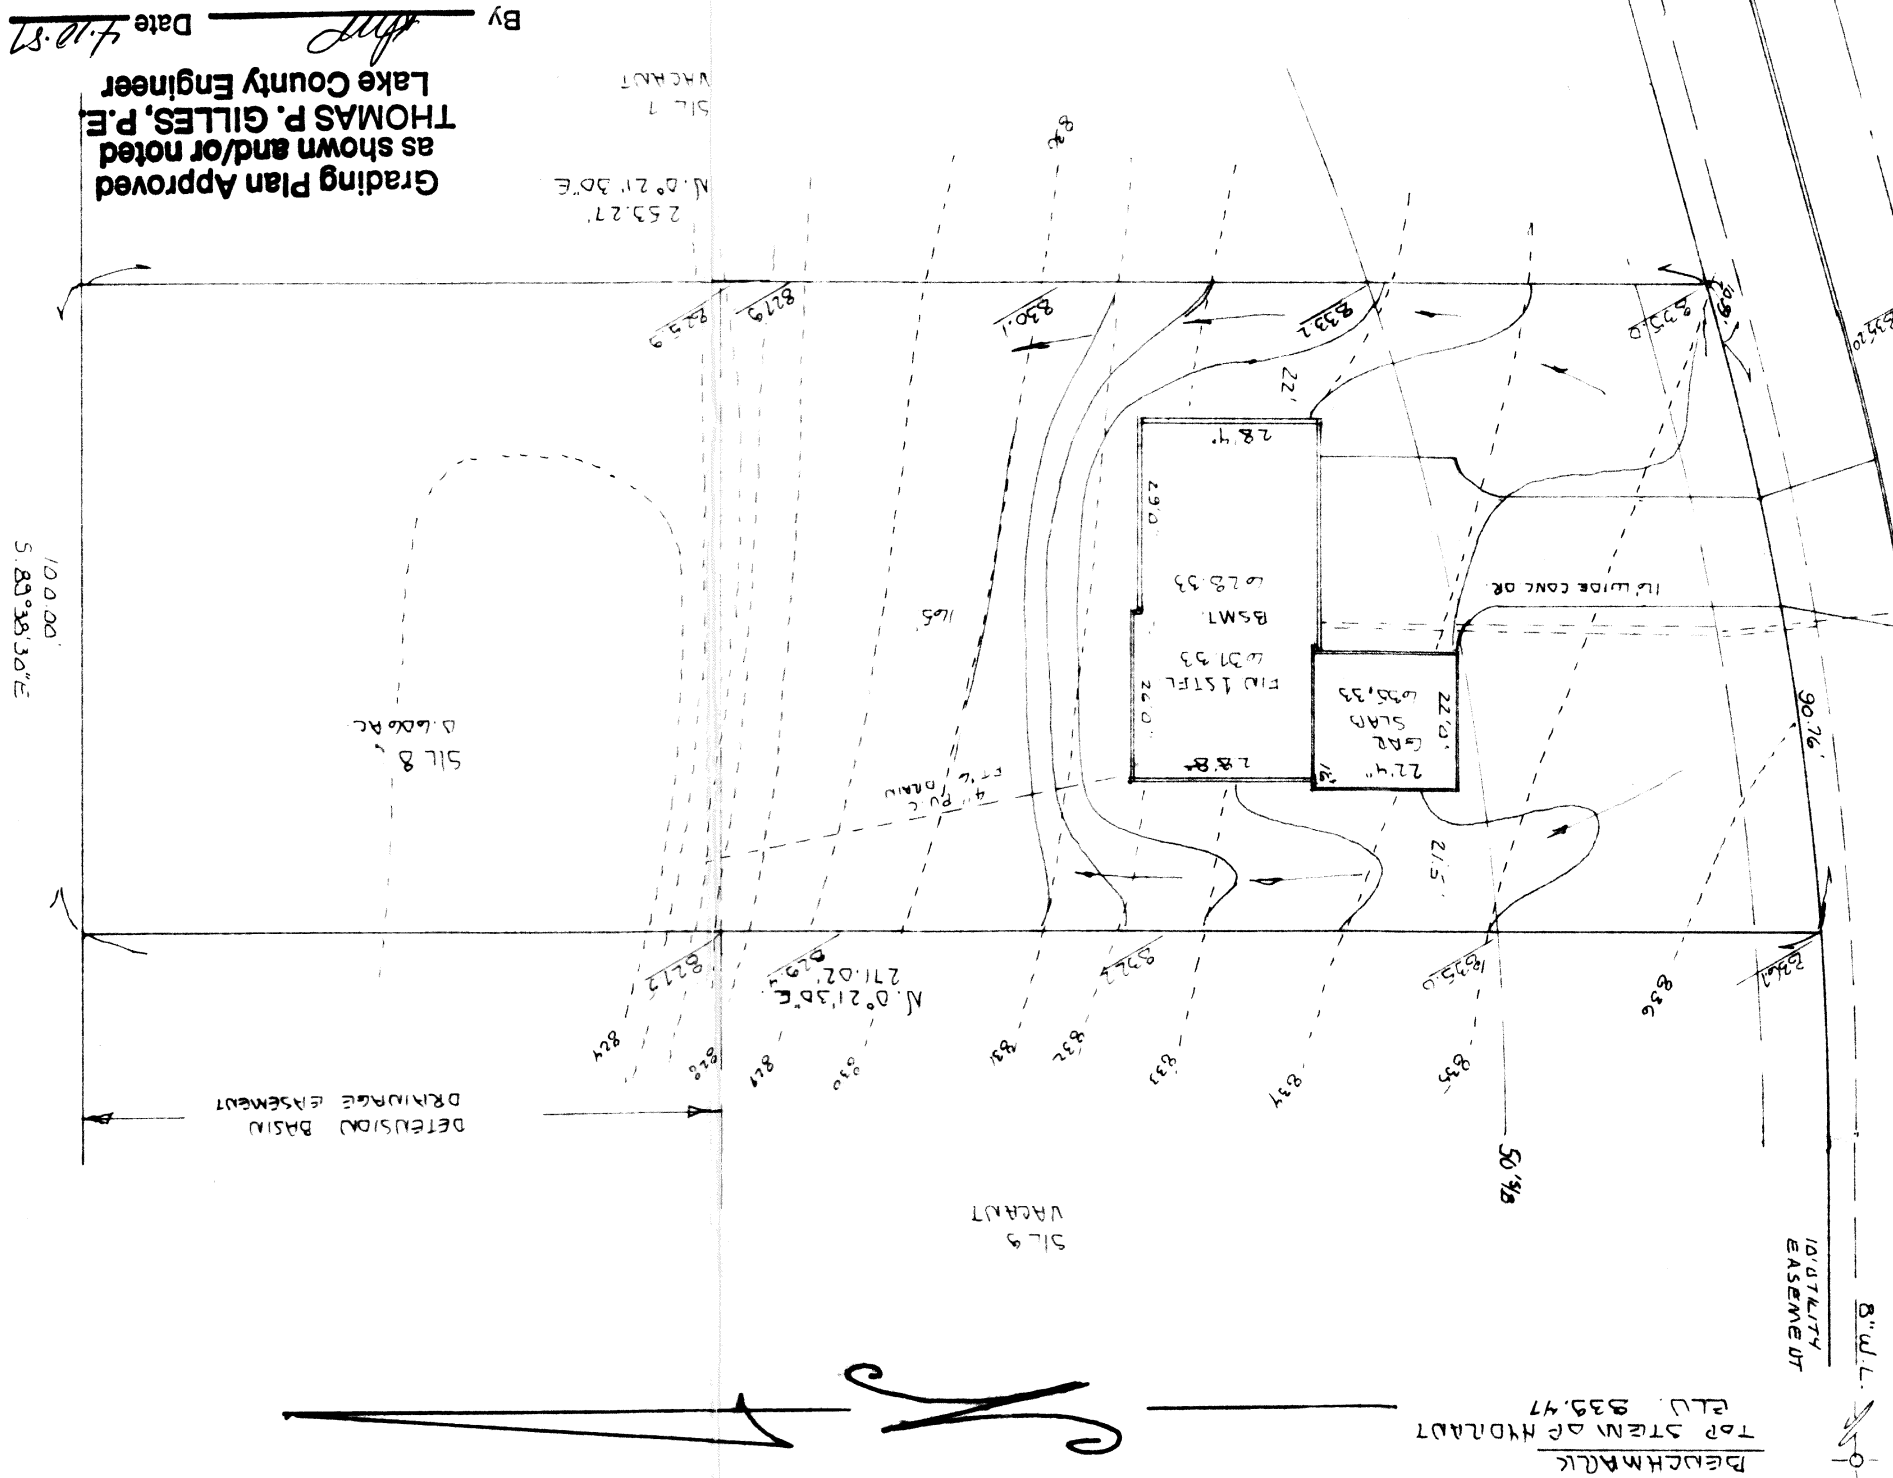

Grading Plan Approved
as shown and/or noted
THOMAS P. GILLES, P.E.
Lake County Engineer

By Date 4.10.57

EXISTING
PROPOSED

108 NO. 87 - 60

87-594

DRAWING NUMBER

Leu J. Maars

28-5-17
694-5*

PH 35277A2

WESTVILLE, OHIO 44077

7-59 ALL INFORMATION ON

JOHN C. SKOJNIECZNY

20-00000000

4-10-64 8032 10-13

the exchange of

1000

11/13/2009

40 15:49 341 10

AND MEETING

NOTED THIS PLAN