

SUBLOT 32

2196 MENTOR AVE. PAINESVILLE, OHIO

[illegible]


30 SOUTHAMPTON HILLS 10-12
SUBJECT No. SUBDIVISION NAME VOL. PAGE
Concord OHIO

LOT, TRACT ~~000000~~/TOWNSHIP

THE NORTH COASTTM ENGINEERING AND SURVEYING CO., INC.
2570 SUPERIOR AVE., SUITE 501
CLEVELAND, OHIO 44114
TEL. (216) 241-7070 FAX (216) 241-7071

LOT DIMENSIONS & BEARINGS
TO NEAREST STREET
SUBLOT NO. (PACEL No.)
SURROUNDING OWNERS
BUILDING DIMENSIONS
BLACK SHEET, REARYARD
DIMENSIONS
DIME, CARPORT TYPE, WIDTH, THICKNESS
SPERVAL TYPE, DIA, LENGTH
CULVERT TYPE, DIA, LENGTH
WATER MAIN SIZE, LOCATION
SAN. SEWER SIZE, GRADE, LOCATION
SAN. MAIN SIZE, GRADE, LOCATION
STORM SEWER SIZE, GRADE, LOCATION
SEWER SIZE, GRADE, LOCATION
PLAYED TYPE, SIZE, DIMENS
BASE LINE LOCATION
WELL LOCATION & RADIATION RADIUS
WELL SYSTEM & DUPLICATION

STATE SEAL

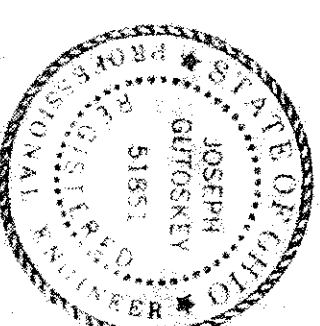

THIS PLAT WAS PREPARED BY ME, AND IS CORRECT
TO THE BEST OF MY KNOWLEDGE.

TO THE BEST OF MY KNOWLEDGE.

NAME _____


DATE _____

I HEREBY CERTIFY THAT THE CIRCLED INFORMATION IS EXISTING
AS OBTAINED ON THE SITE 19 AND IS
CORRECT TO THE BEST OF MY KNOWLEDGE AND BELIEF.

NAME	
DRAWN BY	SCALE
REV. <i>BF</i>	1" = 20'
CHG. BY	DATE
<i>JC</i>	11/91

BENCHMARK: SALTATORY HANDBOLE BETWEEN
SL30 AND SL31, RIM ELEV. = 8477.78

== DRAWING NO. 710244 MARGEE PRODUCT

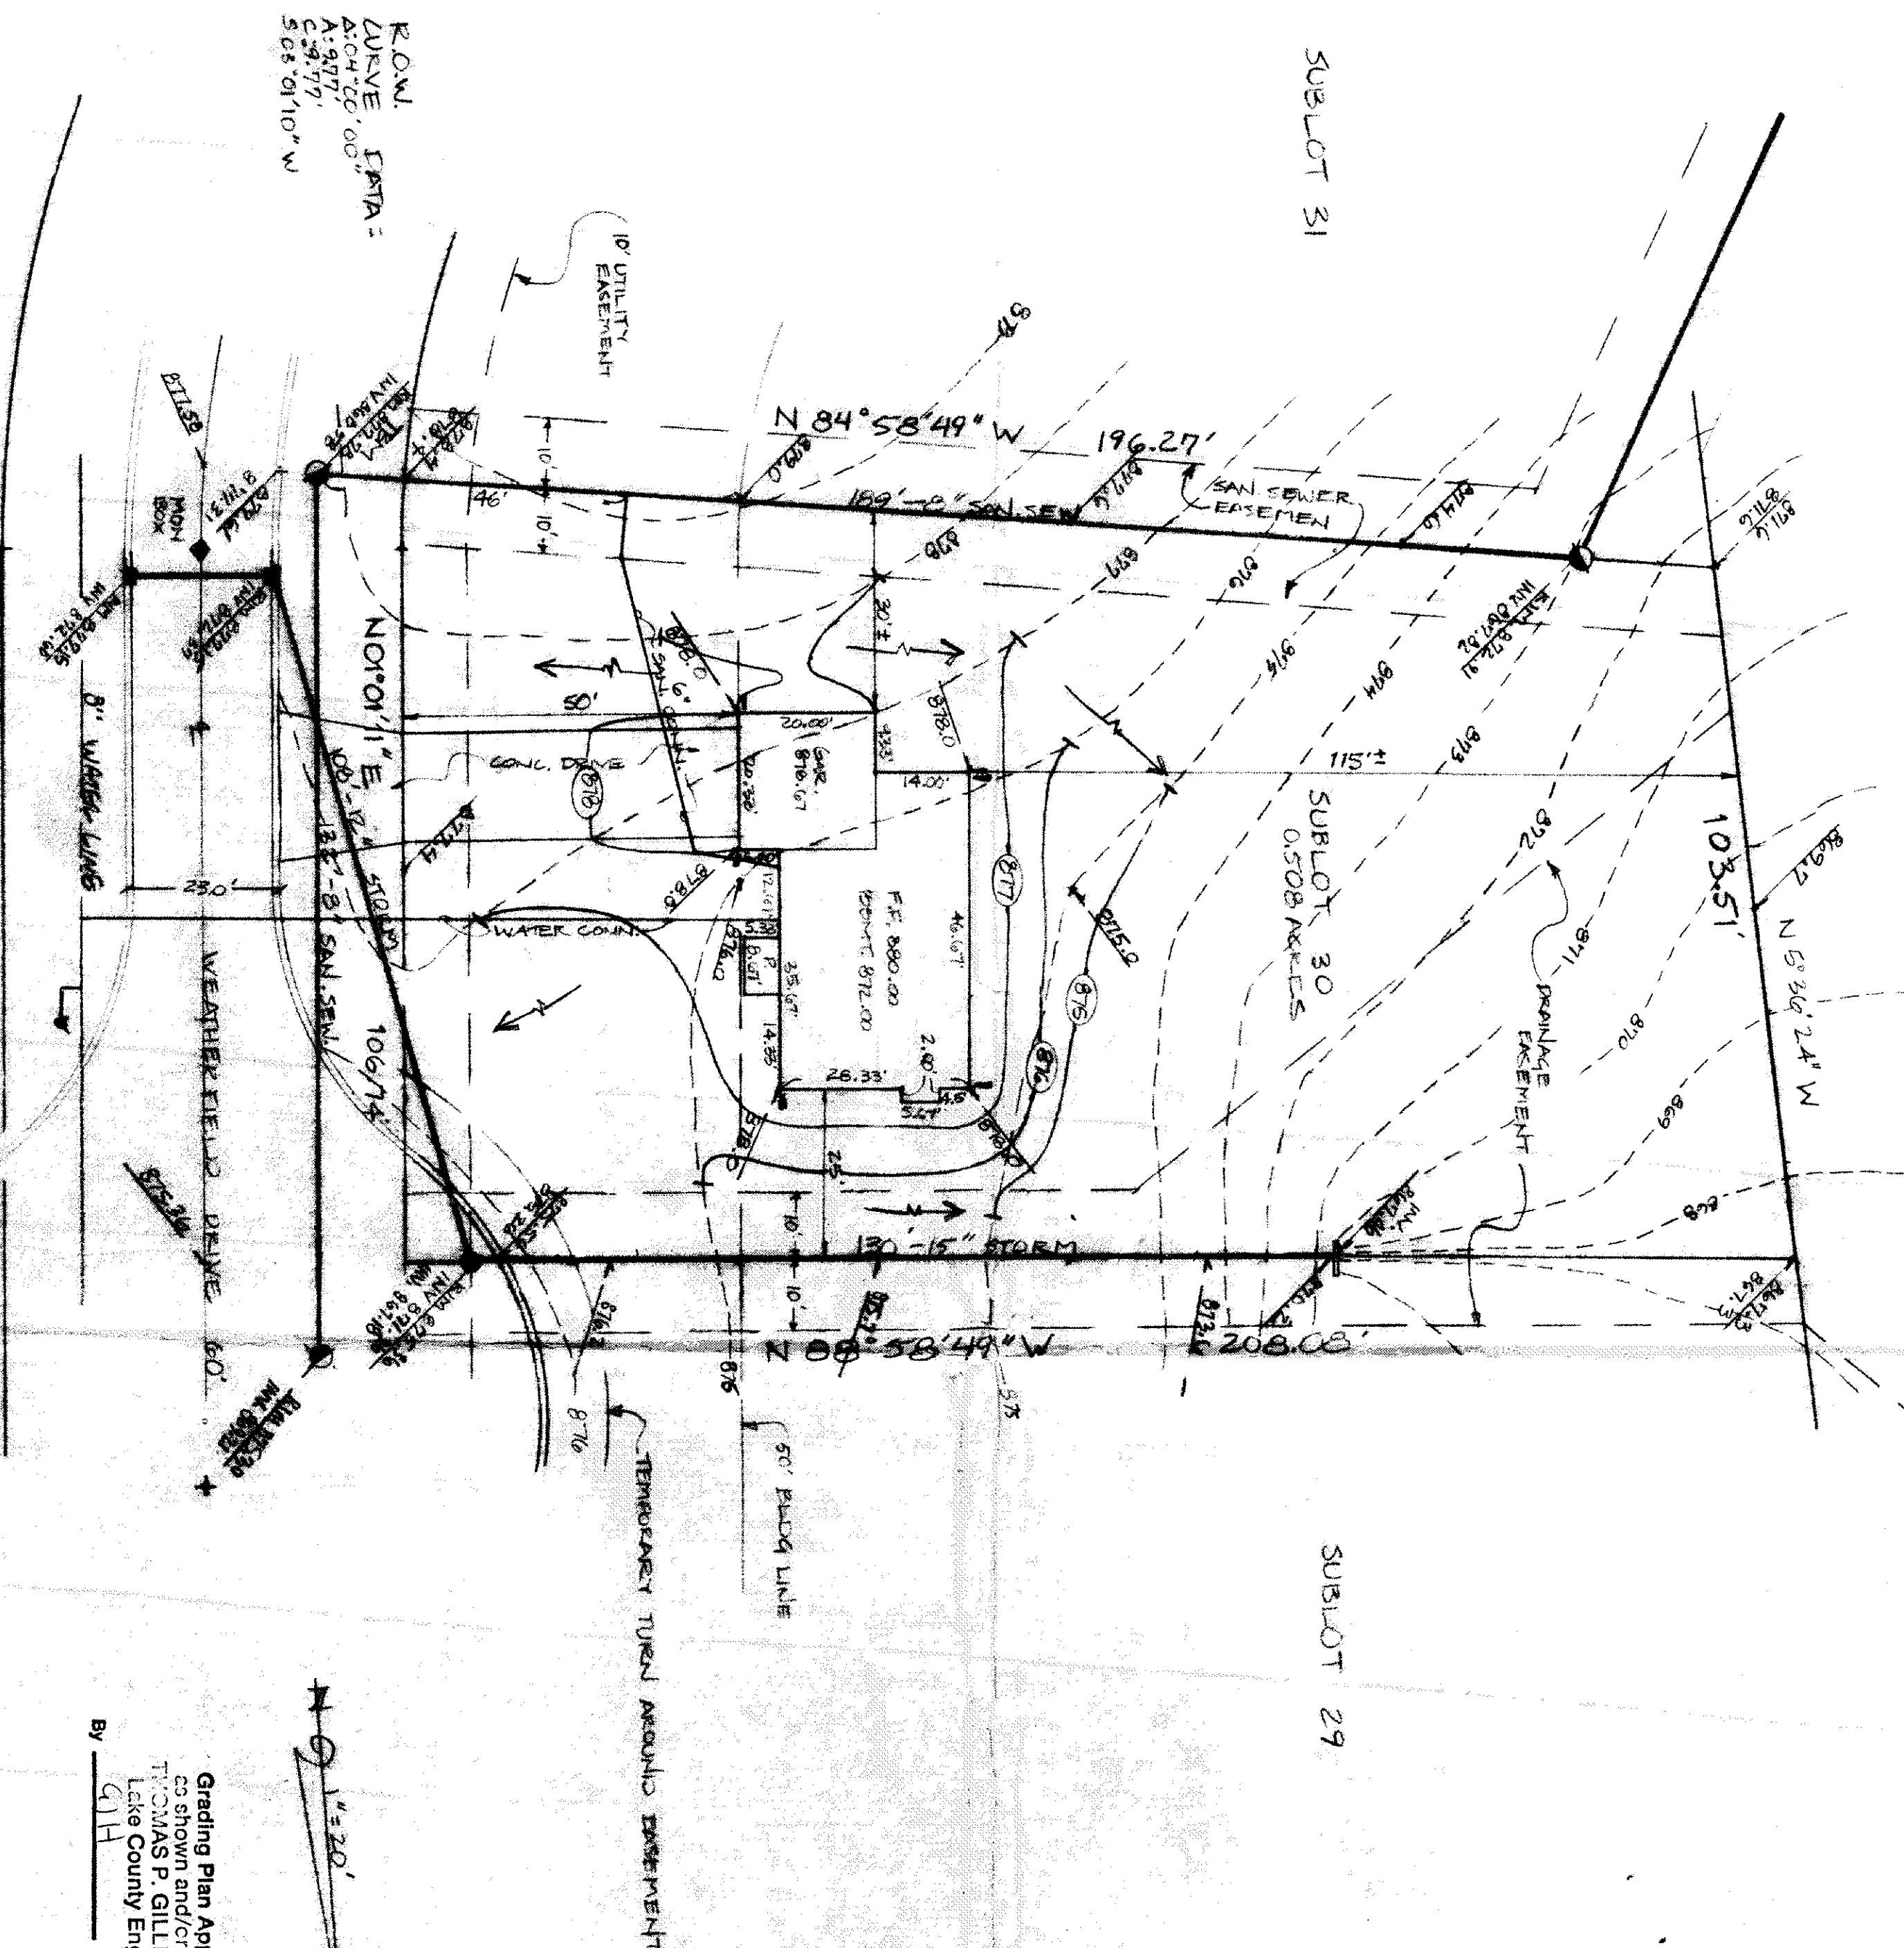

Grading Plan Approved
as shown and/or noted
TOMMAS P. GILLES, P.E.
Lake County Engineer
By Date 12/10/9

By G J H Date 12/10/9

Date 12
$$\begin{array}{r} 12 \\ 10 \\ 9 \end{array}$$

ZONING PERMIT. # 7009
ISSUED 11-21-91

SUBJECT TO APPROVAL BY:

Lake County Sanitary Eng.

☒ Lake County Eng. Dept.

Lake County Planning Comm

☒ Lake County Bldg. Dept.

**2 WORKING DAYS
BEFORE YOU DIG**

CALL TOLL FREE 800-362-2764

CONTRACT NO.

91-310