


CURVE DATA
 A = 74.13'
 Δ = 74.13'
 Δ = 10° 31' 40"
 L = 704.33'
 BR = N. 71° 42' 40" W.

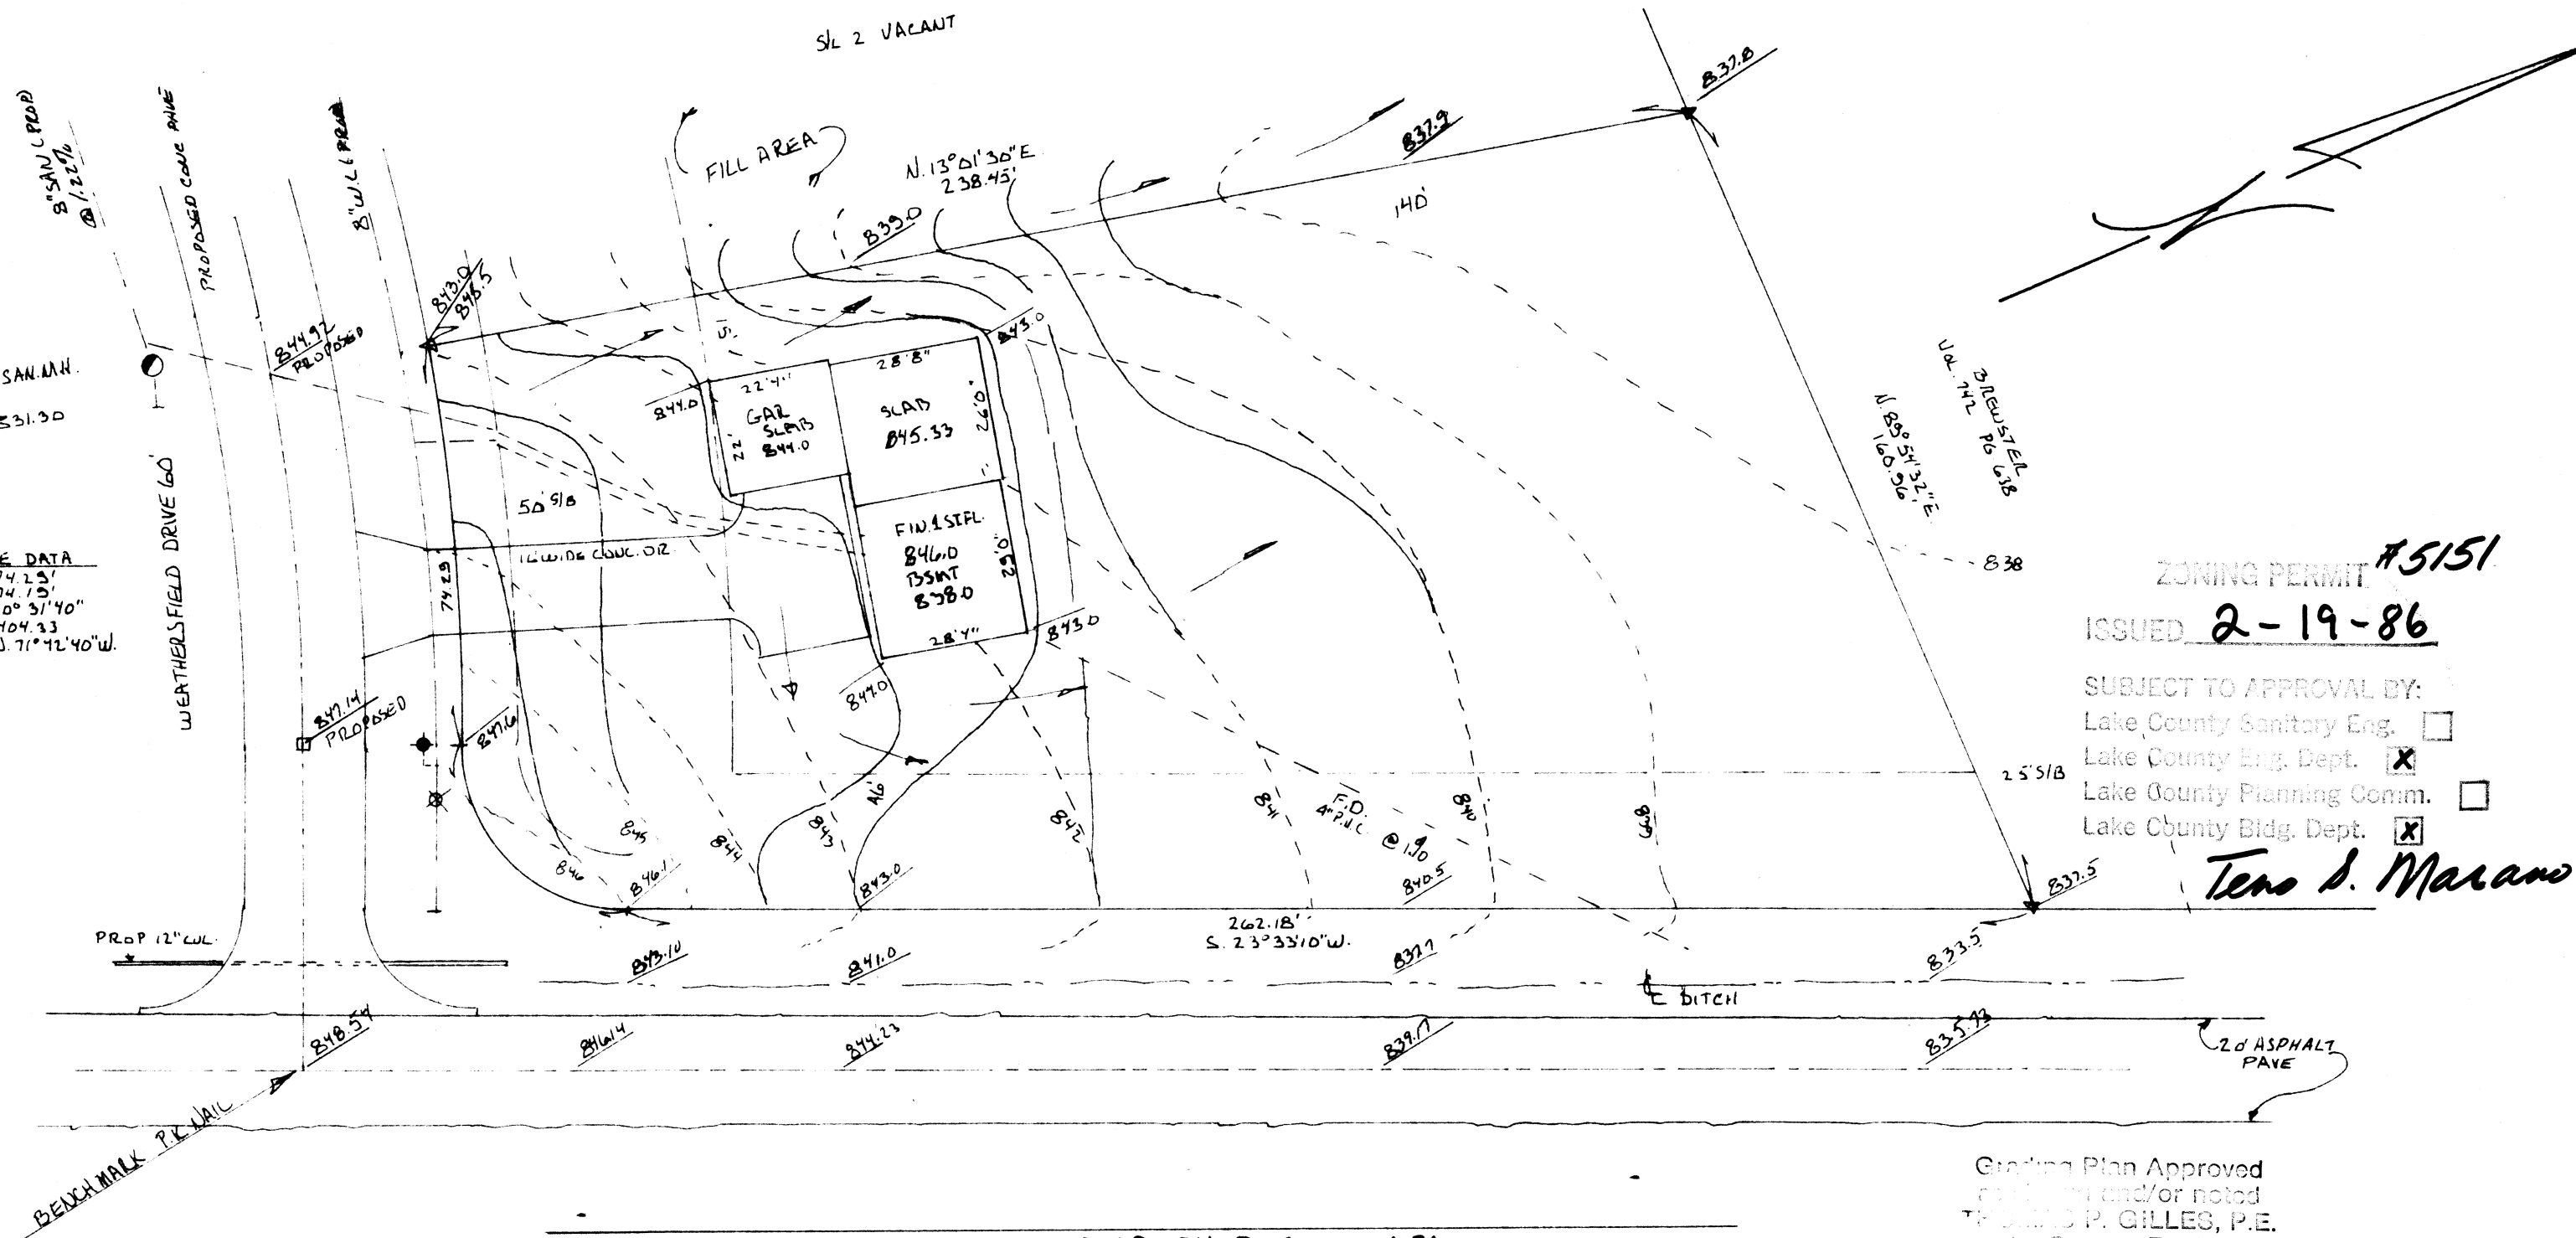

ZONING PERMIT #5151
 ISSUED 2-19-86

SUBJECT TO APPROVAL BY:
 Lake County Sanitary Eng. ☐
 Lake County Eng. Dept. ☒
 Lake County Planning Comm. ☐
 Lake County Bldg. Dept. ☒

Teno S. Marano

Grading Plan Approved
 and/or noted
 THOMAS P. GILLES, P.E.
 Lake County Engineer

By *AMP* Date 2-19-86

MORLEY ROAD 60' R/W

EXISTING GRADES
 PROPOSED GRADES
 SWALE

I CERTIFY THAT THIS PLAN
 WAS PREPARED BY ME AND
 IS CORRECT TO THE BEST OF
 MY KNOWLEDGE AND BELIEF.

John C. Skonieczny
 REG. SURVEYOR #6367
 JOHN C. SKONIECZNY
 7733 VIEWMOUNT DR.
 PAINESVILLE OHIO
 44077
 PH 352-7742

SITE PLAN 50' IDEAL AMERICAN HOMES		
SCALE: 1" = 30'	APPROVED BY	DRAWN BY J.C.S.
DATE: FEB 86		PLAT 42-1
BEING 5/1 IN THE WEATHERSFIELD SUBDIVISION		
TOWNSHIP OF CONCORD COUNTY OF LAKE STATE OF OHIO		
JOB # I.A.H. 86-006		DRAWING NUMBER 86-526