

SITE PLAN

Coland Toulster, Lake County, Ohio

for: Kay Jones

1221 Summerside Dr Coland

OWNER	NAME	LOT	TRACT
CLIENT	NAME	VOLUME	PAGE
ADDRESS	STREET	PERMIT PAVEMENT NO.	STREET
CITY	ZIP		

LEGEND

SANITARY MANHOLE	WATER VALVE (GAS)
STORM MANHOLE	WATER METER (GAS)
INLET OR CATCH BASIN	AS BUILT ELEVATION
HYDRANT	INDICATES DIRECTION OF SURFACE DRAINAGE
EXISTING CONTOURS	
PROPOSED CONTOURS	
EXIST. ELEV.	PROP. ELEV.

REMARKS

ALL BOUNDARY DATA SHOWN WAS OBTAINED FROM (DEEDS, RECORDED SUBDIVISION PLAT OR OTHER PUBLIC RECORDS)
LOCATIONS AS SHOWN OF ADJACENT WELLS AND SEPTIC TANKS OBTAINED FROM LAKE COUNTY HEALTH DEPARTMENT

DESIGN CERTIFICATION

THIS PLAT WAS PREPARED BY ME, AND IS CORRECT TO THE BEST OF MY KNOWLEDGE AND BELIEF.

NAME Harry S. Jones, Jr. SURVEYOR REGISTRATION NO. 86343

CHECK LIST

NO. OF BEDROOMS	WATER MAIN SIZE, LOCATION
DIMENSIONS	SAN. SEWER SIZE, LOC. INV. ELEV.
BEARINGS	SAN. MAN. CAST. ELEV. INV. ELEV.
TIE TO NEAREST STREET	SAN. CORR. SIZE, LOC. DEPTH
SUBLOT NO. PARCEL NO.	STORM SEWER SIZE, G.P. LOC.
ADJACENT OWNERS	STORM MAN. CAST. ELEV. ELEV.
BLDG. DIMENSIONS FIN. GR.	BLDG. TYPE, THICKNESS
BLDG. TYPE, THICKNESS	BLDG. TYPE, THICKNESS
BLDG. TYPE, THICKNESS	BLDG. TYPE, THICKNESS
BLDG. TYPE, THICKNESS	BLDG. TYPE, THICKNESS
BLDG. TYPE, THICKNESS	BLDG. TYPE, THICKNESS

PLAN PREPARED BY:

BABCOCK • JONES & ASSOCIATES, INC.

PAINESVILLE, OHIO

NO.	DATE	BY
1		
2		
3		
4		
5		

"AS BUILT" CERTIFICATION

I, HEREBY CERTIFY THAT THE CIRCLED GRADES ARE EXISTING FINISH GRADES CHECKED IN THE FIELD ON 3-17-88, 1988 AND ARE CORRECT TO THE BEST OF MY KNOWLEDGE AND BELIEF.

REGISTERED SURVEYOR

REG. NO.


T.B.M. - Lim Still M.H. - sk 42

ET 201 - 838.22

#5729

3-17-88

Town of Marion

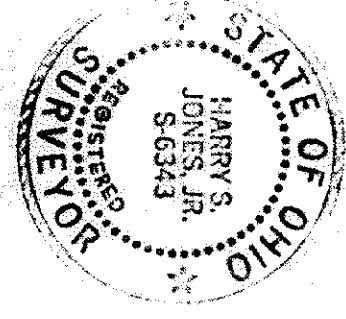

Grading Plan Approved
Date 3/18/88

