

SITE PLAN

CONCORD TWP., LAKE COUNTY, OHIO

for: E. L. MOORE HOMES
 CLIENT OWNER

ADDRESS	STREET	CITY	ZIP
1234	0		

NEWPORT HILLS SUBDIVISION
SUBDIVISION 16-40 NAME
8 VOL. - PG. WELLESLEY BLVD
SUBLOT NO. STREET

LOT	TRACT
VOLUME	PAGE
PERM. PARCEL NO.	STREET

LEGEND

SANITARY	MANHOLE
STORM	MANHOLE
INLET OR CATCH BASIN	
HYDRANT	-----
EXISTING CONTOURS	
PROPOSED CONTOURS	
EXIST. ELEV.	100.00
	100.00

WATER VALVE (GAS) ---
 WATER METER (GAS) ---
 AS BUILT ELEVATION ---
 INDICATES ---
 DIRECTION OF ---
 SURFACE DRAINAGE ---

REMARKS


ALL BOUNDARY DATA SHOWN WAS OBTAINED FROM (DEEDS, RECORDED SUBDIVISION PLAT OR OTHER PUBLIC RECORDS)

LOCATIONS AS SHOWN OF ADJACENT WELLS AND SEPTIC TANKS OBTAINED FROM LAKE COUNTY HEALTH DEPARTMENT

DESIGN CERTIFICATION

THIS PLAY WAS PREPARED BY ME, AND IS CORRECT
TO THE BEST OF MY KNOWLEDGE AND BELIEF

NAME	SURVEYOR	REGISTRATION	NO

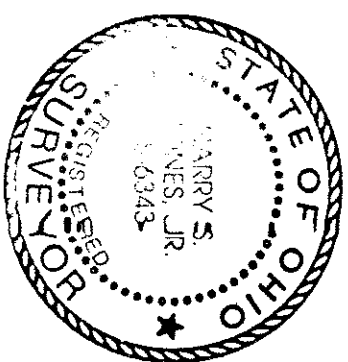

CHECK LIST

NO. OF BEDROOMS	WATER MAIN SIZE	LOCATION
DIMENSIONS	SAN, SINKER SIZE <th>% GR. LOC.</th>	% GR. LOC.
BEARINGS	SAN, MH. CAST ELEV. <th>INV. ELEV.</th>	INV. ELEV.
TIE TO NEAREST STREET	SAN, COIN. SIZE <th>LOC. DEPTH</th>	LOC. DEPTH
SUBLOT NO. PARCEL NO.	STORM SEWER <th>CAST ELEV. % GR. LOC.</th>	CAST ELEV. % GR. LOC.
SURROUNDING OWNERS	STORM, TYPE <th>CAST ELEV. INV. ELEV.</th>	CAST ELEV. INV. ELEV.
BLDG. DIMENSIONS FIN. GR.	PART TYPE GRADE CURS	
BLDG. TIES FLR. GR.	GAS LINE LOC. SIZE	PRESSURE
ARROW TYPE WIDTH THICKNESS	SEWIC TANK <th>LOCATION & DUPL. LOCATION AREA</th>	LOCATION & DUPL. LOCATION AREA
SIDEWALK TYPE WIDTH THICKNESS	WELL LOCATION	
CULVERT TYPE DIA. LENGTH	ISOLATION RADIUS FROM WELL	
ROCK OUTCROPPINGS		

REVISIONS	PLAN PREPARED BY:

DATE	BY	BABCOCK • JONES & ASSOCIATES, INC.
------	----	------------------------------------

	PAINESVILLE, OHIO
--	-------------------

PHONE NO.	357-1811
SCALE	1" = 30'
DRAWN BY	Φ

CHK'D.	DATE	DRAWING NO.
<i>[Signature]</i>	12-23-93	01-200-00

CREW CHIEF	✓	APPROD.	✓
------------	---	---------	---

“AS BUILT” CERTIFICATION

I, HEREBY CERTIFY THAT THE CIRCLED GRADES ARE EXISTING
FINISH GRADES CHECKED IN THE FIELD ON 19,
AND ARE CORRECT TO THE BEST OF MY KNOWLEDGE AND BELIEF.

REGISTERED SURVEYOR REG. NO.

BENCHMARK: SAN MH 5/L11, RIM ELEV. = 723.34

THOMAS H. CHAPMAN
Mechanical Engineer
CH

1.4-9d
Date
6/11
By

SWALE AS SHOWN

ZONING PERMIT

ISSUED 12-29-93

SUBJECT TO APPROVAL BY:

Lake County Salary and County Eng Dept. ☒

Lake County Planning Comm.

Lake County Bldg. Dept.

ROOF DRAINS
SHALL DISCHARGE
TO SPLASH BLOCKS.