


$R = 897.75 \Delta 4^{\circ} 18' 33'' A = 67.52 C = 67.50 N 16^{\circ} 39' 46''$
 $R = 30.00 \Delta = 47^{\circ} 20' 58'' A = 24.79 C = 24.09 N 4^{\circ} 51' 26''$
 $R = 62.50 \Delta = 50^{\circ} 10' 12'' A = 54.73 C = 53.00 N 3^{\circ} 26' 49'' W$

LITTLE MOUNTAIN PARK ESTATES NO. 2
VPL. D PG. 47

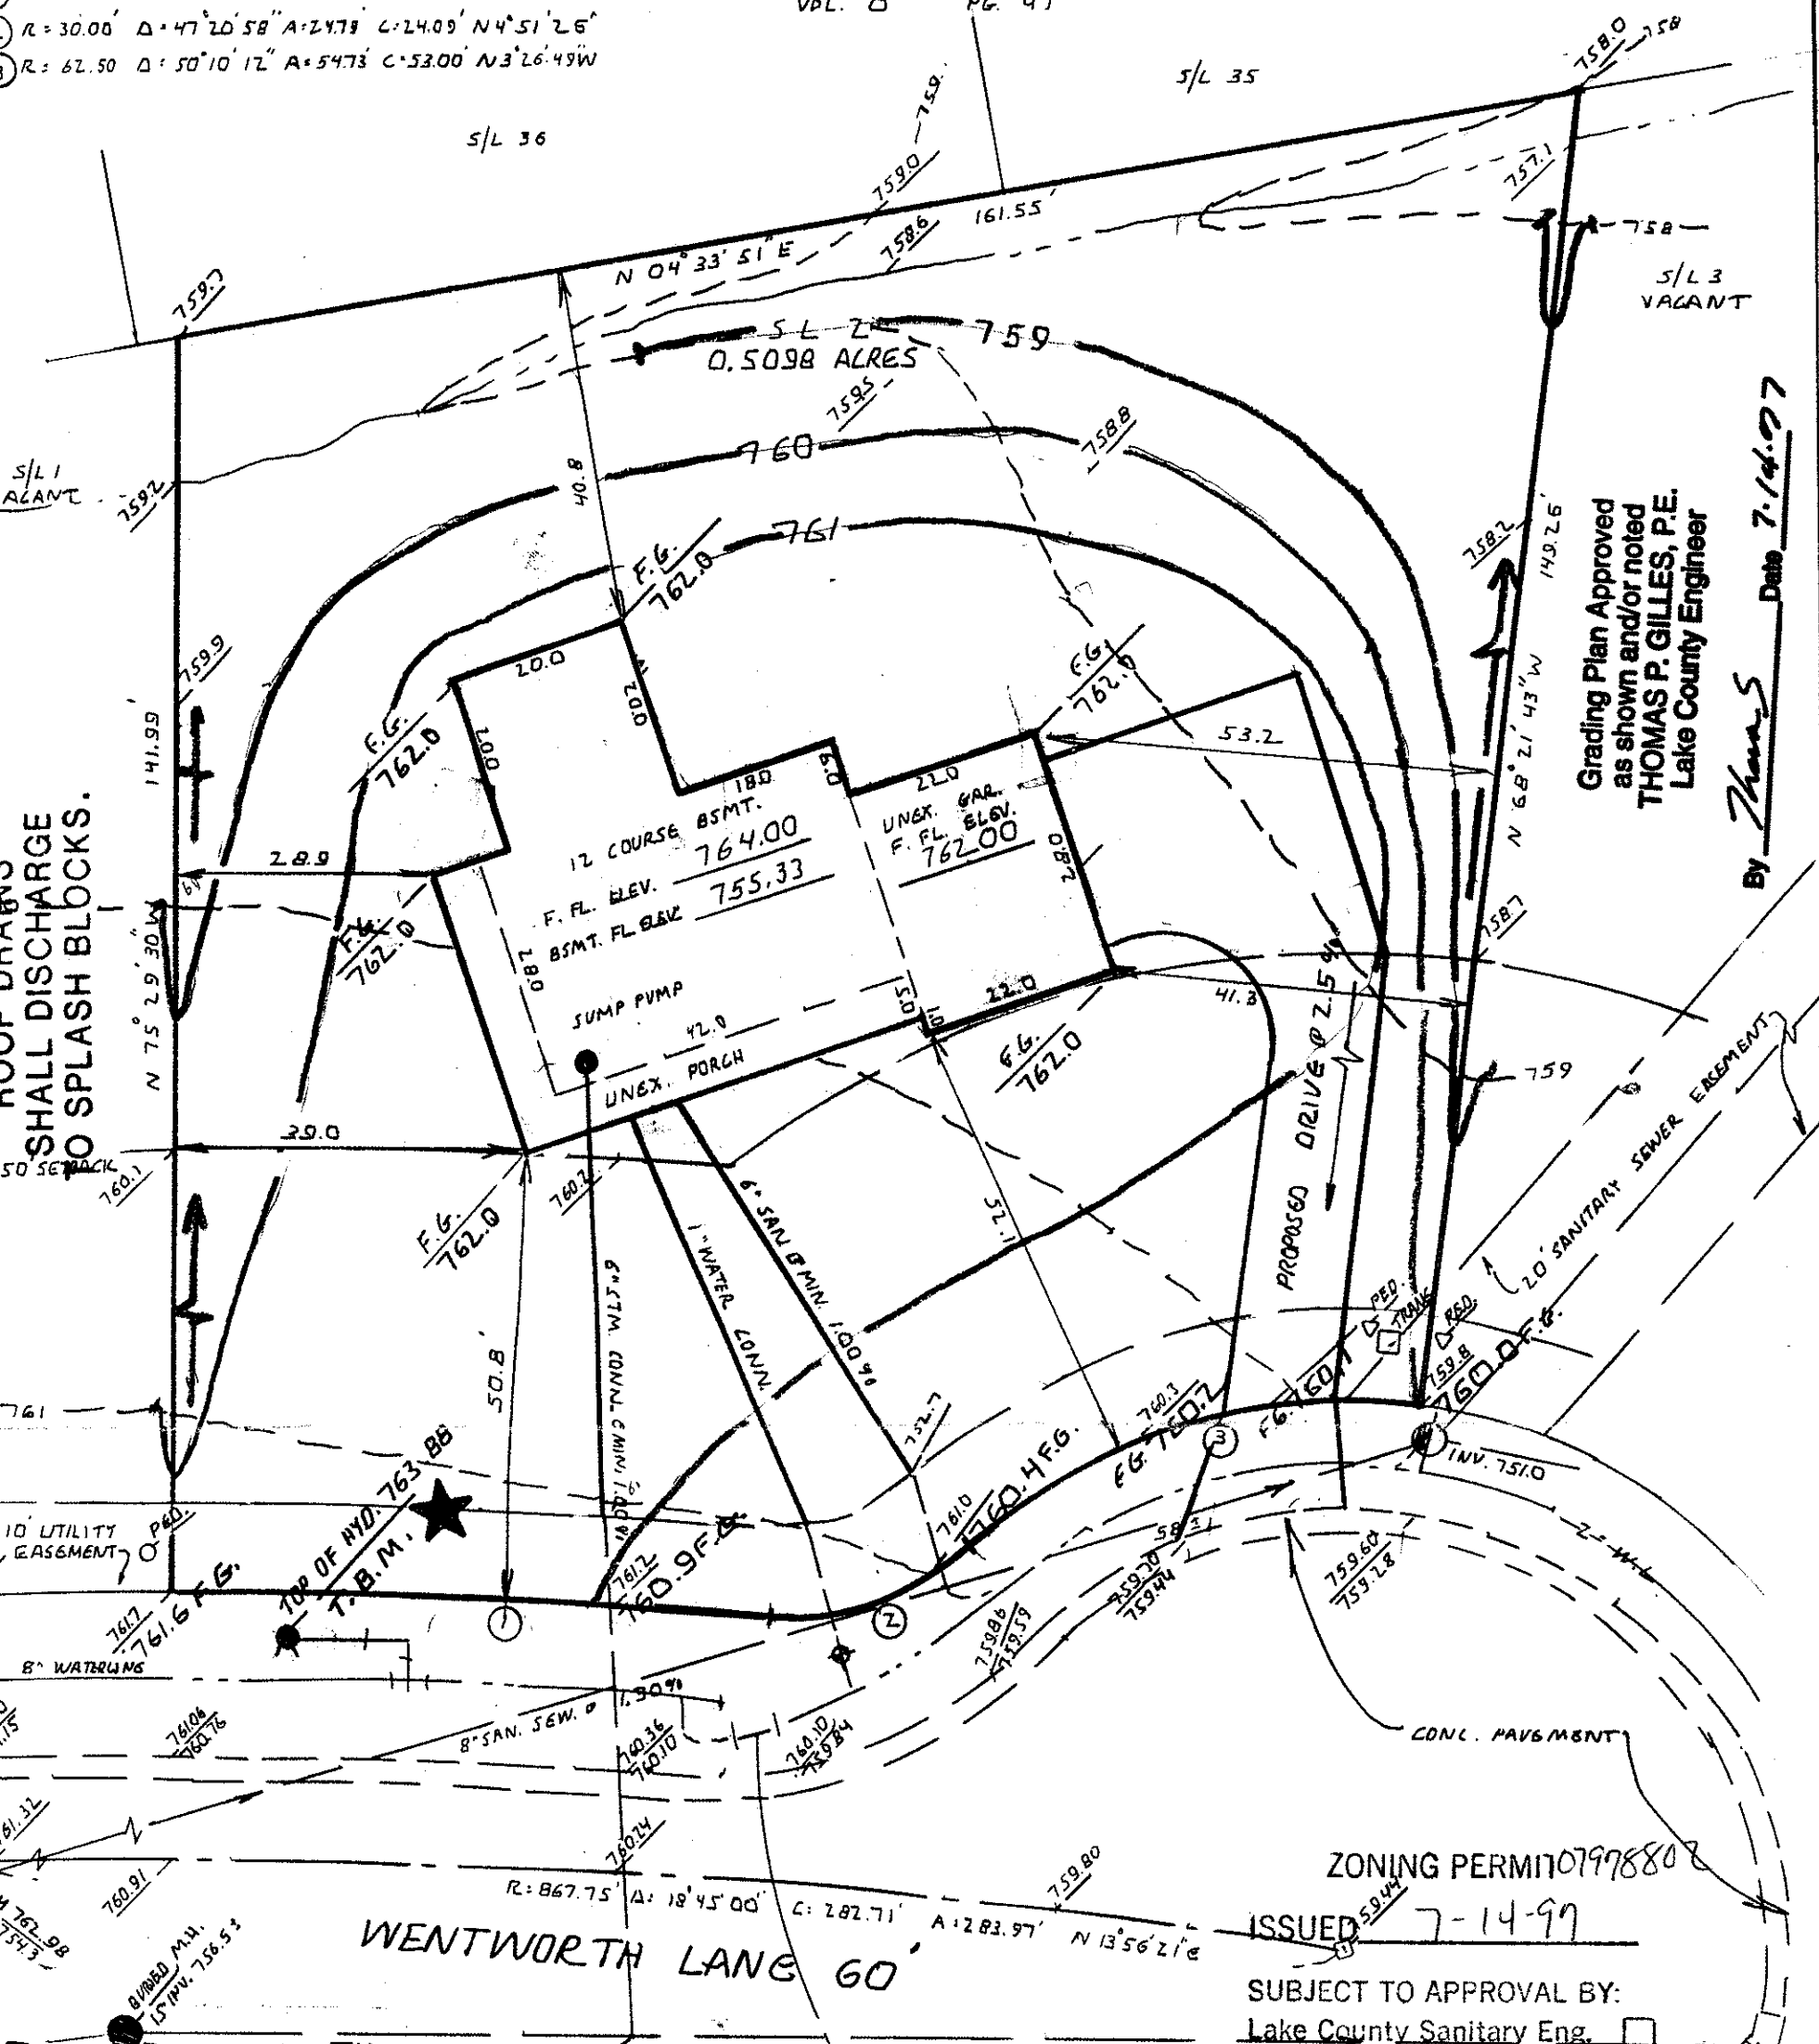

ROOF DRAINAGE
 SHALL DISCHARGE
 TO SPLASH BLOCKS.

Grading Plan Approved
 as shown and/or noted
 THOMAS P. GILLES, P.E.
 Lake County Engineer

By Thomas P. Gilles Date 7-14-97

ZONING PERMIT 107978808
 ISSUED 7-14-97

SUBJECT TO APPROVAL BY:
 Lake County Sanitary Eng. ☐
 Lake County Eng. Dept. ☒
 Lake County Planning Comm. ☐
 Lake County Bldg. Dept. ☐

**SITE PLAN
 FOR
 WATERFORD DESIGN HOMES, INC.
 SUBLOT NO. 2 WORTHINGTON HILLS**

I, the undersigned hereby certify that
 this topography, indicated by 6", 1"
 or 2' contours, and elevations shown
 hereon represent an actual field survey
 made by me on the 24 day of JUNE,
 1997 and that the elevations were taken
 at appropriate intervals and that as of
 that date they existed as indicated
 hereon.

SCALE 1" = 20'
 JUNE 24 1997
 0 5 10 20 30

Name RUDY E. SCHWARTZ Reg. No. 7193

DESIGN CERTIFICATION

This Plan was prepared by me, and is correct to the best of
 my knowledge and belief.

RUDY E. SCHWARTZ
 RUDY E. SCHWARTZ, P.S. NO. 7193

NOTES: SEE ARCHITECT'S PLAN FOR COMPLETE
 HOUSE DIMENSIONS.

Situated in the Township of Concord, County of
 Lake, and State of Ohio and known as being a part of
 Original Concord Township Lot No. 20, Tract No. 4.

PREPARED BY:
 RUDY E. SCHWARTZ
 PROFESSIONAL SURVEYOR
 15750 AUBURN ROAD
 NEWBURY, OHIO 44065
 (216)564-7528
 FAX: (216)564-5675

PREPARED FOR:
 WATERFORD DESIGN HOMES, INC.
 P.O. BOX 855
 CHARDON, OHIO 44024