

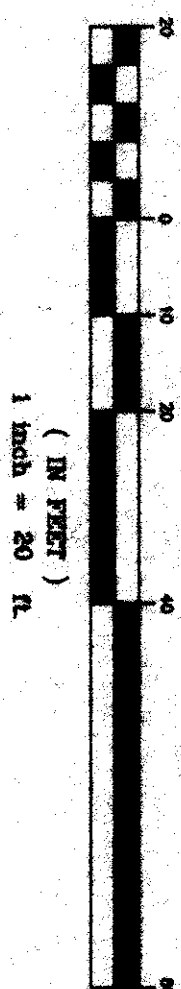


GRAPHIC SCALE

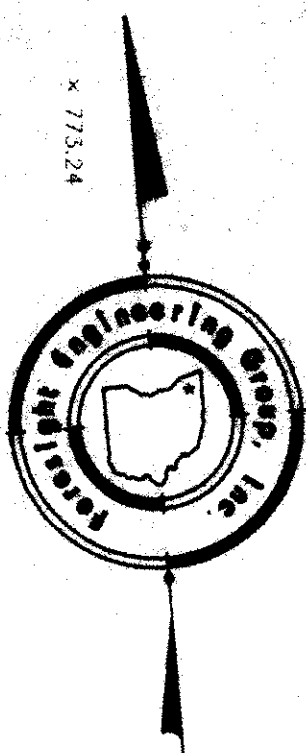

SYMBOL LEGEND	
	PK Nail Found
	Ex. Manhole
	Iron Pin Found
	Ex. Curb Inlet
	Ex. Fire Hydrant
	Ex. Tree (Size Noted)
	PK Nail Set
	Ex. Telephone
	Ex. Cable TV

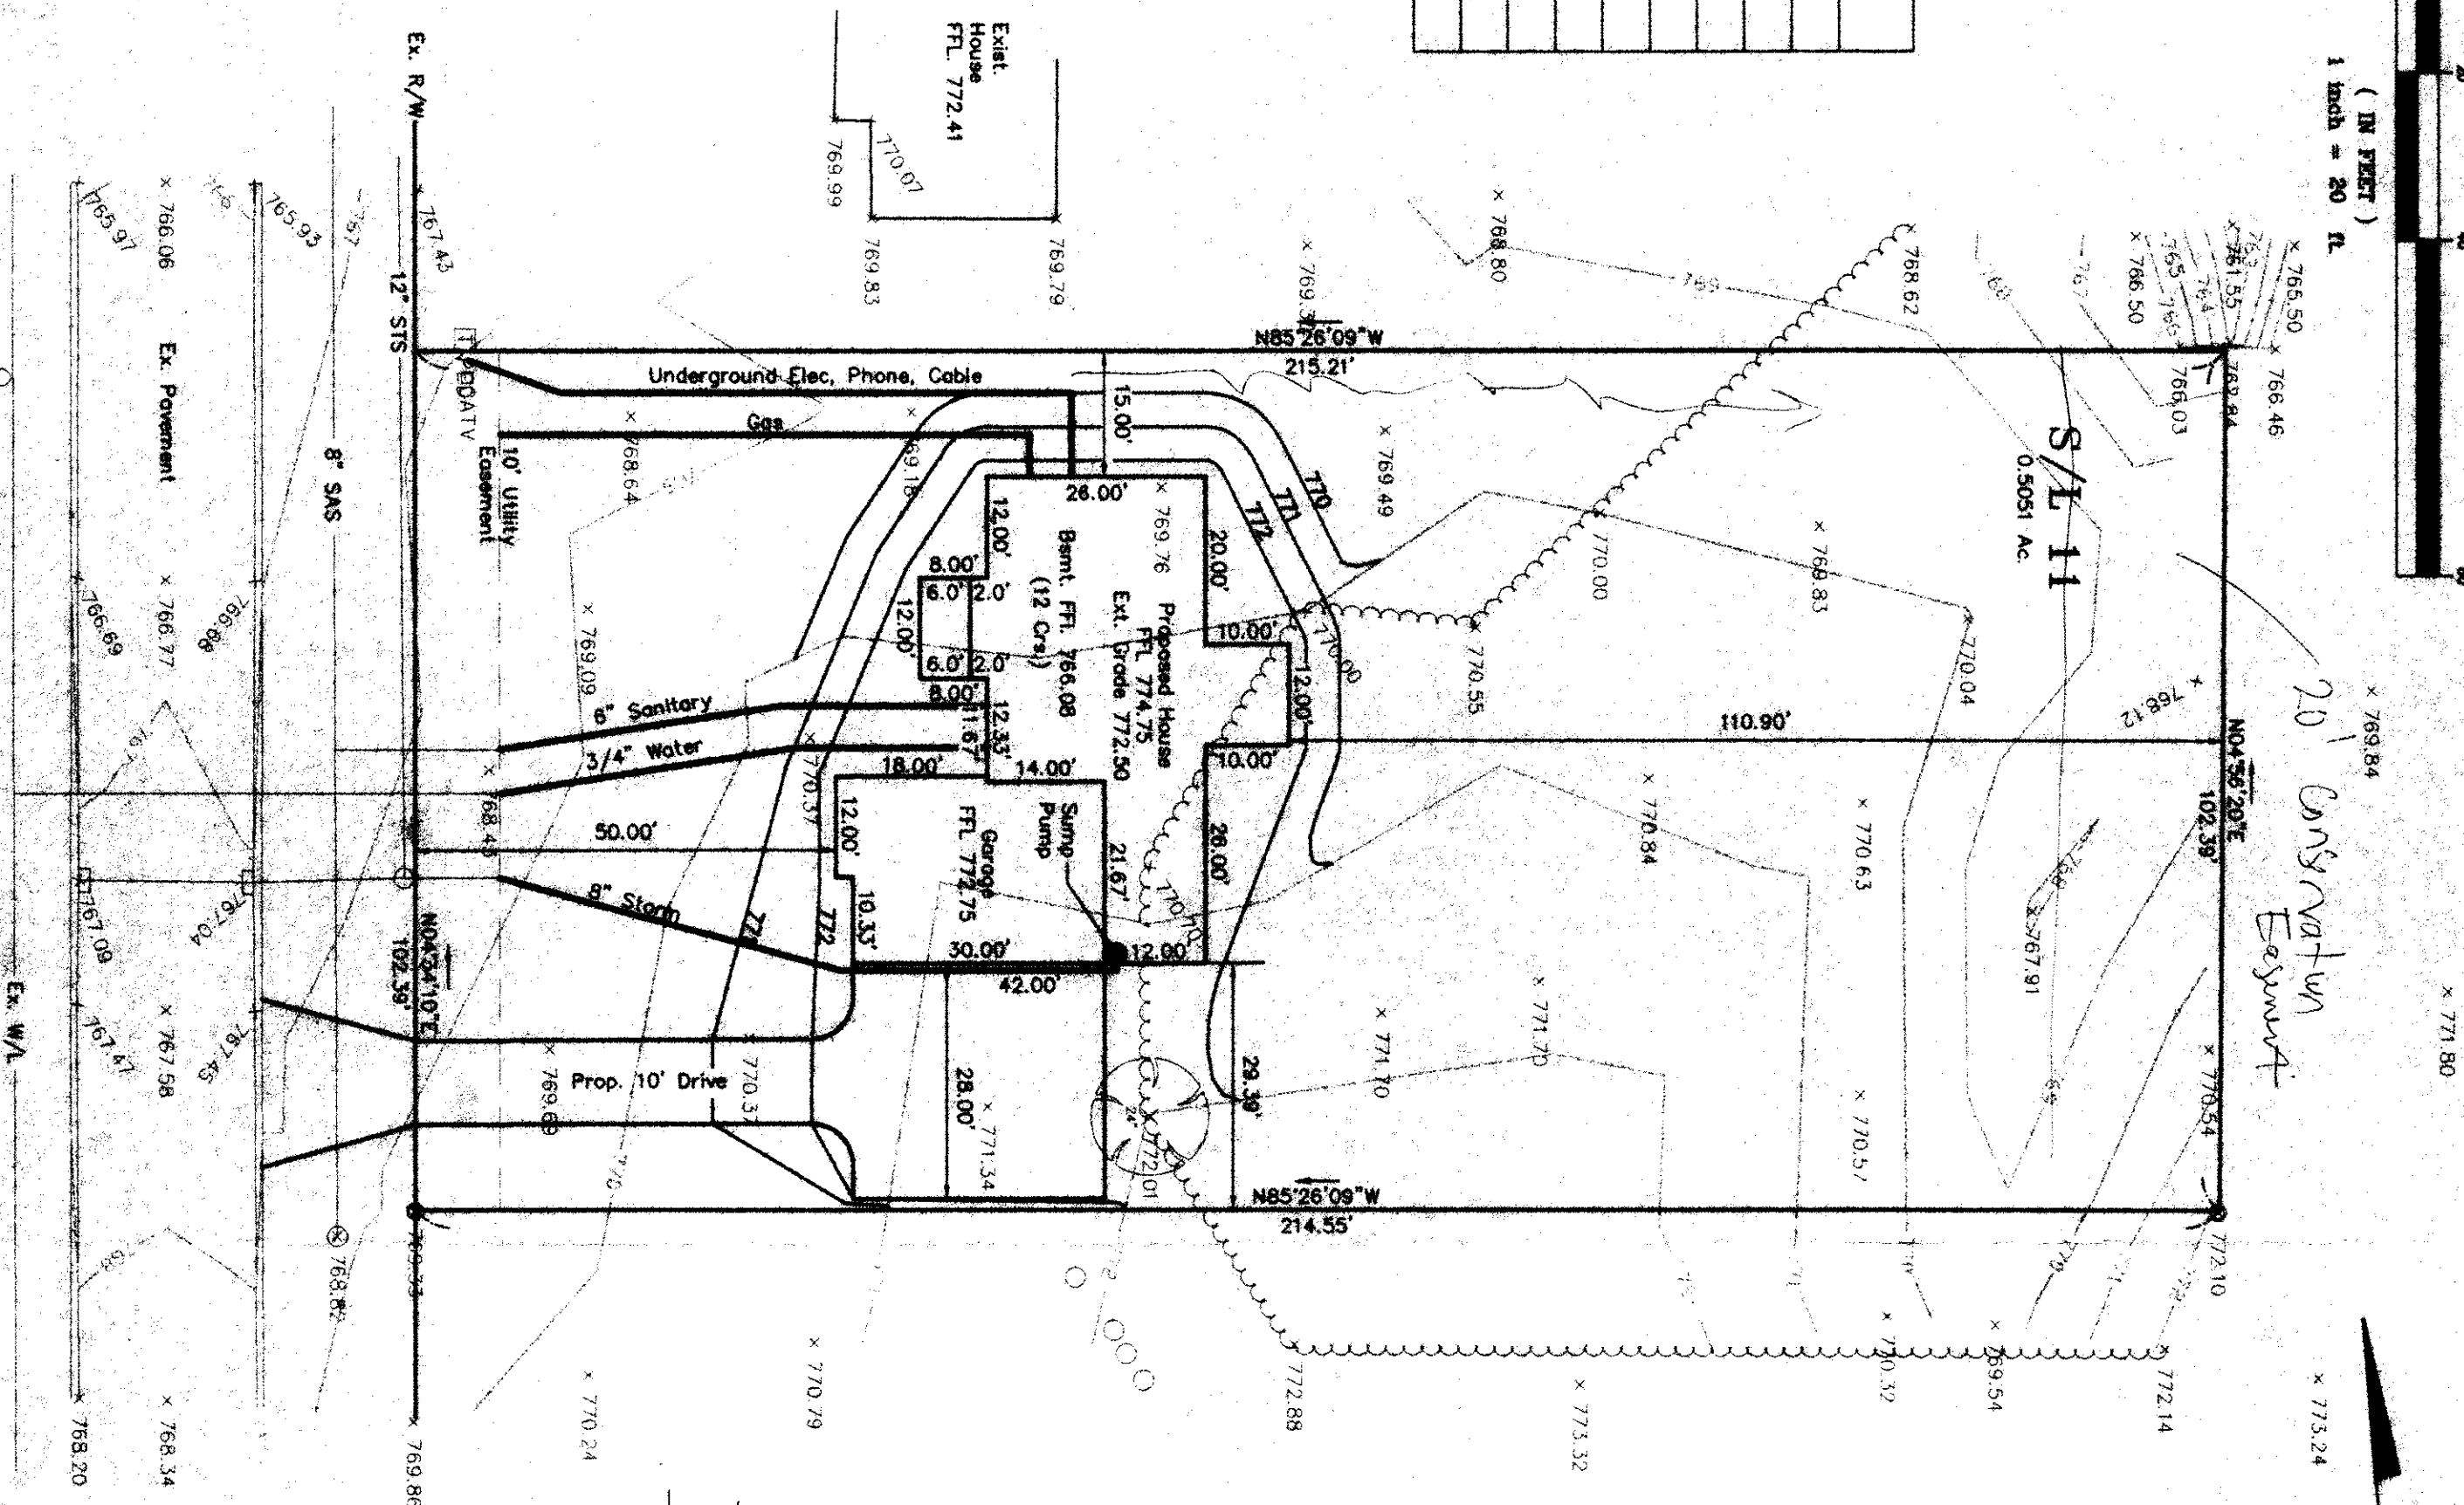

ROOF DRAINS
SHALL DISCHARGE
TO SPLASH BLOCKS.

Grading Plan Approved
as shown and/or noted
THOMAS P. GILLES, P.E.
Lake County Engineer

By 6/14 Date 12-8-97

20' Conservation Easement
Scale as shown

ZONING PERMIT 12978936

ISSUED 12-4-97

SUBJECT TO APPROVAL BY:

Lake County Engineer ☐
Lake County Eng. Dept. ☒
Lake County Planning Comm. ☐
Lake County Div. Dept. ☐

SITE PLAN

for: R.L. Moore Homes CLIENT
7121 Ravenna Rd. ADDRESS
Concord Oh 44077 CITY STATE ZIP

SUBJECT No. 11 TRACT Worthington Hills VOL. 24 PAGE 31
SUBDIVISION NAME Concord Twp. CITY Ohio STATE Ohio

Foresight Engineering Group

Engineers &
Surveyors

440 286-1010
440 286-1034 fax
320 Center Street, Unit F
Concord, Ohio 44024


DESIGN CERTIFICATION

This Site Plan was prepared by Foresight Engineering Group, Inc., and is correct to the best of my knowledge and belief.

6/14/97
NAME

CHECK LIST

LOT DIMENSIONS & BEARINGS
TIE TO NEAREST STREET
SUBJECT No. (PARCEL No.)
SURROUNDING OWNERS
BUILDING DIMENSIONS
SETBACK, SIDEYARD, REARYARD
FINISH GRADES
DRIVE & APRON TYPE, WIDTH, THICKNESS
SIDEWALK TYPE, WIDTH, THICKNESS
CHURCH TYPE, DIAL LENGTH
WATER MAIN SIZE, LOCATION
SAN. SEWER SIZE, GRADE, LOC.
SAN. MAN. GAST. ELEV., INV. ELEV.
SAN. DOWN. SIZE, GRADE, LOC.
STORM SEWER SIZE, GRADE, LOC.
STORM MAN. GAST. ELEV., INV. ELEV.
PAV'T TYPE, GRADE, CURBS
GAS LINE LOC., SIZE
SEPTIC SYSTEM & ISOLATION RADIUS
WELL LOCATION & ISOLATION RADIUS

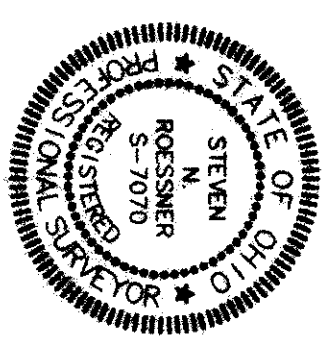

STATE SEAL

"AS BUILT" CERTIFICATION

I hereby certify that the circled information is existing as obtained on the site 19 and is correct to the best of my knowledge and belief.

NAME

SCALE: 1" = 20'


FILE NAME: 1:\Rim19721\SL11

DATE: December 2, 1997

BENCHMARK: Top of stem of fire hydrant in front of S/L 11 - El. 769.50

"I, the undersigned hereby certify that this topography, indicated by 6", 1" or 2" contours, and the elevations shown herein represent an actual field survey made by Foresight Engineering Group, Inc. on the 12th day of November 19 97 and that the elevations were taken at appropriate intervals and that as of that date they existed as indicated herein."

6/14/97
NAME

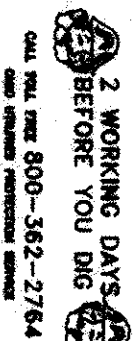

EXISTING UNDERGROUND UTILITIES NOTES:
The location both horizontal and vertical of the underground utilities shown herein, have been obtained by a diligent and comprehensive search of available records. Verification by field observation, has been conducted where practical. However, Foresight Engineering Group, Inc. does not guarantee the completeness nor accuracy thereof.

Wentworth Lane 60'

7105 Wentworth Ln.