

1. R: 89775' Δ 4'18"35" A: 6750' C: 6750' N: 6'39"46"
2. R: 3000' Δ: 47'20"58" A: 2479' C: 2409' N: 4'51"26"
3. R: 6250' Δ: 50'10"12" A: 5473' C: 5300' N: 3'26"49"W

LITTLE MOUNTAIN PARK ESTATES NO. 2
VPL. D PG. 47

S/L 35

S/L 36


S/L 3

VACANT

Grading Plan Approved
as shown and/or noted
THOMAS P. GILLES, P.E.
Lake County Engineer

By Thomas Date 7.14.97

ROOF DRAINS
SHALL DISCHARGE
TO SPLASH BLOCKS.

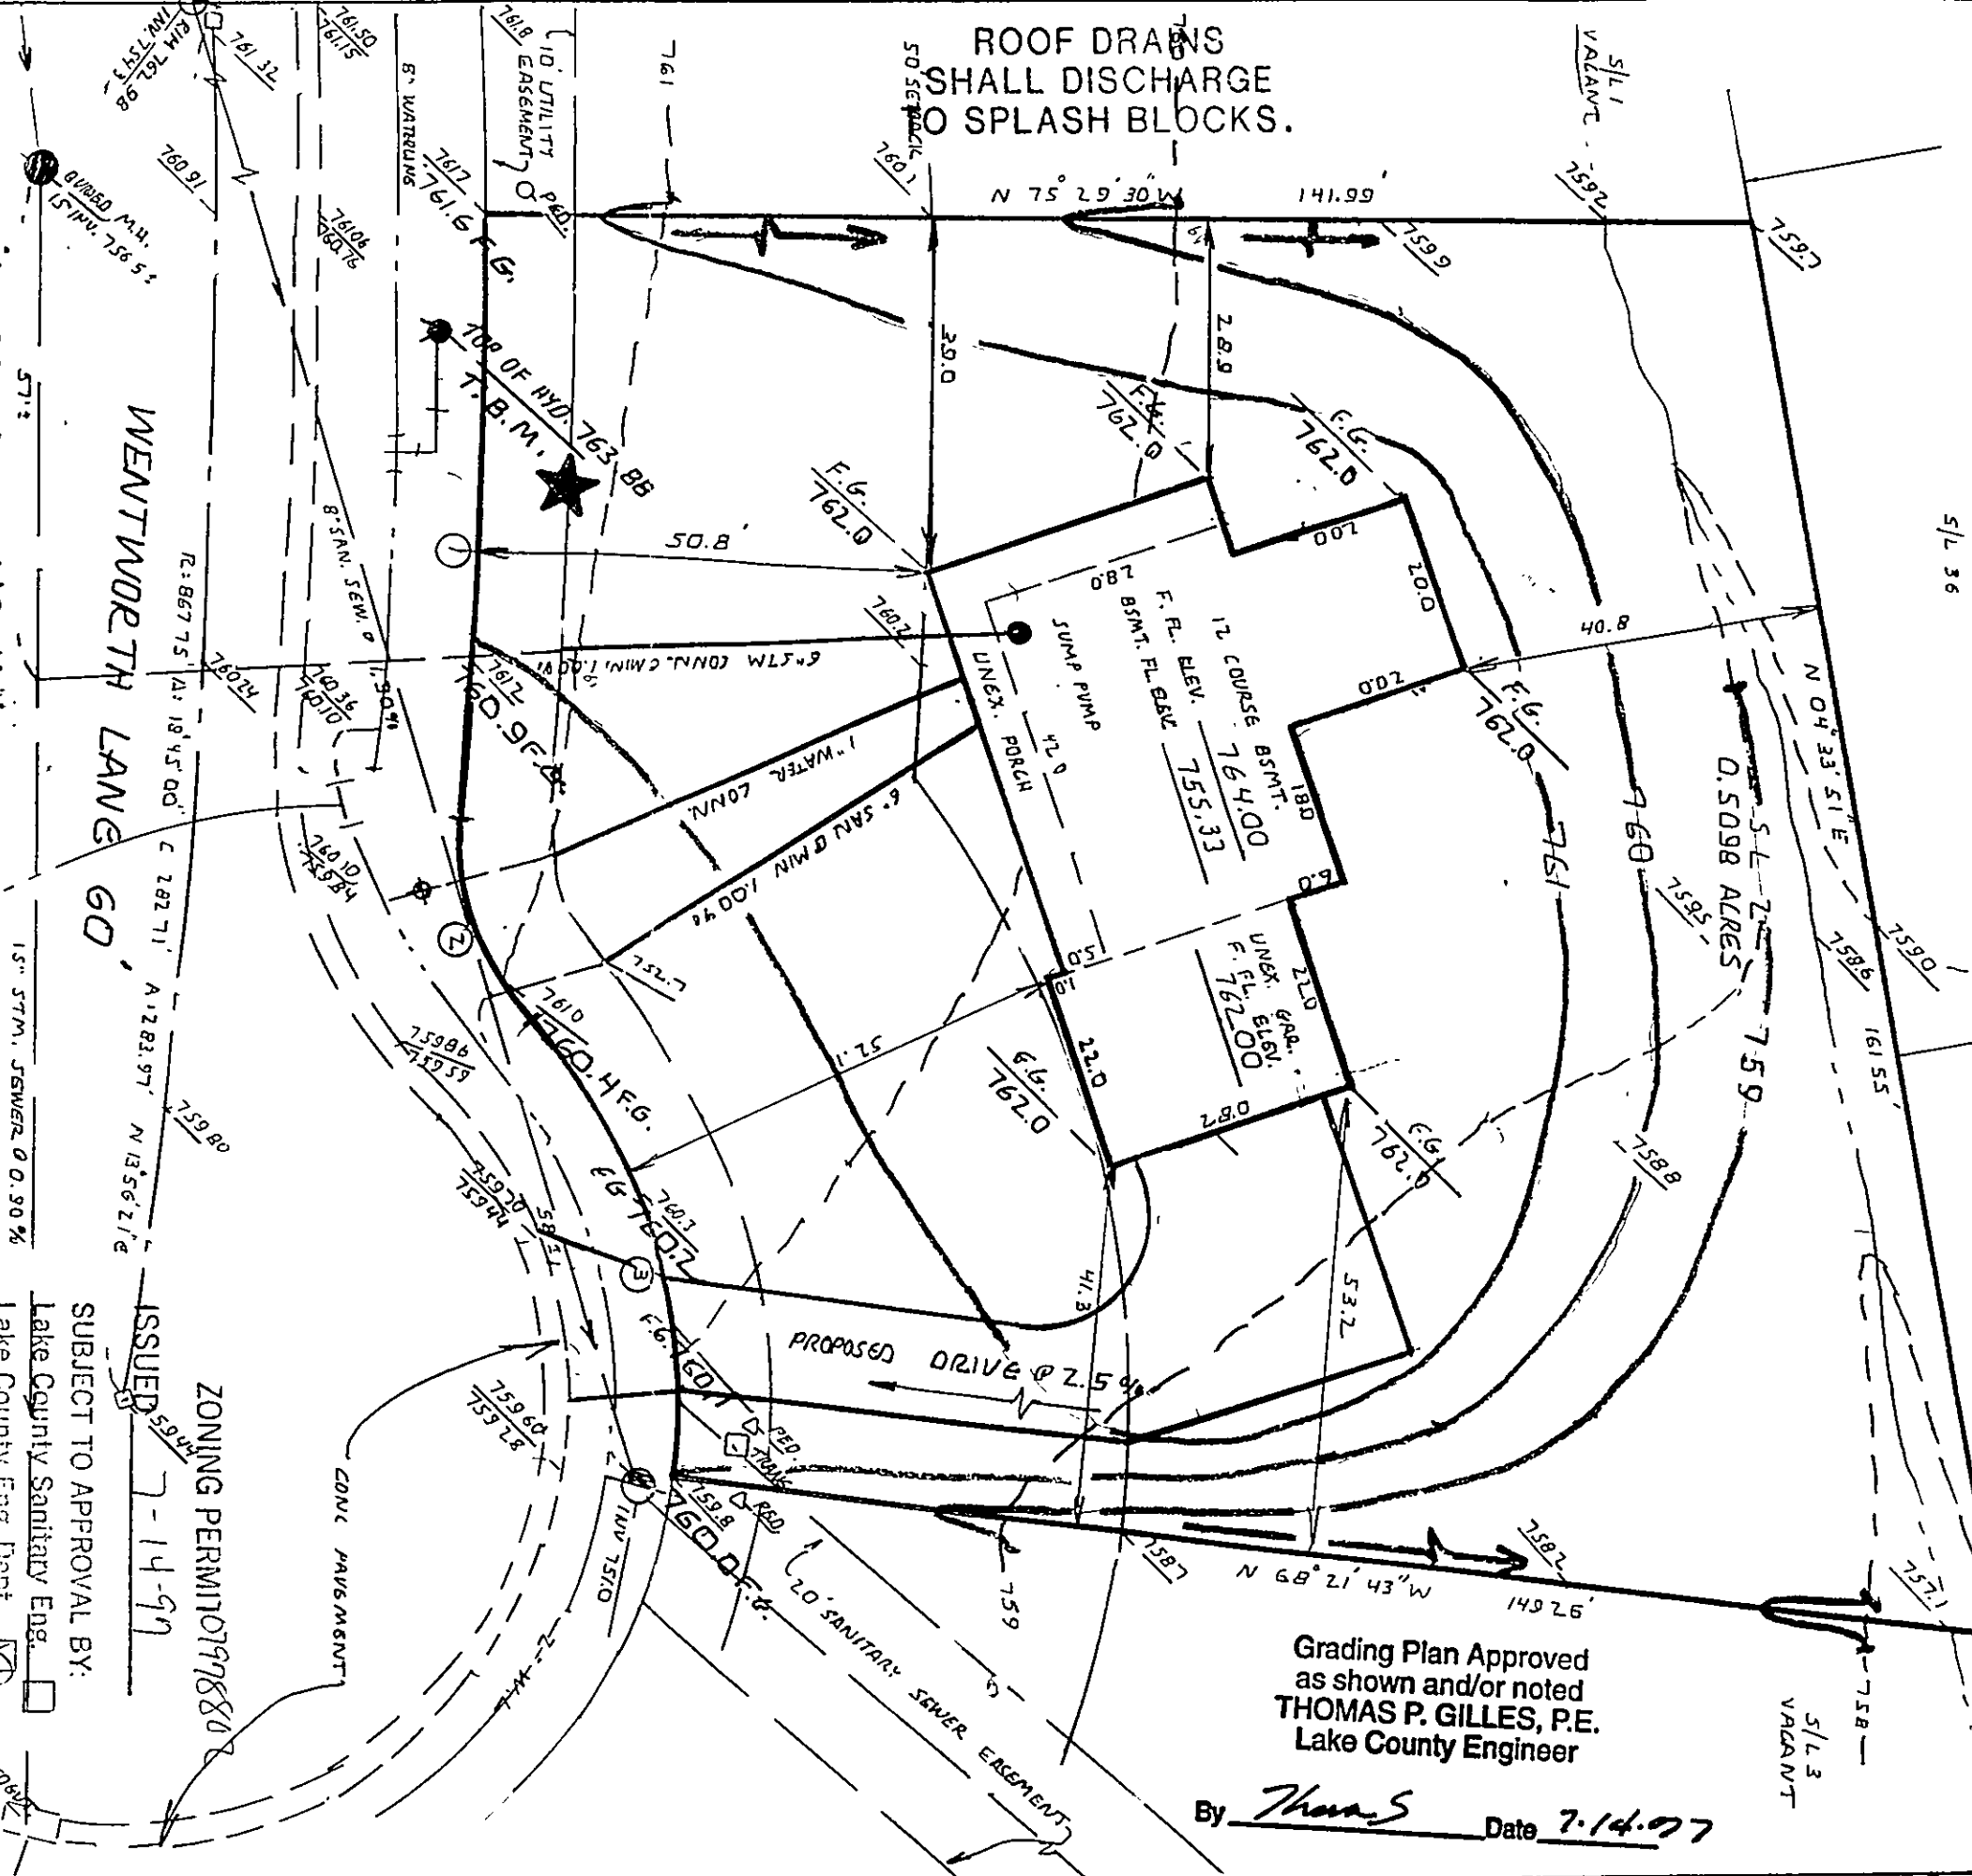

"I, the undersigned hereby certify that this topography, indicated by 6", 1" or 2" contours, and elevations shown hereon represent an actual field survey made by me on the day of JUNE, 1997 and that elevations were taken at appropriate intervals and that as of that date, the same existed as indicated hereon."

Name Thomas P. Gilles Reg. No. 7193

DESIGN CERTIFICATION

This Plan was prepared by me, and is correct to the best of my knowledge and belief.

RUDY E. SCHWARTZ, P.S. NO. 7193

NOTES: SEE ARCHITECT'S PLAN FOR COMPLETE HOUSE DIMENSIONS.

FOR
WATERFORD DESIGN HOMES, INC.
SUBLOT NO. 2 WORTHINGTON HILLS

SUBJECT TO APPROVAL BY:

Lake County Sanitary Eng. ☐
Lake County Eng. Dept. ☒
Lake County Planning Comm. ☐
Lake County Bldg. Dept. ☐
Lake County Site Plan ☐

ZONING PERMIT 0797880
ISSUED 7-14-97

Situated in the Township of Concord, County of Lake, and State of Ohio and known as being a part of Original Concord Township Lot No. 20, Tract No. 4.

PREPARED BY:

RUDY E. SCHWARTZ
PROFESSIONAL SURVEYOR
15750 AUBURN ROAD
NEWBURY, OHIO 44065
(216) 564-7528
FAX: (216) 564-5675

PREPARED FOR:

WATERFORD DESIGN HOMES, INC.
P.O. BOX 855
CHARDON, OHIO 44024

97.042