


LEGEND

- IRON PIN FOUND
- R.R. SPIKE FOUND
- P.K. NAIL FOUND
- STONE FOUND
- FENCE POST FD. & USED
- IRON PIN SET
- R.R. SPIKE SET
- P.K. NAIL SET
- BREAK POINT
- FENCE LINE
- PROPOSED CONTOURS
- EXISTING CONTOURS
- EXISTING ELEV. PROPOSED ELEV. ELECTRIC LINES
- WATER LINE
- SANITARY LINE
- GAS LINE

This product style and format is protected by copyright. The use of this style and format is strictly prohibited without the written consent and permission of Bock & Clark.

COPYRIGHT 1995 by Bock & Clark

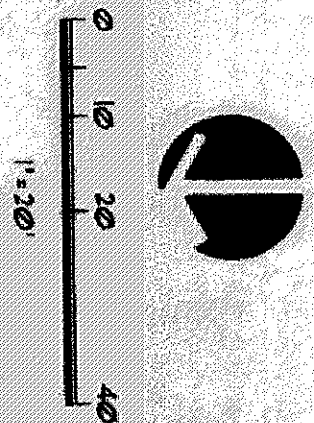


SITE IMPROVEMENT PLAN

RL MOORE HOMES INC.
S/L NO. 1
WORTHINGTON HILLS SUBDIVISION
VOLUME 24 PAGE 31-1
WENTWORTH LANE
TOWNSHIP OF CONCORD
COUNTY OF LAKE
STATE OF OHIO

SURVEYOR'S STATEMENT

I, the undersigned hereby certify that the topography shown hereon, indicated by 1 foot contours and elevations, represents an actual field topographic survey made on the 3rd day in November 1995 and that the elevations were taken at appropriate intervals and that as of that date they existed as indicated hereon.

Dimensions on this plat are expressed in feet and decimal parts thereof unless otherwise noted. Bearings are referred to an assumed meridian and are used to denote angles only. Monuments were found or set at points indicated hereon. The Basis of Bearing is the chord bearing for Wentworth Lane N 13°56'21" E as shown on Plat Volume 24 Page 34-1 as recorded in Lake County Record of Plats.

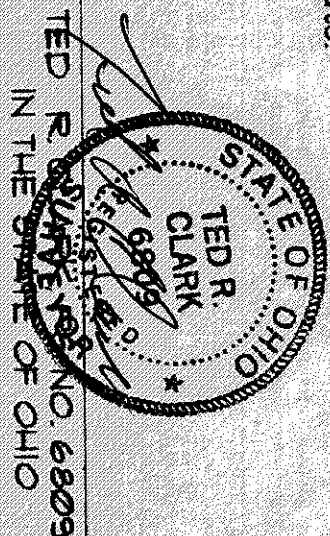


TED R. CLARK
IN THE STATE OF OHIO

DRAWN BY: TJO
DATE OF SURVEY: 11-01-95

DRAWING REVISED: 12-11-95
PROJECT NUMBER: 1134

BOCK & CLARK'S NATIONAL SURVEYORS NETWORK

ENGINEERS & SURVEYORS (800-187-8396) (FAX: 216-350-9074)
8 NORTH STATE STREET, SUITE 102, PAINESVILLE, OHIO 44071

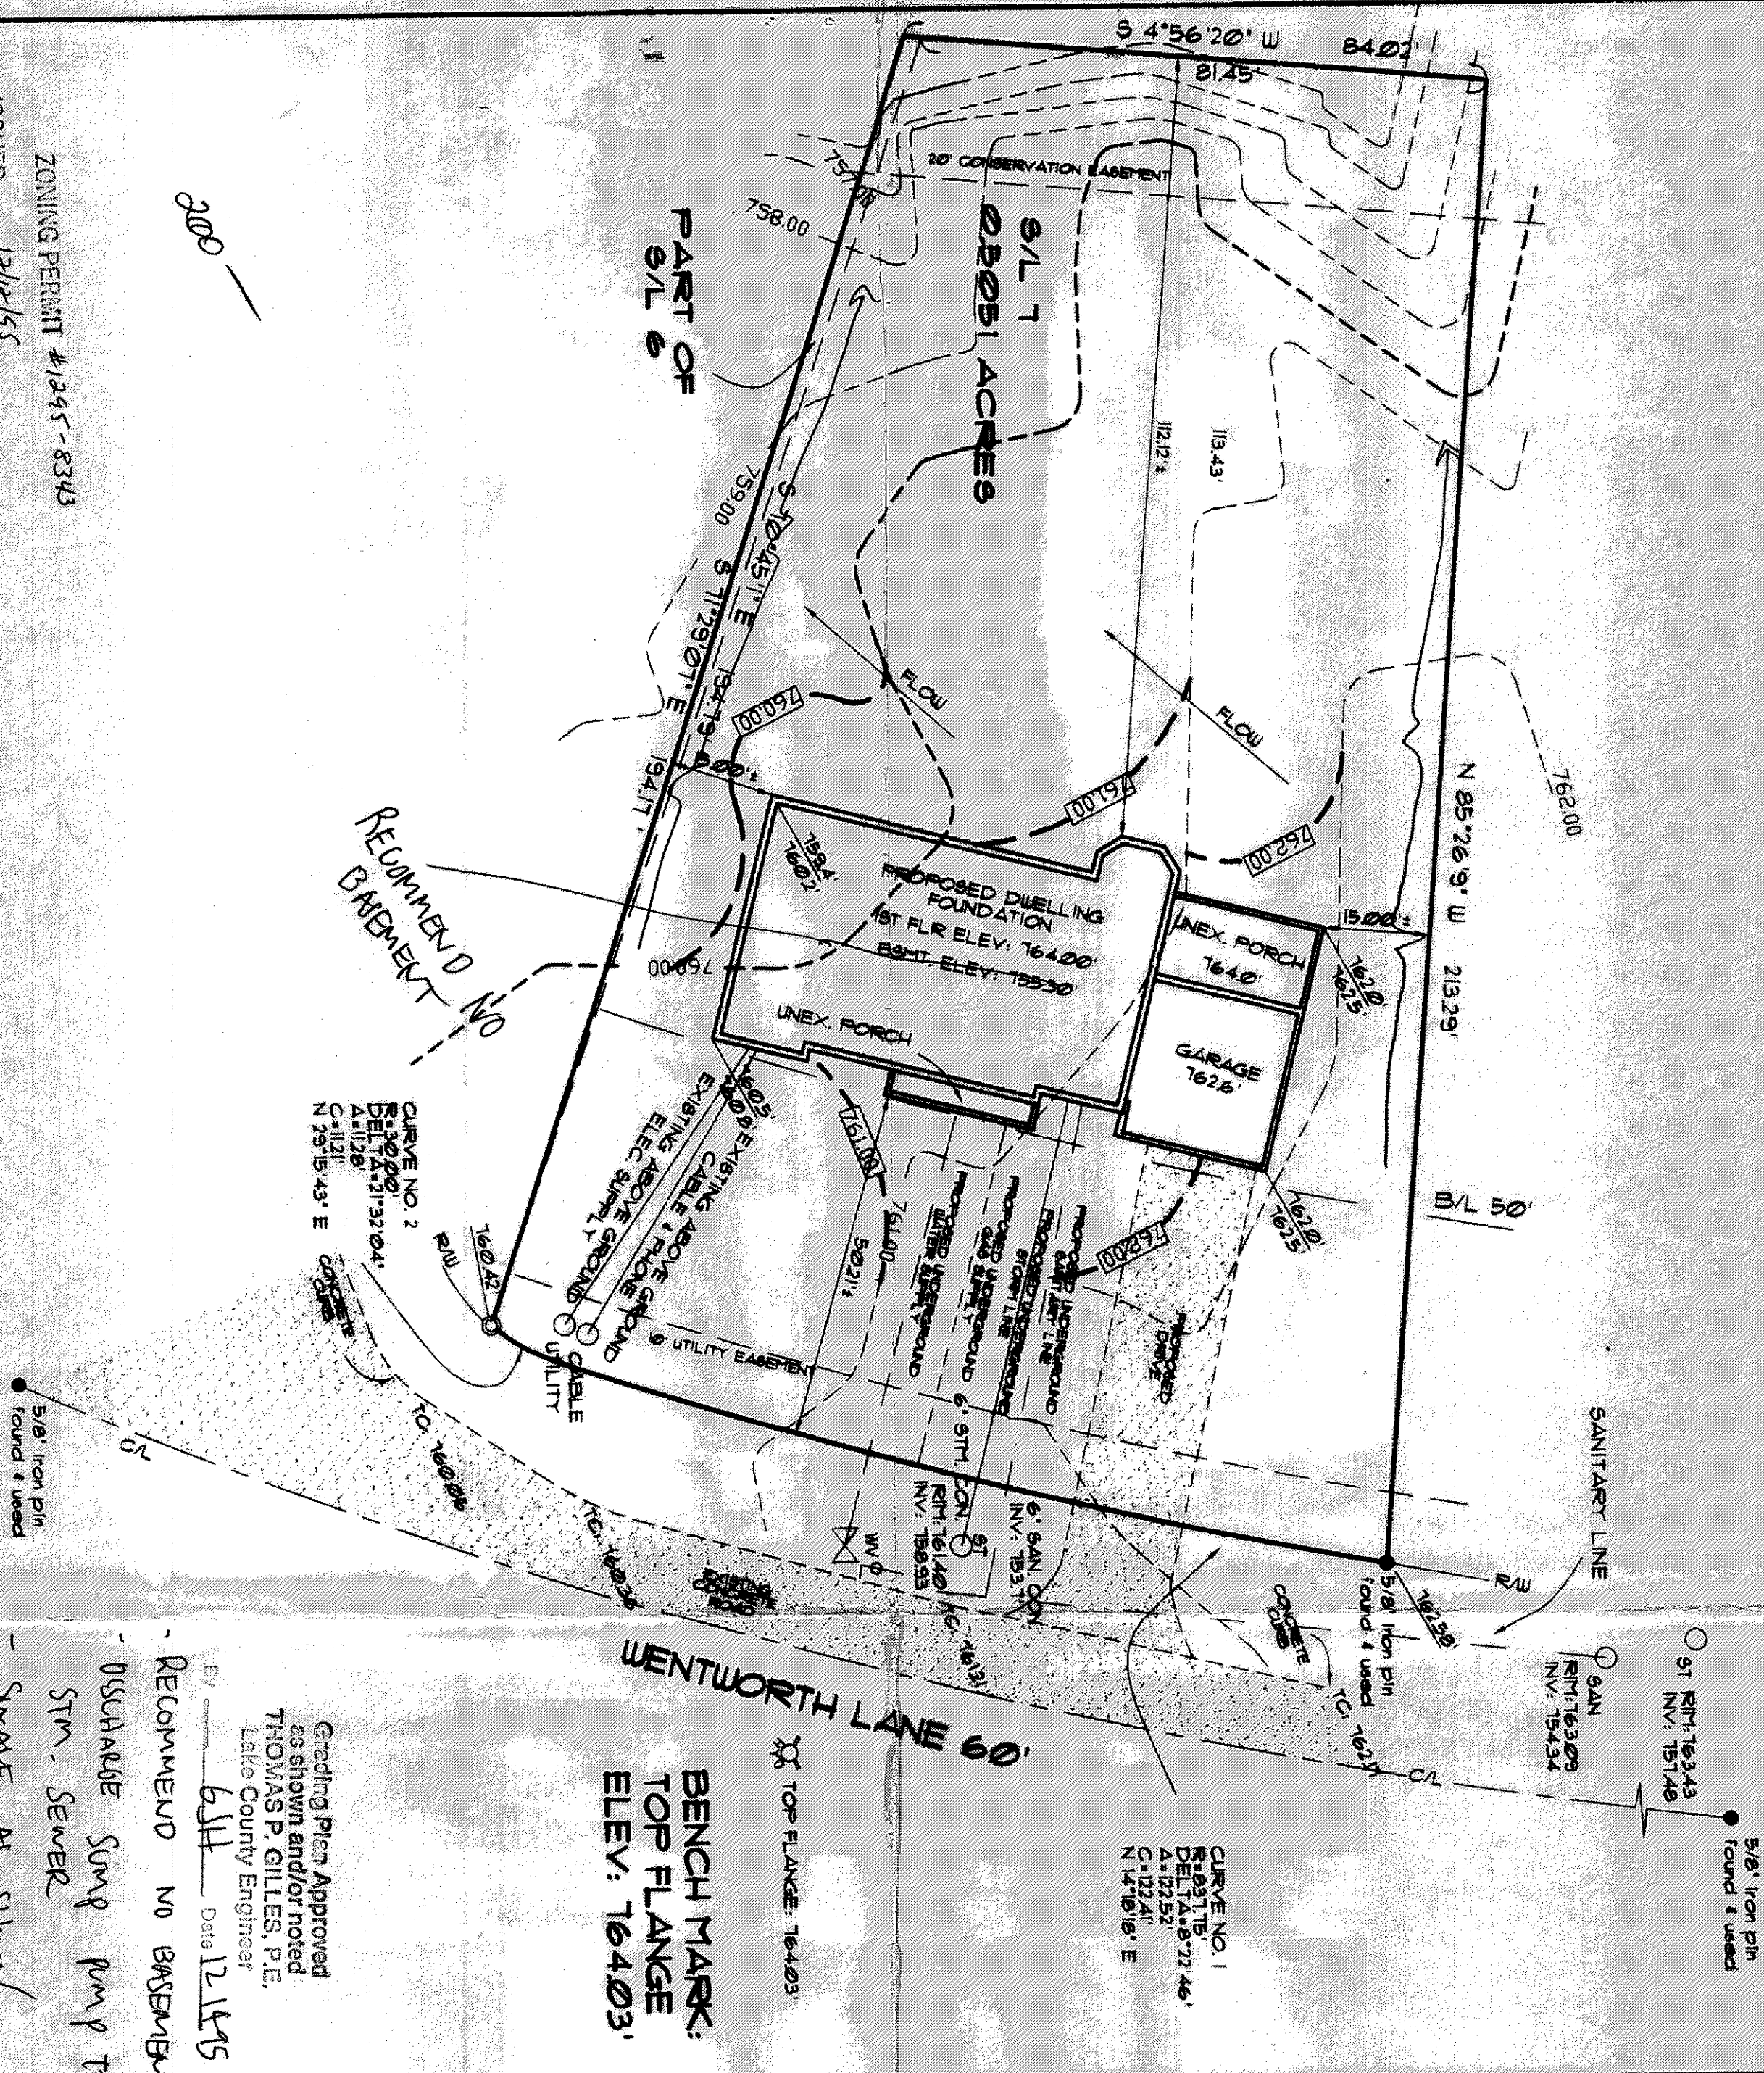

Grading Plan Approved as shown and/or noted
THOMAS P. GILLES, P.E.
Lake County Engineer
By: 6JH Date: 12/14/95
RECOMMEND NO BASEMENT
DISCHARGE Sump pump to
Stm. Sewer
Swave As shown
ROOF DRAINS
SHALL DISCHARGE
TO SPLASH BLOCKS.

ZONING PERMIT #1245-8343
ISSUED: 12/12/95
SUBJECT TO APPROVAL BY:
☐ Lake County Sanitary Eng.
☒ Lake County Eng. Dept.
☐ Lake County Planning Comm.
☒ Lake County Bldg. Dept.