

SITE PLAN

Closed Township Lake County, Ohio

for: David L. Lutz

ADDRESS: STREET: CITY: ZIP: LOT: 312 TRACT: 542 SUBDIVISION: Williams Rd. SECTION: 11 TWP: 36-10 R. 12-10 PERM. PARCEL NO.: STREET: PAGE: 1

LEGEND

SANITARY MANHOLE WATER VALVE (GAS) STORM MANHOLE WATER METER (GAS) INLET OR CATCH BASIN AS BUILT ELEVATION HYDRANT EXISTING CONTOURS PROPOSED CONTOURS EXIST. ELEV. 100.0 MOP. ELEV. 100.0 INDICATES DIRECTION OF SURFACE DRAINAGE

REMARKS

ALL BOUNDARY DATA SHOWN WAS OBTAINED FROM IDEBS, RECORDED SUBDIVISION PLAT OR OTHER PUBLIC RECORDS LOCATIONS AS SHOWN OF ADJACENT WELLS AND SEPTIC TANKS OBTAINED FROM LAKE COUNTY HEALTH DEPARTMENT

DESIGN CERTIFICATION

THIS PLAT WAS PREPARED BY ME, AND IS CORRECT TO THE BEST OF MY KNOWLEDGE AND BELIEF.

NAME: SURVEYOR REGISTRATION NO. 63913

CHECK LIST

NO. OF BEDROOMS DIMENSIONS BEARINGS TIE TO NEAREST STREET SUBLOT NO. PARCEL NO. SURROUNDING OWNERS BLDG. DIMENSIONS FIN. OR. BLDG. TIE P.L.N. GRADES APPROX. TYPE WORTHY UNFINISHED CEMENT TYPE DIA. LENGTH ROCK OUTCROPPINGS WATER MAIN SIZE, LOCATION SAN. SEWER SIZE & OR. LOC. SAN. MAN. CAST. ELEV. INV. ELEV. SAN. CONN. SIZE, LOC. DEPTH STORM SEWER SIZE & OR. LOC. STORM MAN. CAST. ELEV. INV. ELEV. TIE TO GRADE CORNS. GAS LINES, LOC. SIZE, MATERIALS, SERVICE FROM EXISTING & LOCATION AREA WELL LOCATION RADIUS FROM WELL

PLAN PREPARED BY:

BABCOCK & JONES & ASSOCIATES, INC. PAINESVILLE, OHIO

NO.	DATE	BY
1		
2		
3		
4		
5		

"AS BUILT" CERTIFICATION

I, HEREBY CERTIFY THAT THE CIRCLED GRADES ARE EXISTING FINISH GRADES CHECKED IN THE FIELD ON 19. AND ARE CORRECT TO THE BEST OF MY KNOWLEDGE AND BELIEF.

REGISTERED SURVEYOR REG. NO. 5799

7571-7574 - ELEV. 100.00

ZONING PERMIT #5799 ISSUED 5-31-88

SUBJECT TO APPROVAL BY LAKE COUNTY HEALTH DEPT. LAKE COUNTY ENGINEER


Tono & Manno

Grading Plan Approved as shown and/or noted THOMAS P. GILLES, P.E. Lake County Engineer

By: Date: 5/10

SEWAGE DISPOSAL PERMIT MUST BE OBTAINED BY A LAKE COUNTY LICENSED INSTALLER BEFORE INSTALLATION IS STARTED.



- A. To be brought to finished grade
- 1. Septic tank manhole covers
- 2. Splitter box cover
- 3. Distribution box cover
- B. No further changes or discrepancies to be discharged into septic tanks
- C. All waste water to be discharged into septic tanks

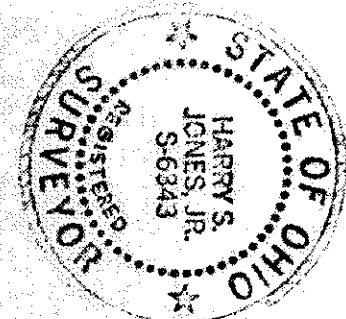

LOW YIELD WATER FIXTURES REQUIRED ON ALL Shower Head Toilet

Reviewed and Accepted LAKE COUNTY GENERAL HEALTH DISTRICT JOEL LUCIA, R.S.M.P.H. Health Commissioner Date: 5-26-88 BY: [Signature]

HYDRAULIC PROFILE SCALE: HORIZ: 1"=30' VERT: 1"=5'

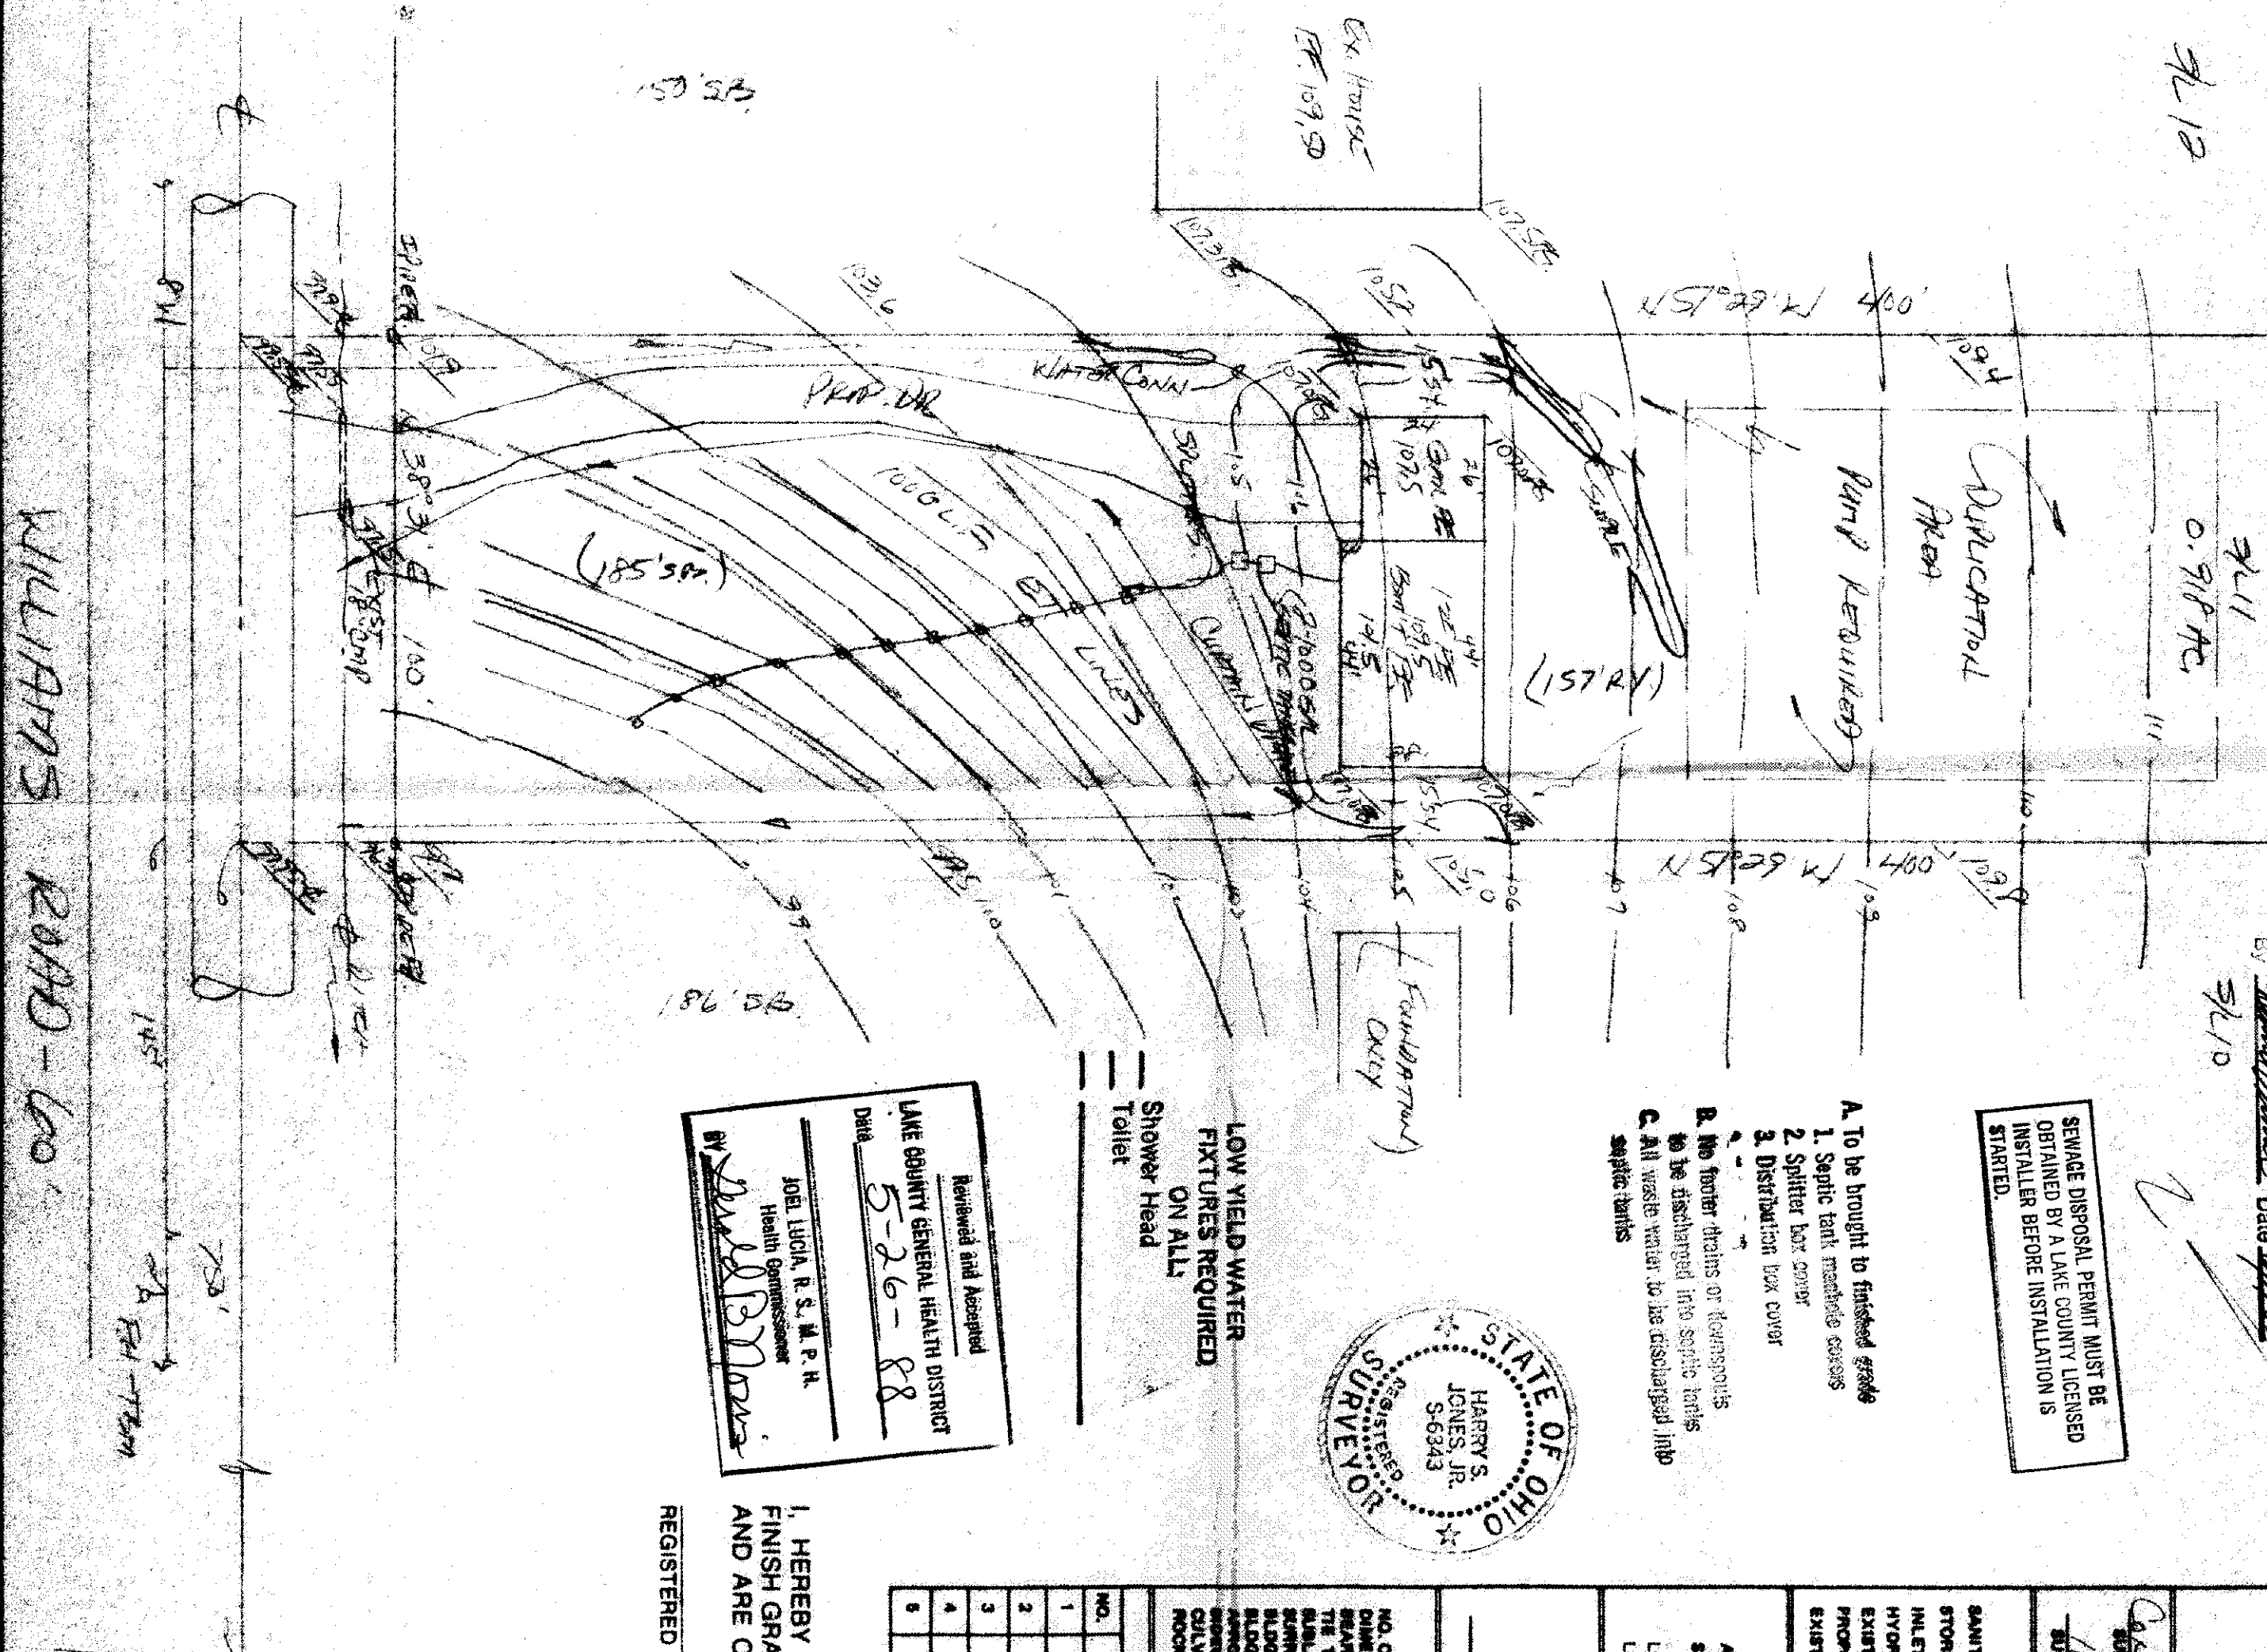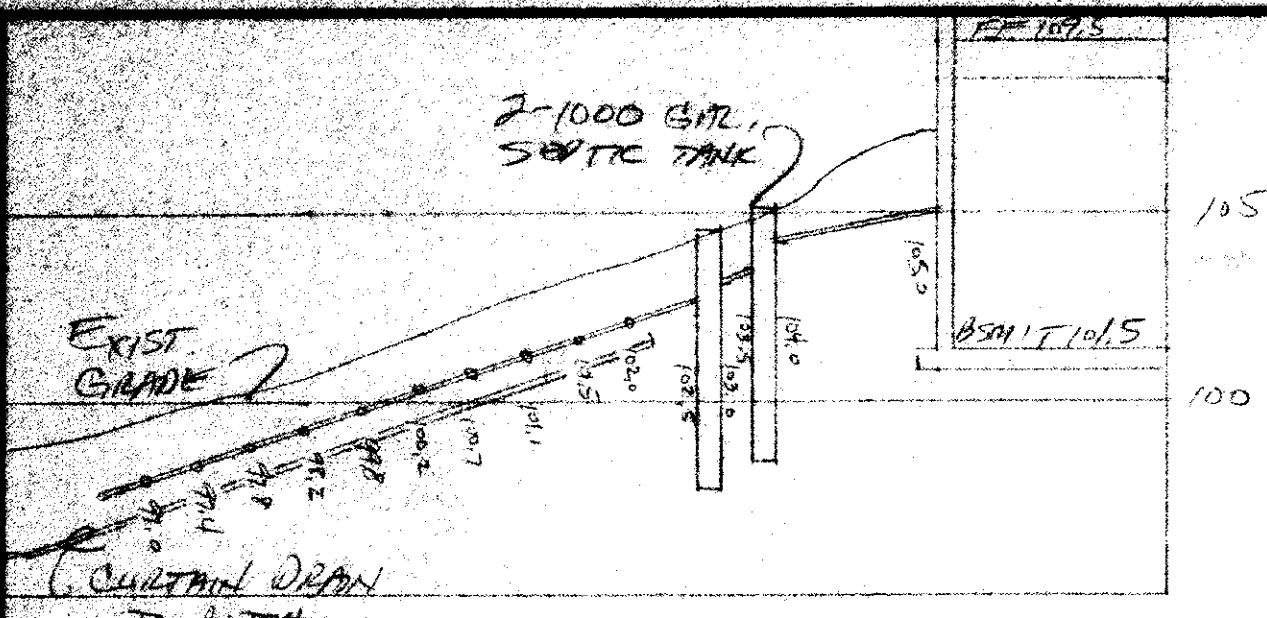

WILLIAMS ROAD - 60'