



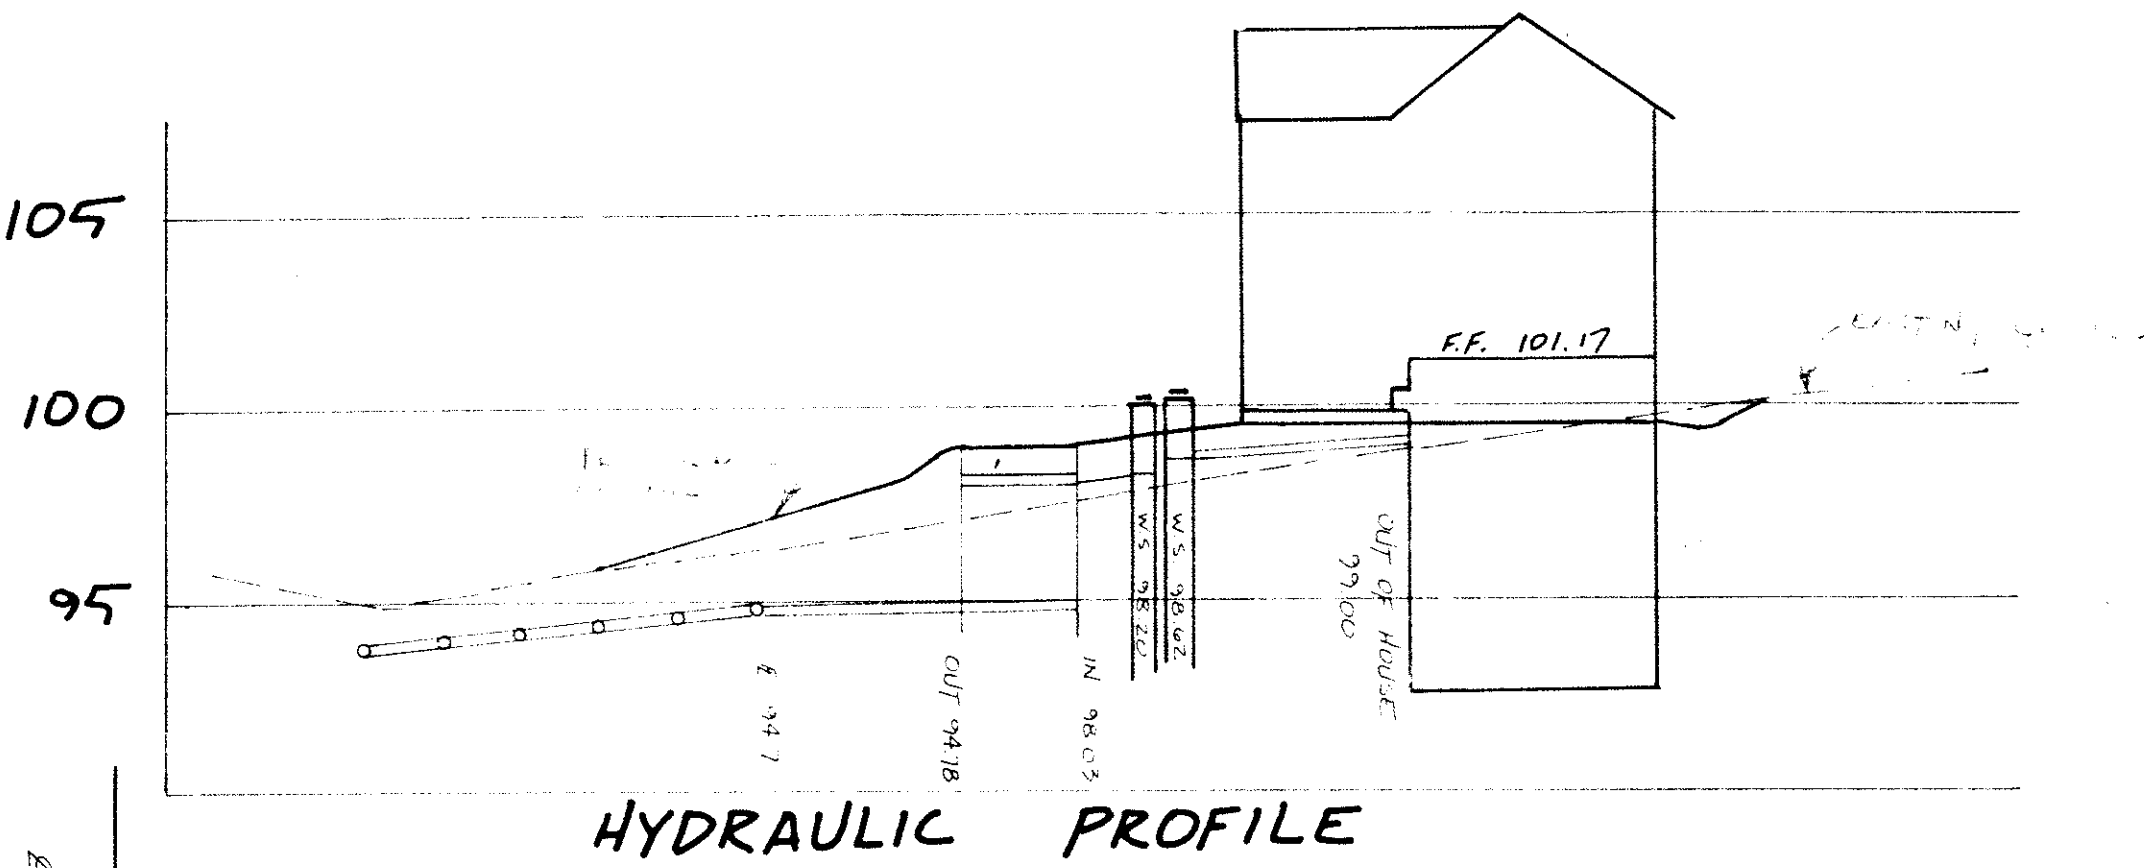

HYDRAULIC PROFILE

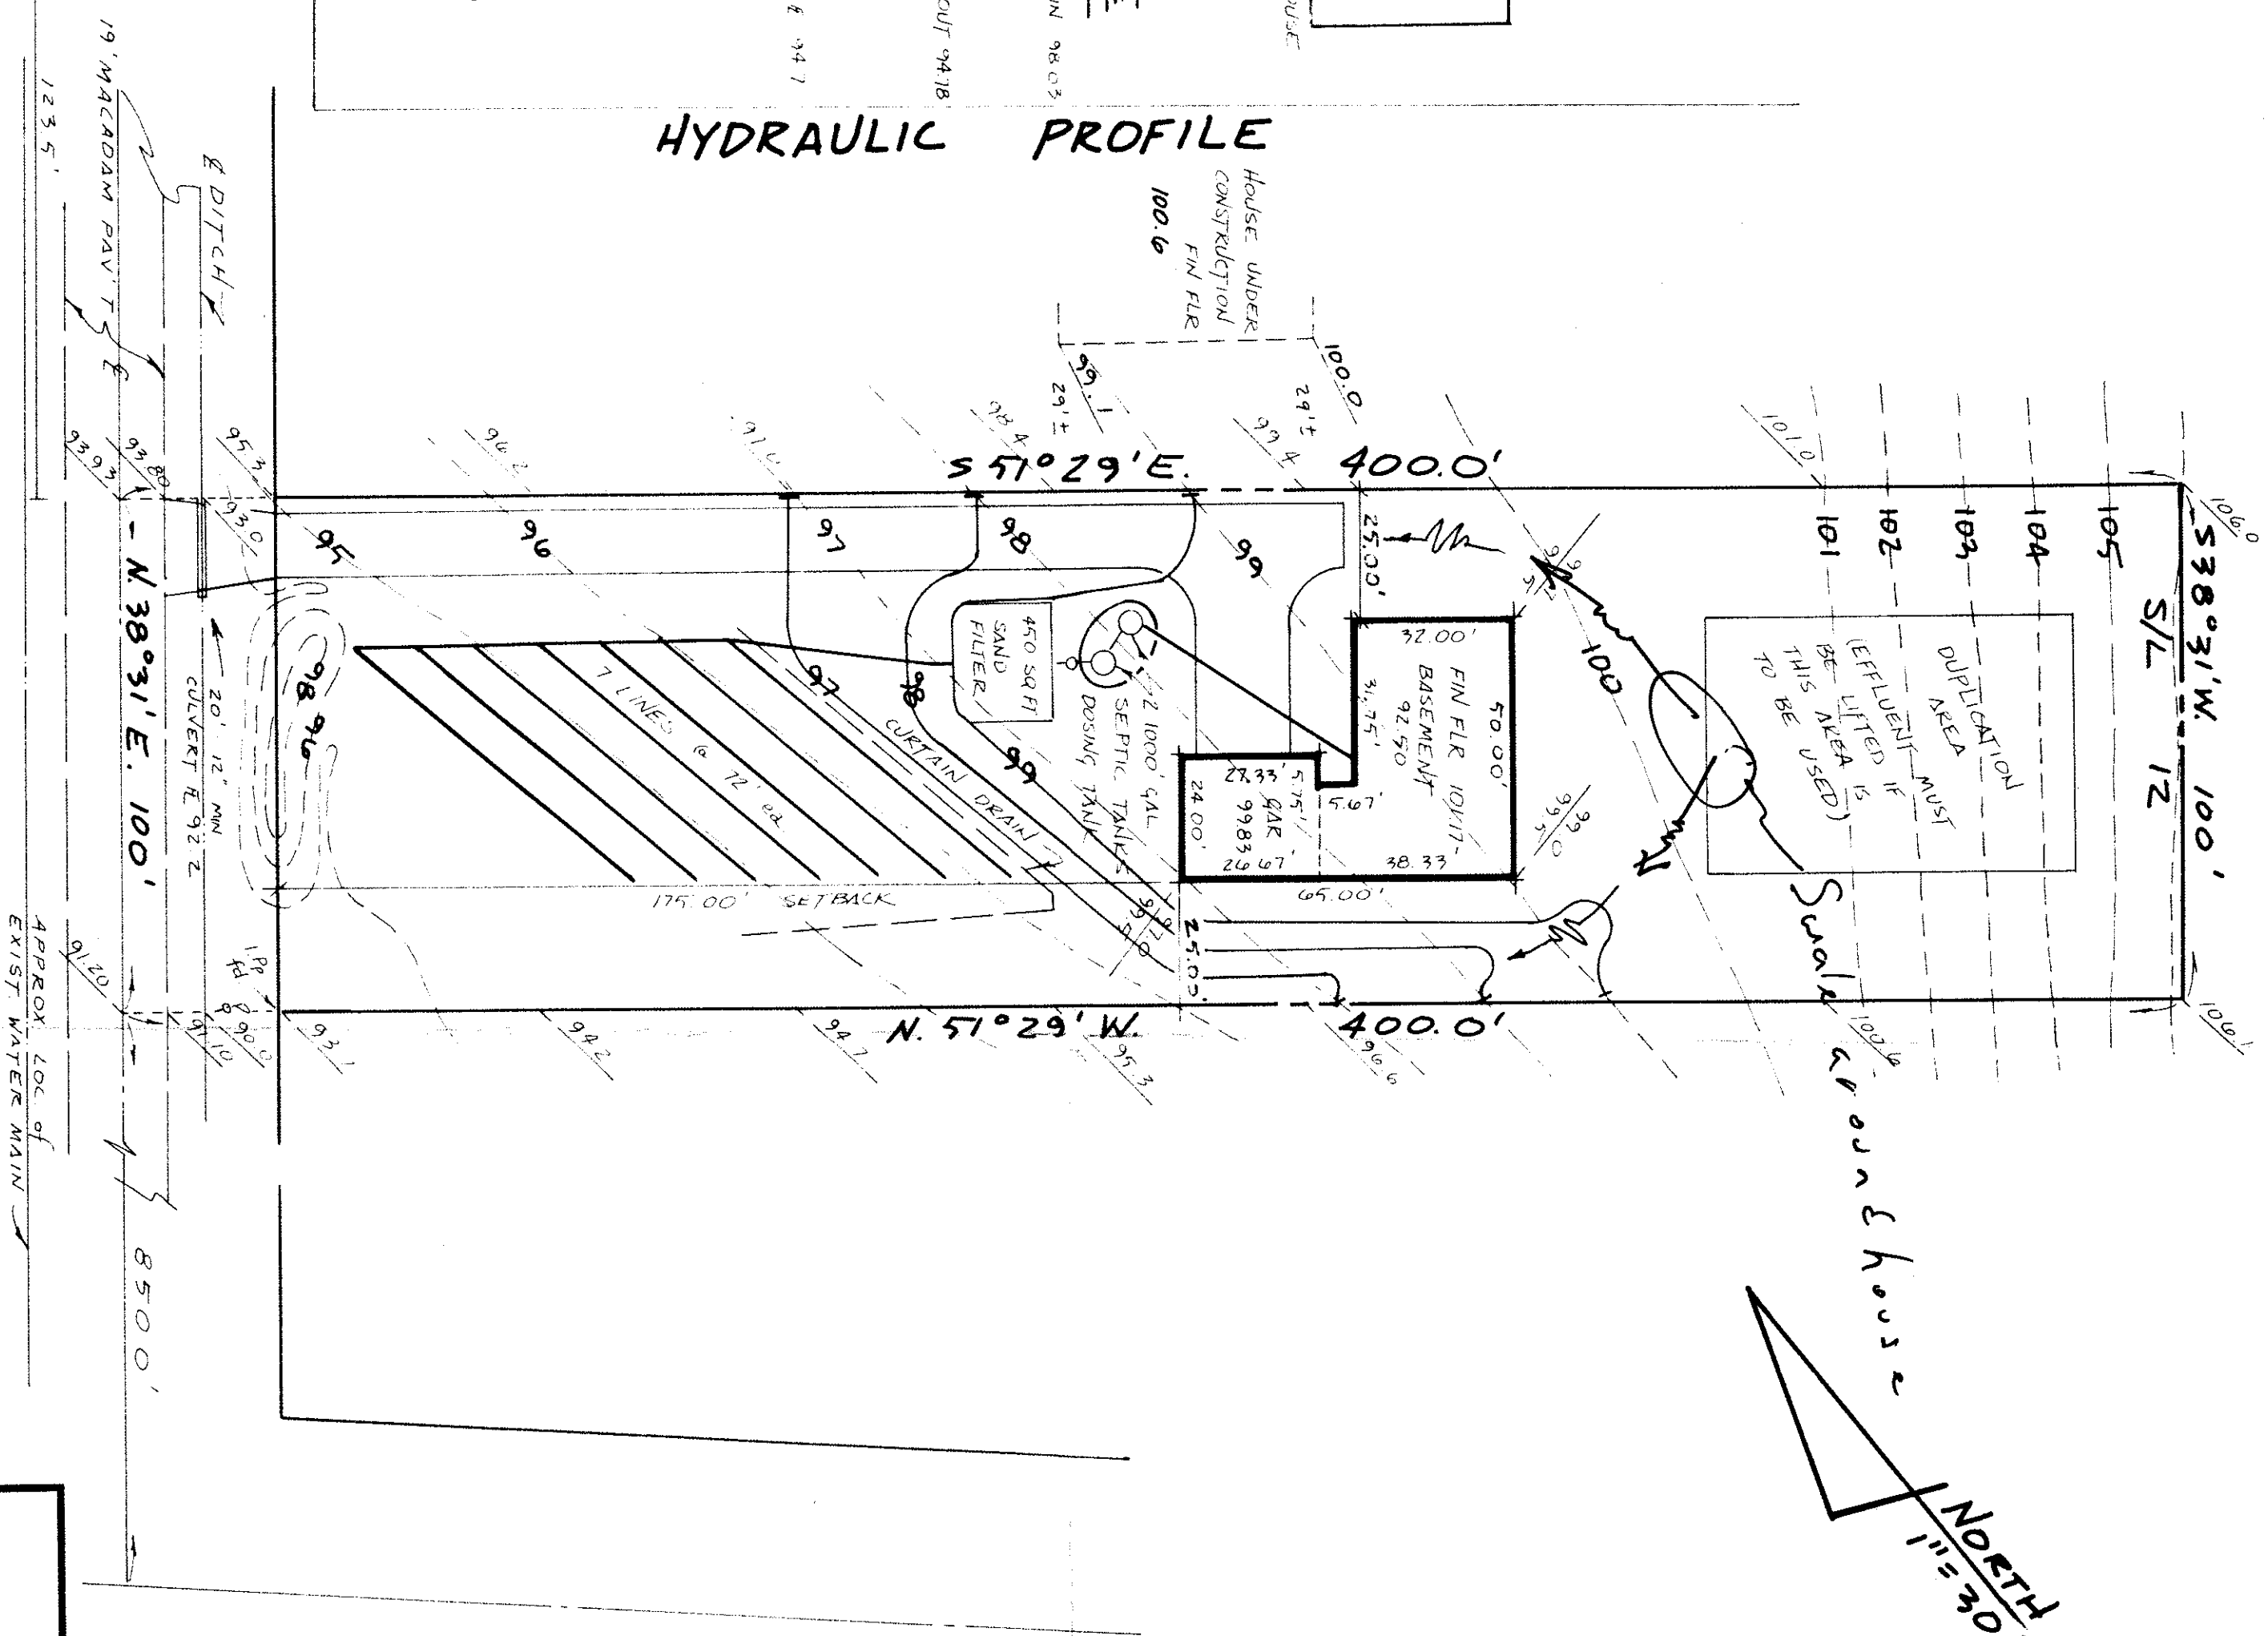

APPLICANT MUST
EFFLUENT IS
BE LIFTED
TO BE USED



Swale around house

NORTH
1"=30'

CONCORD · HAMB DEN RD. 66'

Site Plan

20' MIN

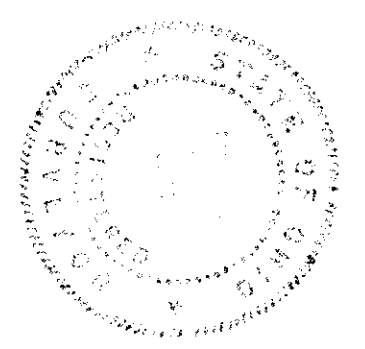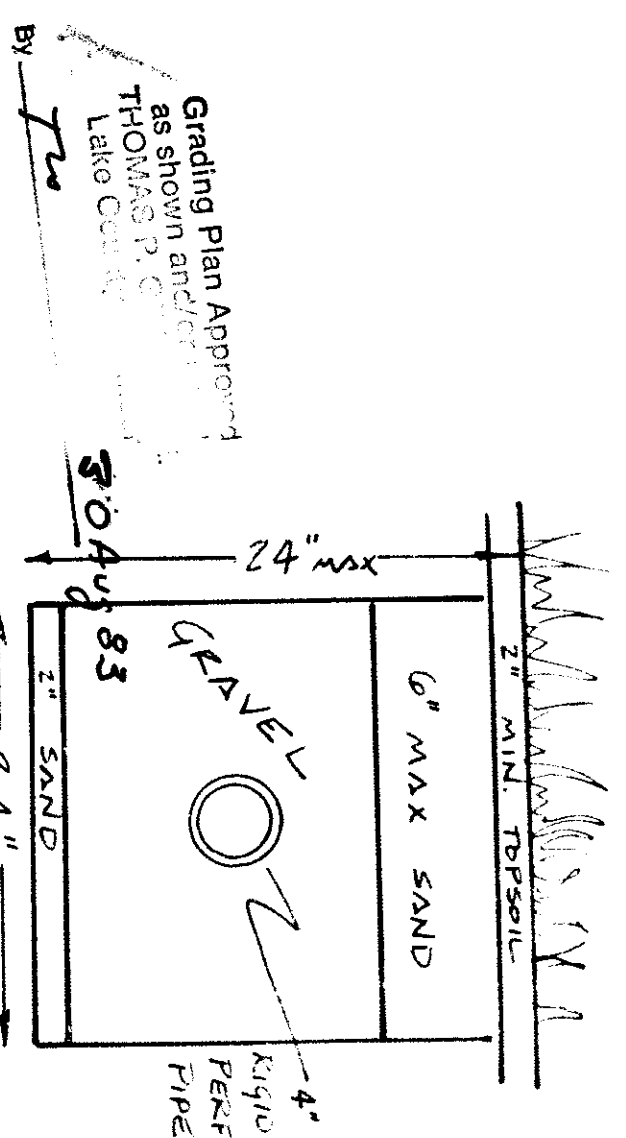

DATE: 10/1/03
SCALE: 1"=30'
DRAWN BY: T. L. L.
CHKD BY: T. L. L.
F&E: PG.

for OVERHOLDER · SULLIVAN
S/L 12, CONCORD AIR PARK, VOL. 6, 95
CONCORD TWP., LURE COUNTY, OHIO

COLPETZER · WOODS
CONSULTANTS, INC.
MENTOR, OHIO 44060

SHEET
OF

CONTRACT NO.
83-243