
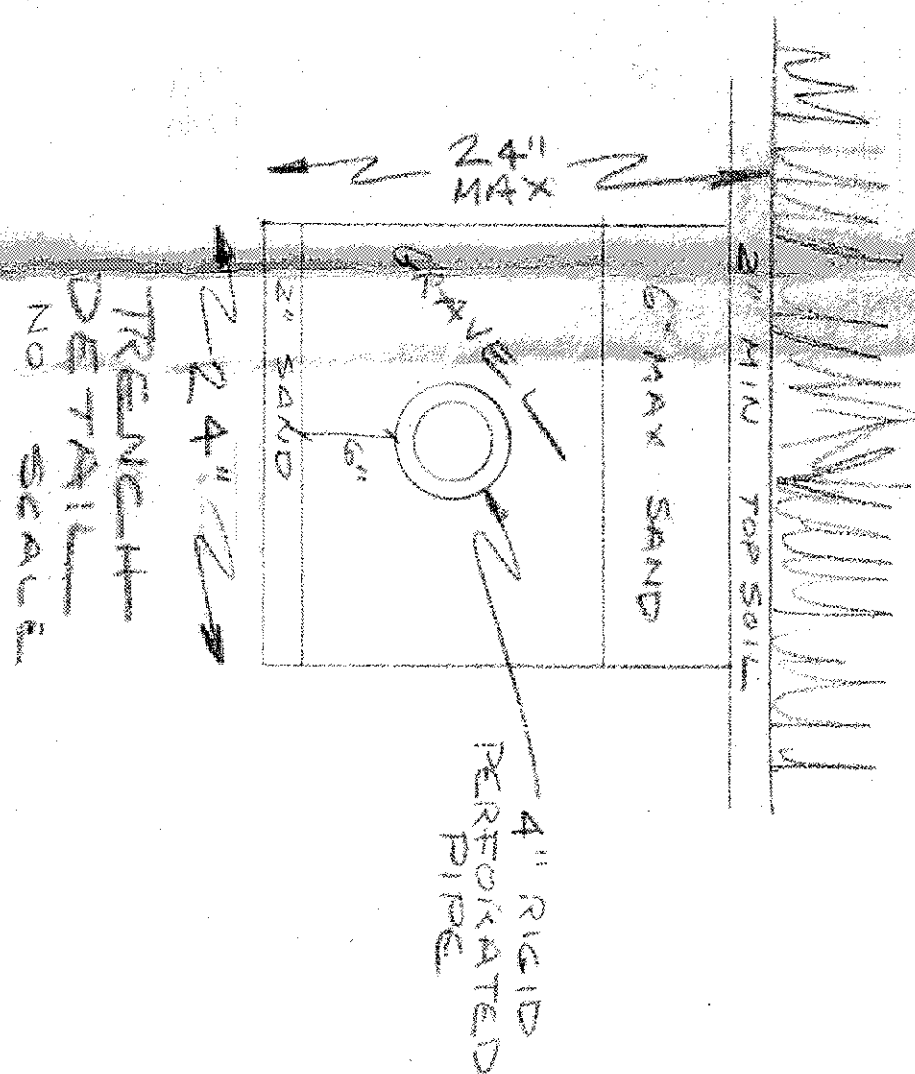


TBM Top of 1700 5110000

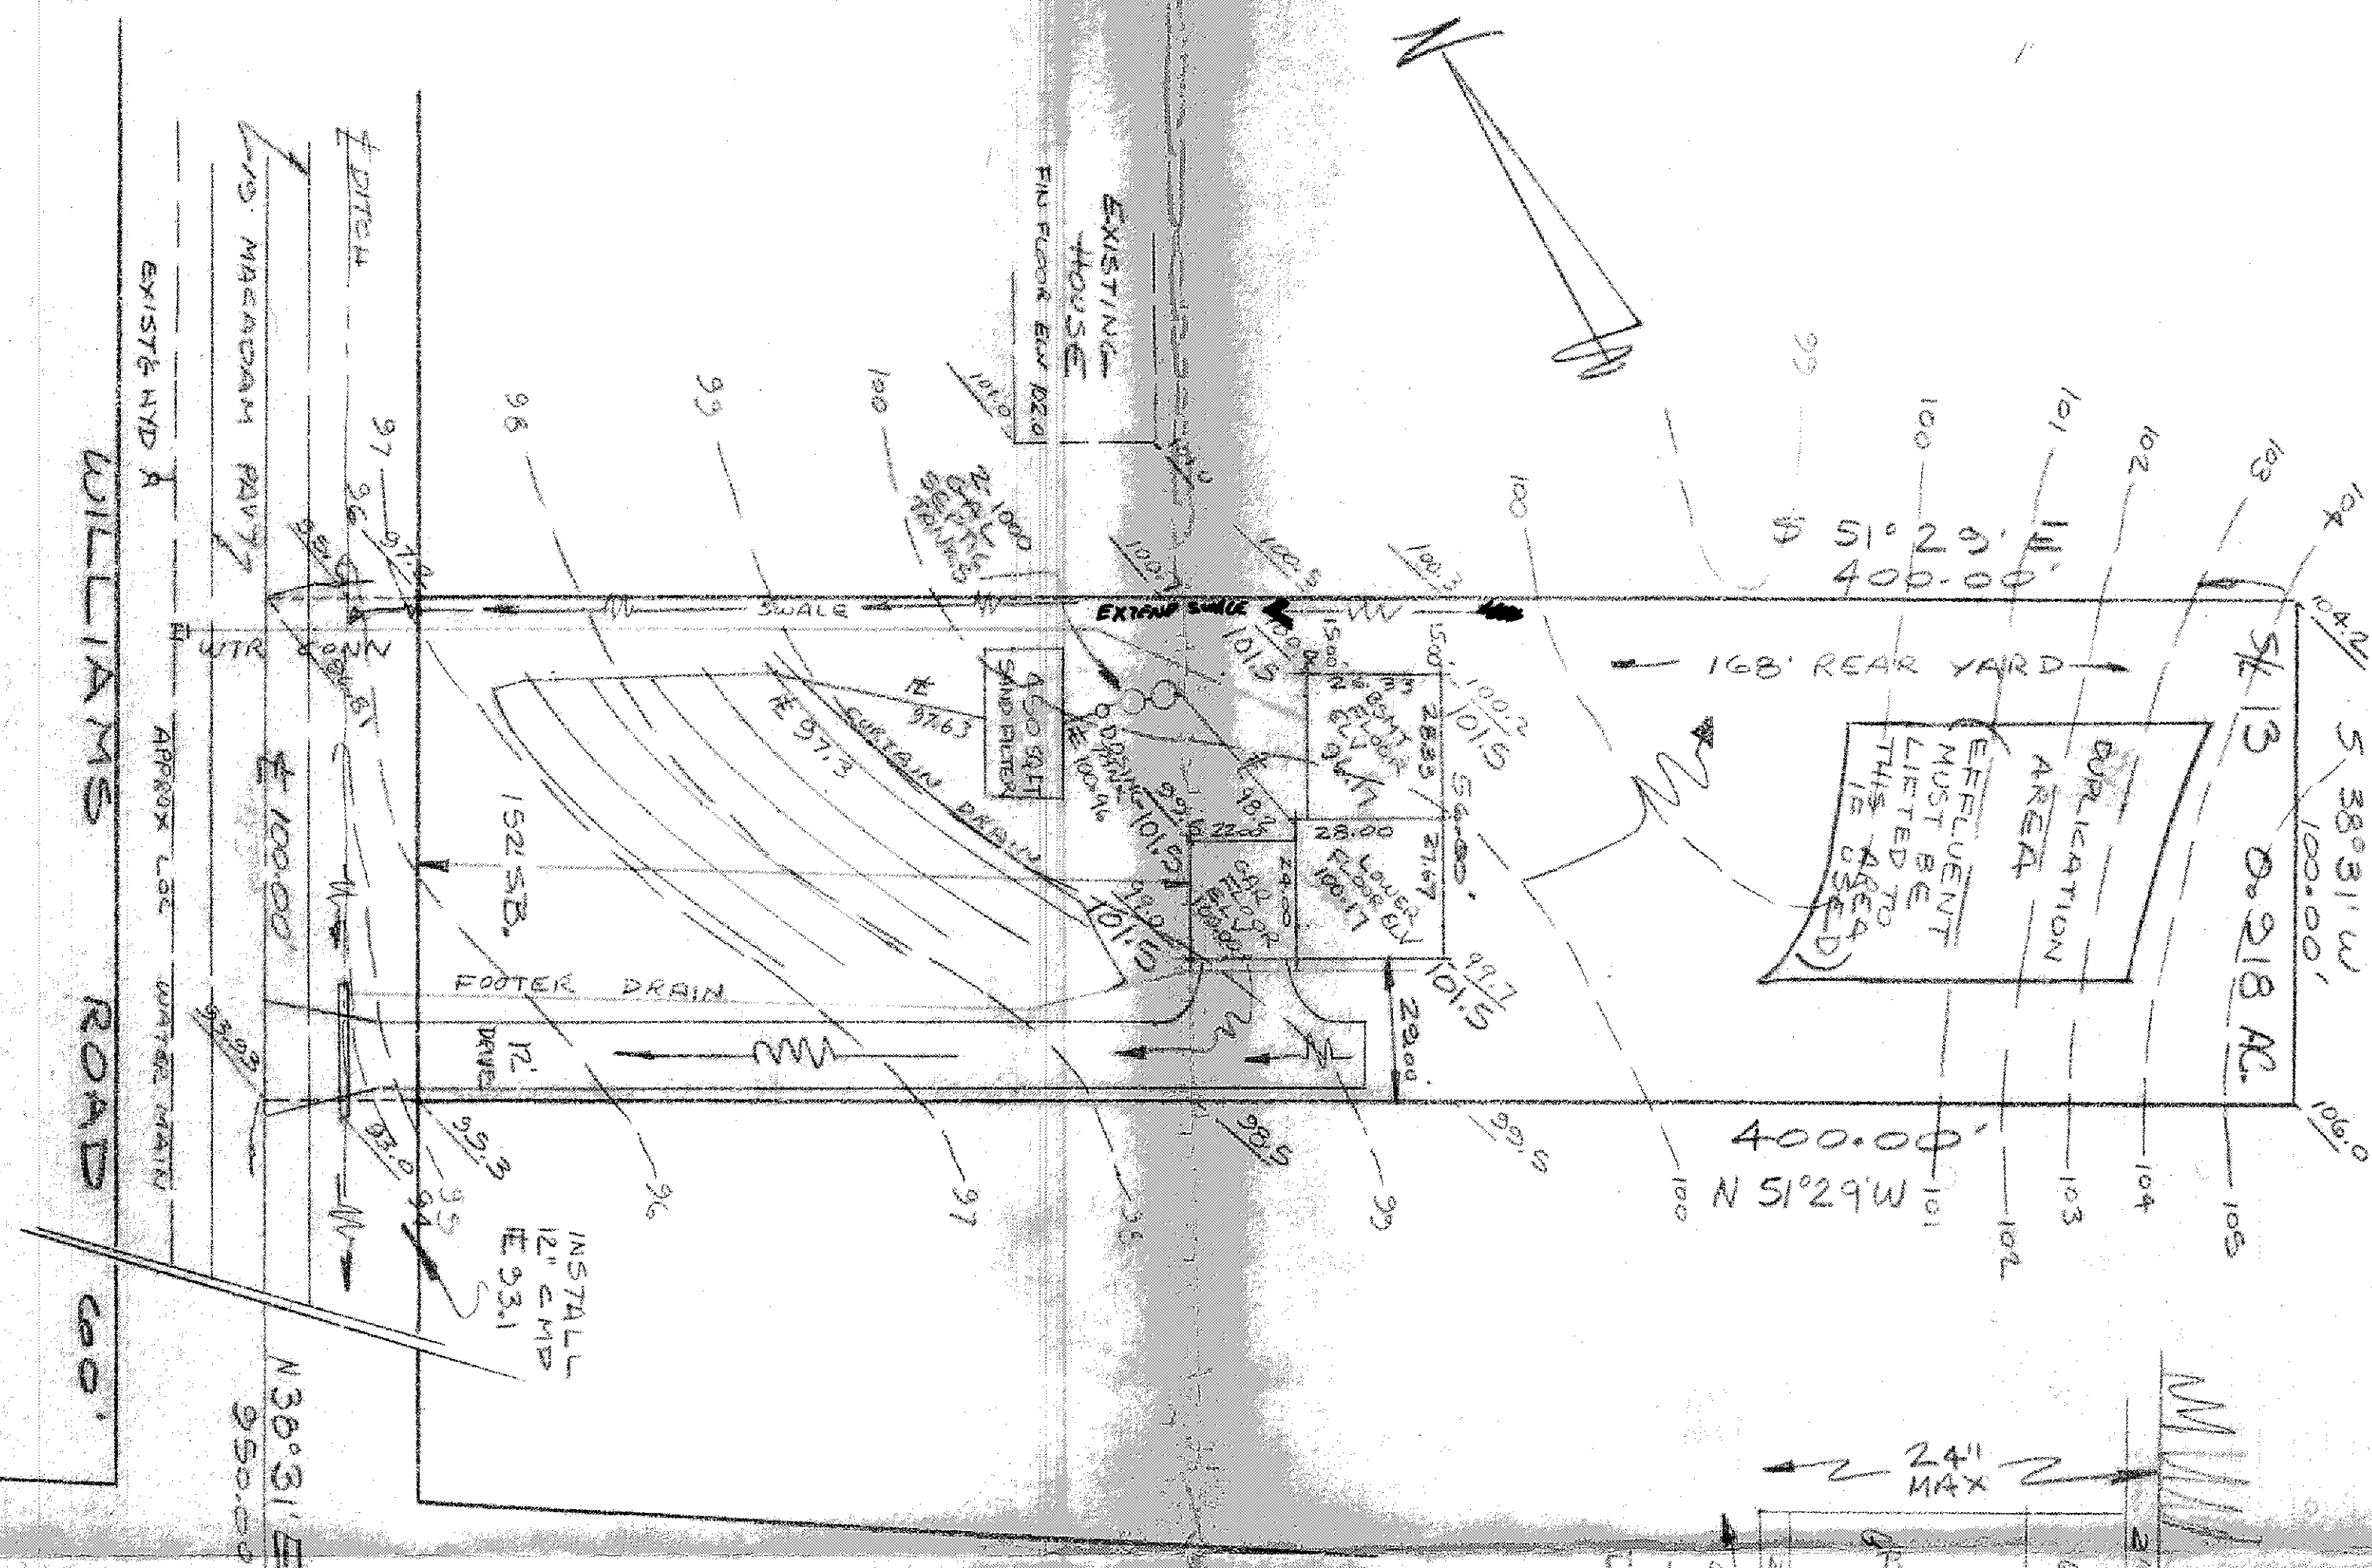

CONCORD - HAMBDEN ROAD 66'

ZONING PERMIT #4593
ISSUED 3-23-83


SUBJECT TO APPROVAL BY:

Lake County Sanitary Eng. ☐
Lake County Eng. Dept. ☒
Lake County Planning Comm. ☐
Lake County Bldg. Dept. ☒

Tenn & Merdane

Grading Plan Approved
as shown and/or noted
THOMAS P. GILLES, P.E.
Lake County Engineer

5. YWK Date 3-24-83

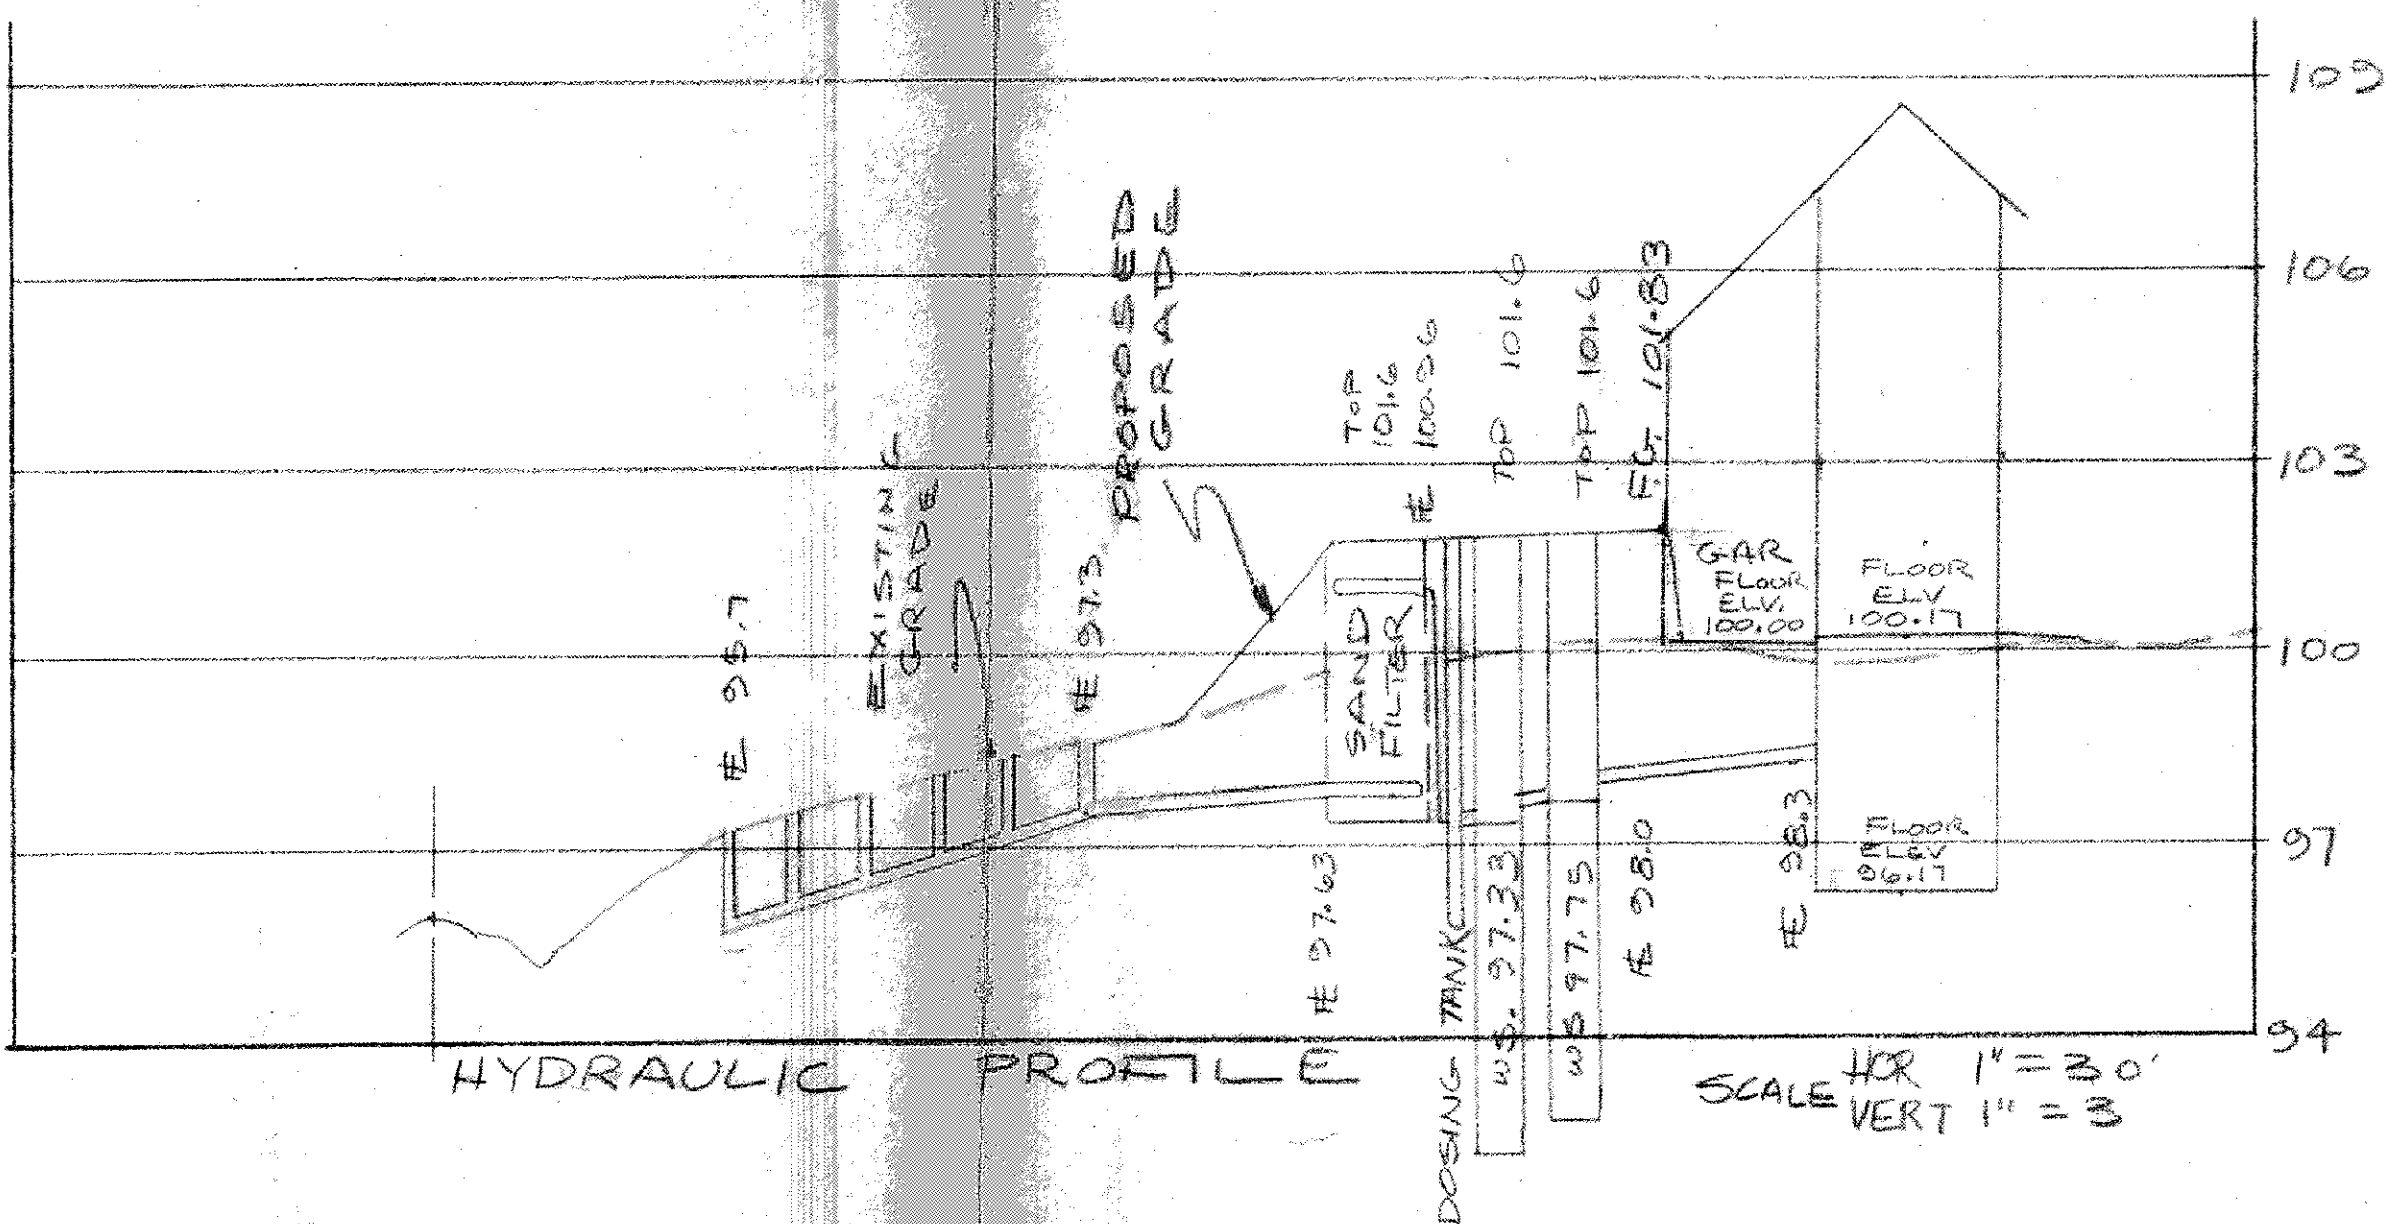

SCALE HOR 1" = 30'
VERT 1" = 3'

SITE PLAN for SPALLER CONSTRUCTION OF 5/6/13
IN THE CONCORD AIR PARK SUBD(VOL. PG 95) IN
CONCORD TOWNSHIP LAKE COUNTY OHIO

THIS PLAT PREPARED BY
RICHARD J. BLISKI, PS#324

Richard D. D.



COLPETZER · WOODS
CONSULTANTS, INC.

CONTRACT NO. 1