


WINDING TRAIL PLACE 60'

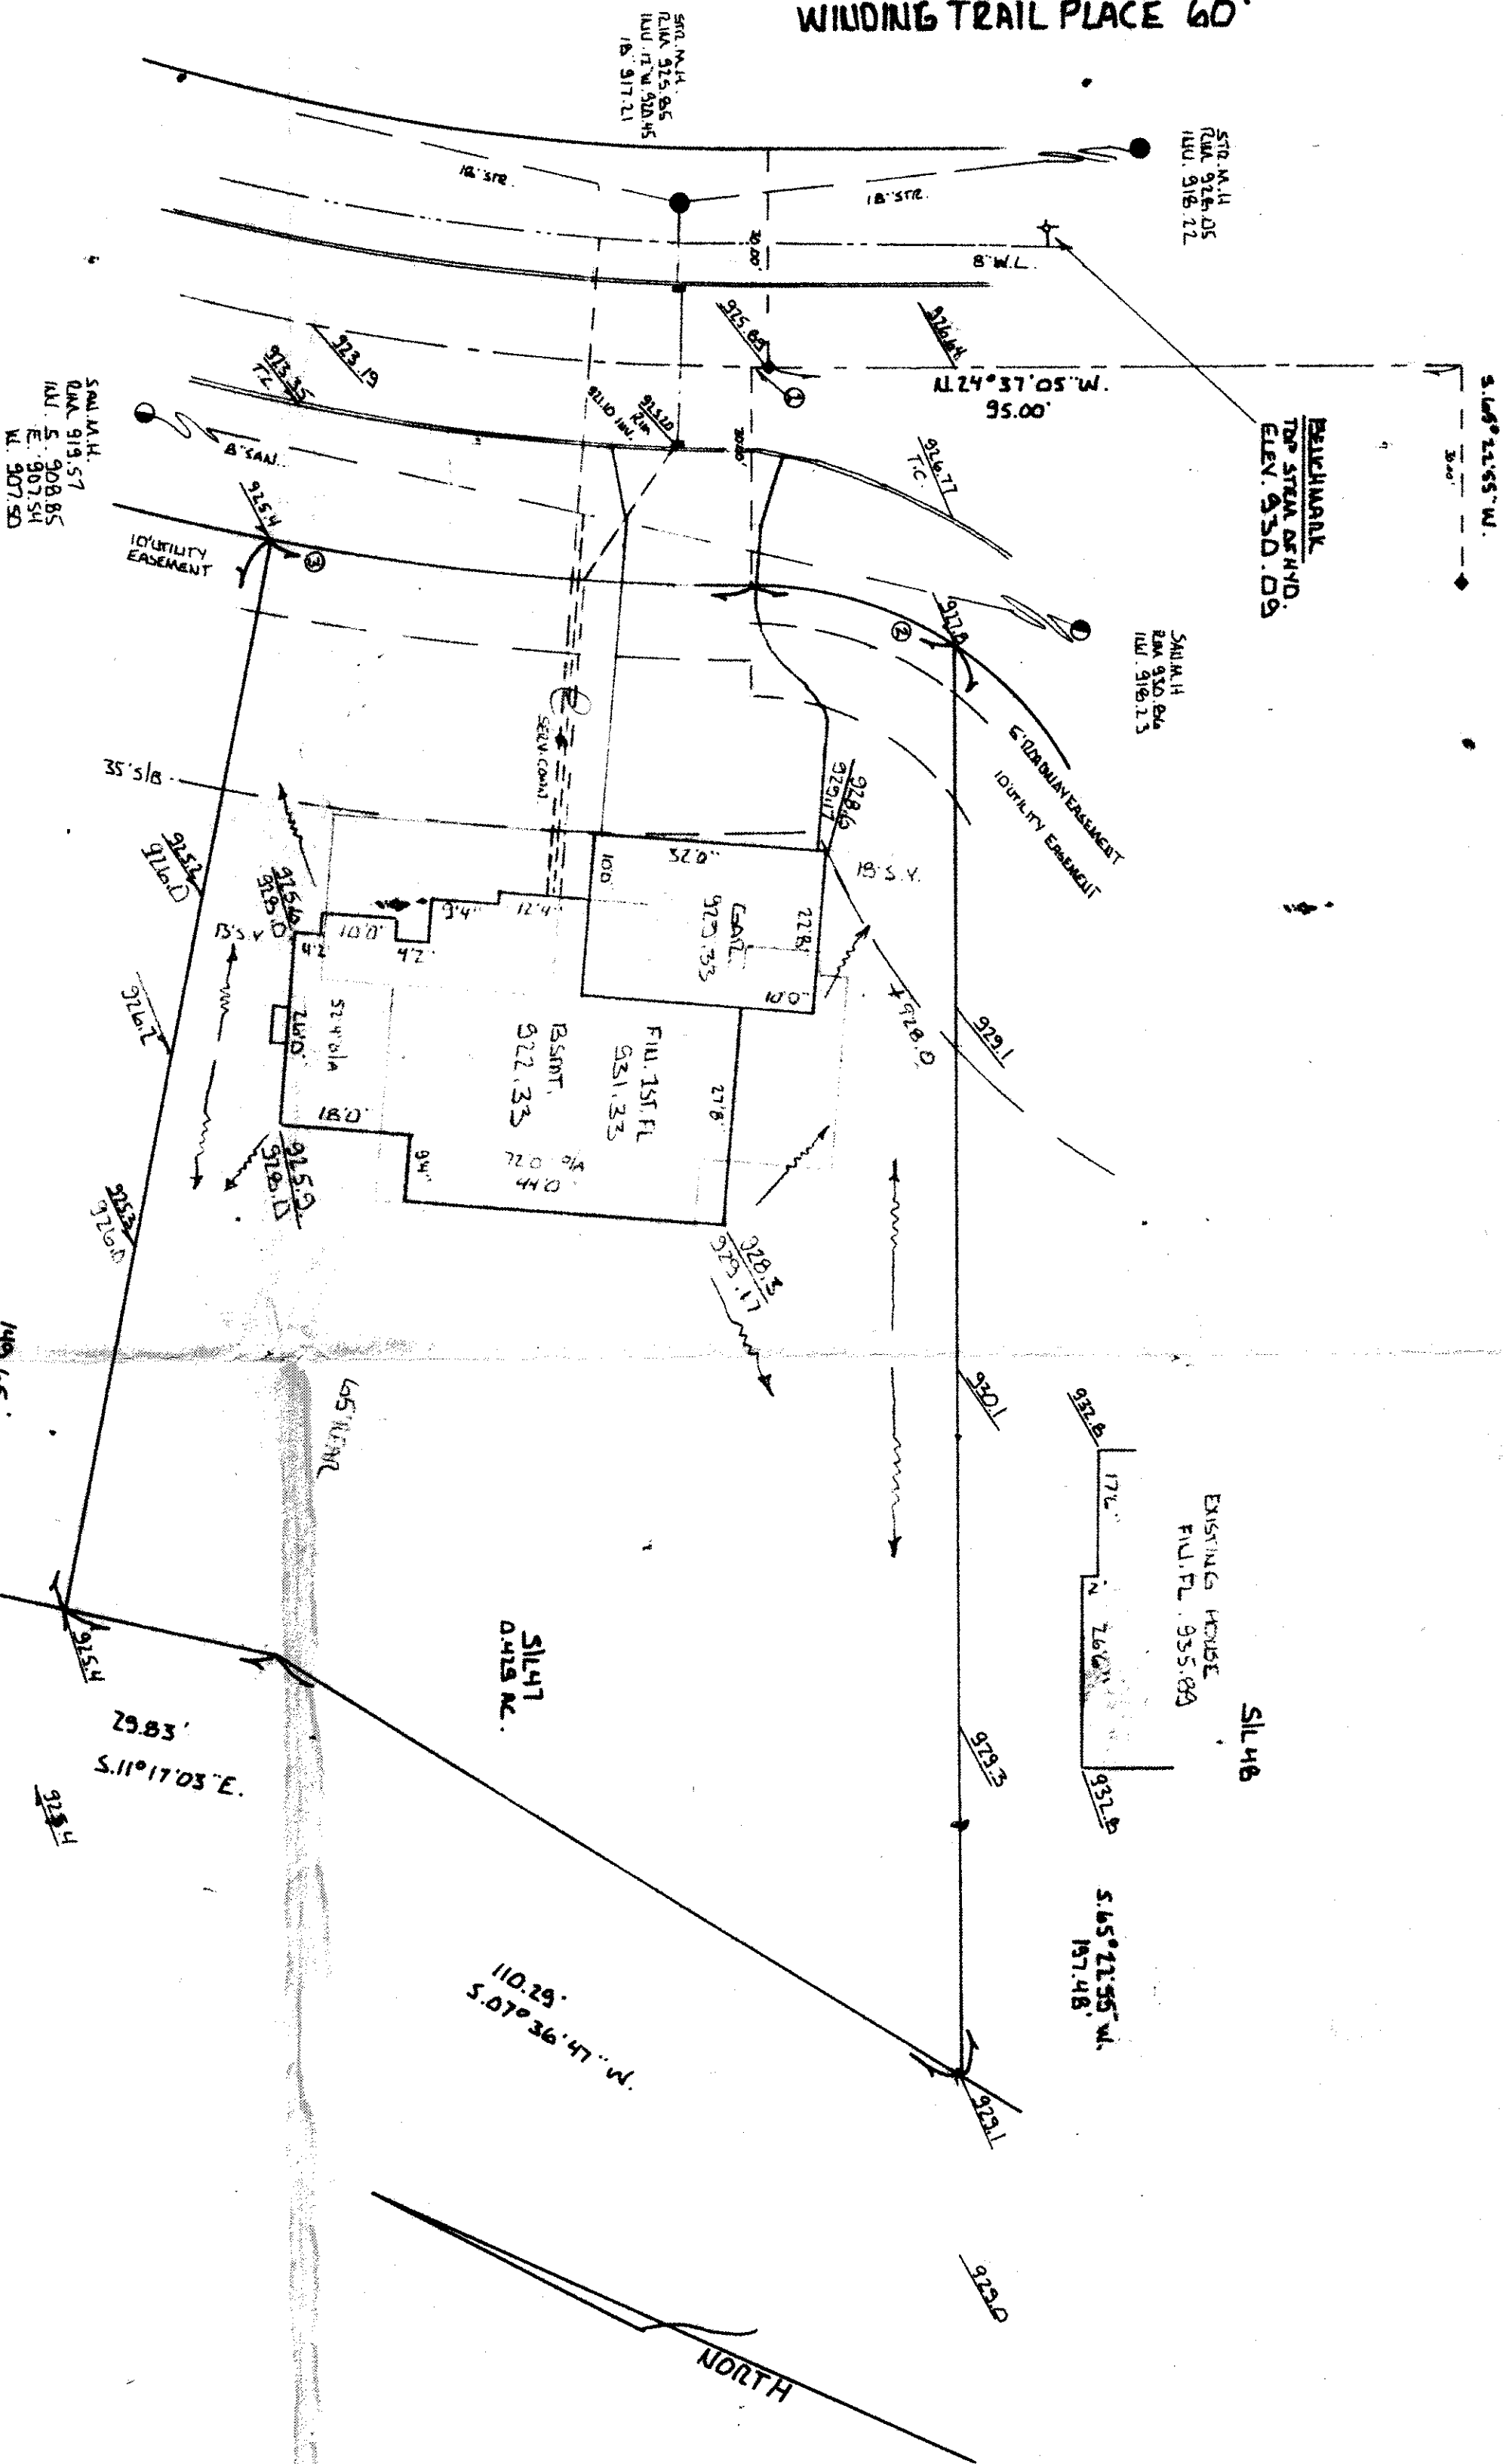

- CURVE DATA
1. A: 00° 16' 15"
A: 2.37'
C: 2.37'
N: 24° 13' 55.5" W.
L: 50.00'
A: 30° 13' 21"
A: 2.812'
C: 27.75'
N: 08° 03' 58" W.
 2. R: 300.00'
A: 11° 08' 41"
A: 66.13'
C: 66.13'
N: 18° 36' 16" W.

EXISTING GRADES
FURNISHED
BY SURVEY

SILVIA
VICINITY

149.65'
S. 71° 57' 55" W.

29.83'
S. 11° 17' 03" E.

SILVIA
0.415 AC.

110.25'
S. 07° 36' 47" N.

EXISTING HOUSE
FILL FL. 955.89


SILVIA

S. 65° 21' 35" W.
107.46'

I CERTIFY THAT THIS PLAN
WAS PREPARED BY ME AND
IS CORRECT TO THE BEST OF
MY KNOWLEDGE AND BELIEF.

JOHN C. SKONECZNY
REG. SURVEYOR #6338

JOHN C. SKONECZNY
7739 VIEWMOUNT DR.
PAINEVILLE, OHIO 44077
PH. 352-7742

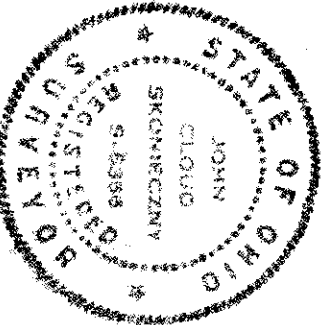

SITE PLAN FOR:
IDEAL AMERICAL HOMES INC.

SCALE: 1" = 20'

DATE: OCT. 1

APPROVED BY: F.J.H.

DESIGNED BY: F.J.H.

PROJECT: BEULG SUBLOT 47 IN THE GUAL HOLLAND SUBDIVISION NO. 2

TOWNSHIP OF CAYWOOD, COUNTY OF LAKE, STATE OF OHIO

JOB # 91-1325

Grading Plan Approved
by Thomas P. Gillet, P.E.
Lake County Engineer

By: J.H.
Date: 10/15/91

DISCHARGE SUMP PUMP TO
STW SERVICE.