
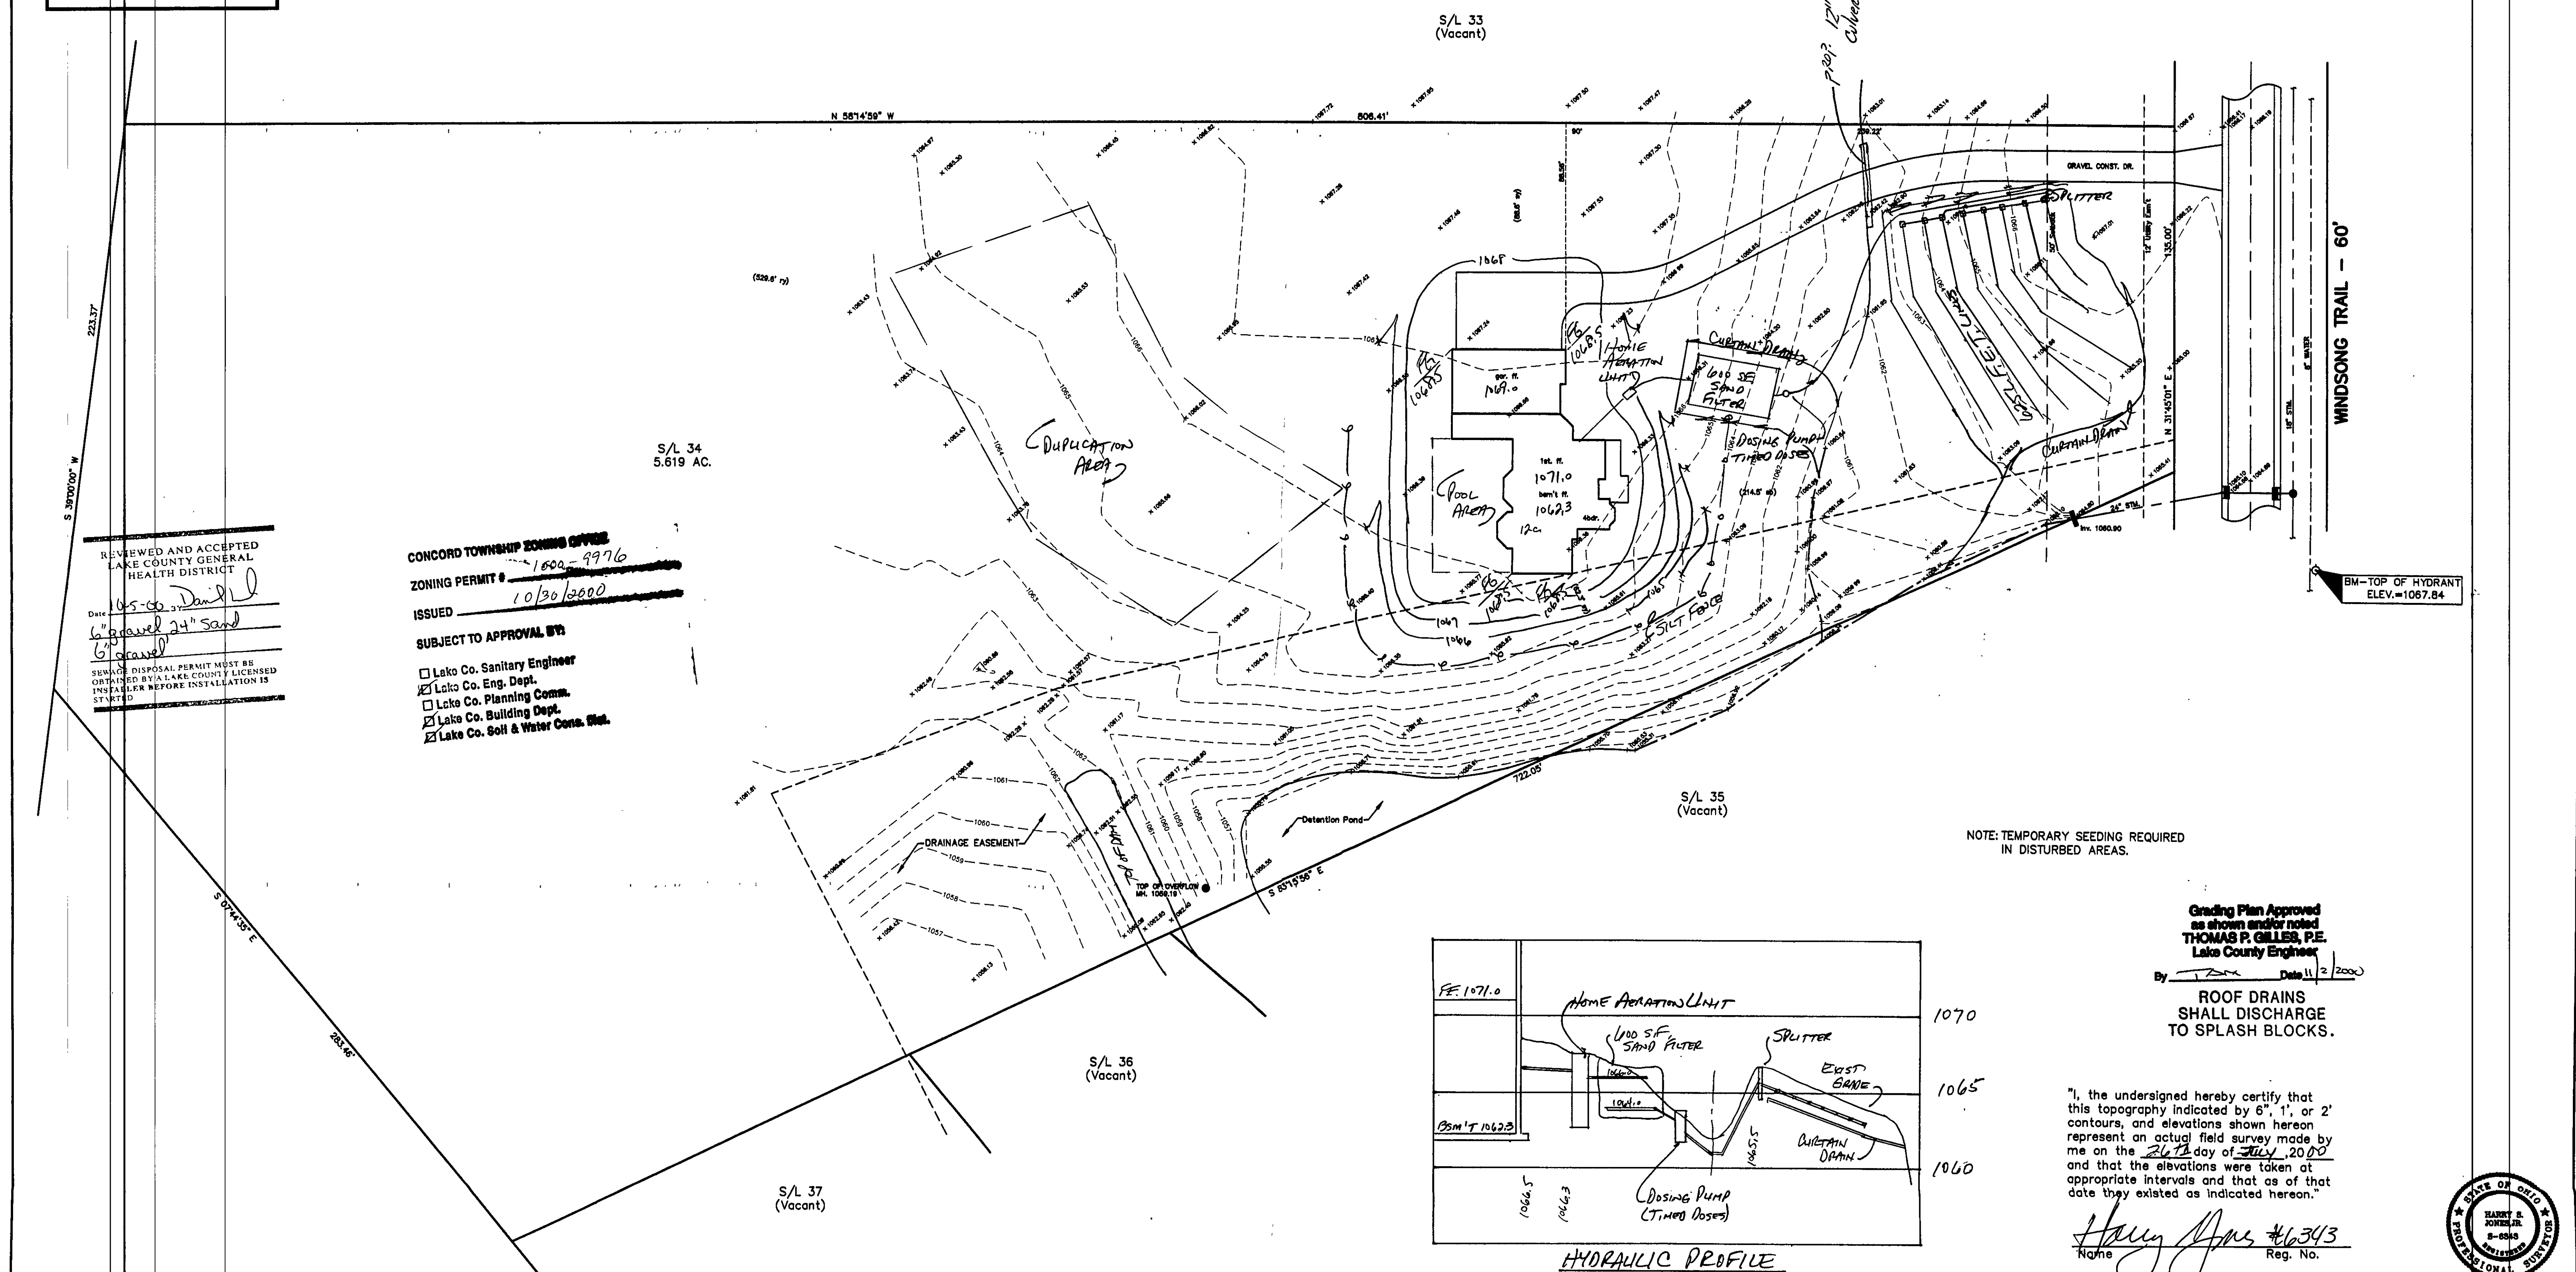
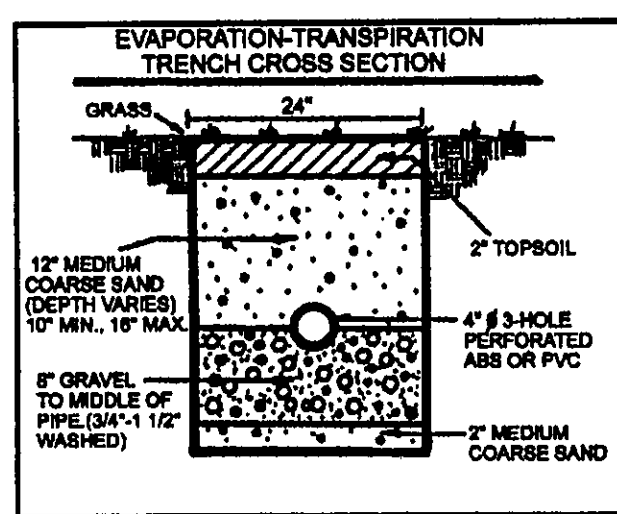


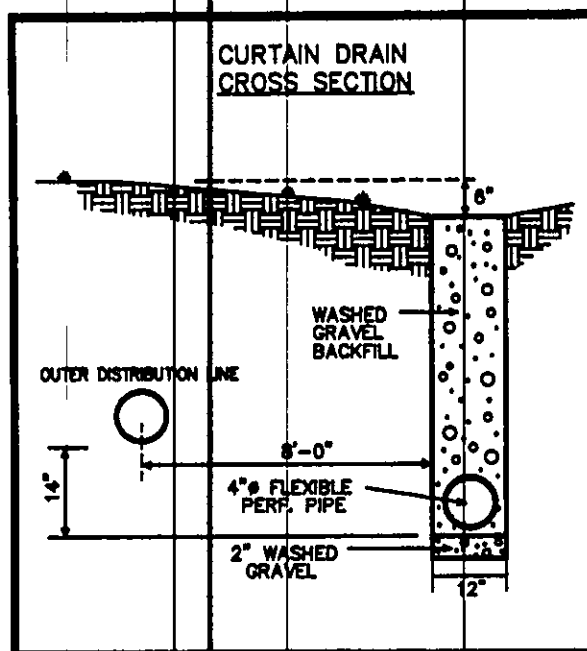


REVIEWED AND ACCEPTED
LAKE COUNTY GENERAL
HEALTH DISTRICT
Date 10-5-00
6" gravel 24" sand
6" gravel
SEWAGE DISPOSAL PERMIT MUST BE
OBTAINED BY A LAKE COUNTY LICENSED
INSTALLER BEFORE INSTALLATION IS
STARTED

CONCORD TOWNSHIP ZONING OFFICE
ZONING PERMIT # 1602-9976
ISSUED 10/30/2000
SUBJECT TO APPROVAL BY:
☐ Lake Co. Sanitary Engineer
☒ Lake Co. Eng. Dept.
☐ Lake Co. Planning Comm.
☒ Lake Co. Building Dept.
☒ Lake Co. Soil & Water Cons. Div.

NOTE: TEMPORARY SEEDING REQUIRED
IN DISTURBED AREAS.

Grading Plan Approved
as shown and/or noted
THOMAS P. GILLES, P.E.
Lake County Engineer
By [Signature] Date 11/2/2000
ROOF DRAINS
SHALL DISCHARGE
TO SPLASH BLOCKS.

"I, the undersigned hereby certify that
this topography indicated by 6", 1", or 2"
contours, and elevations shown hereon
represent an actual field survey made by
me on the 26th day of July, 2000
and that the elevations were taken at
appropriate intervals and that as of that
date they existed as indicated hereon."
[Signature] #6343
Name Reg. No.

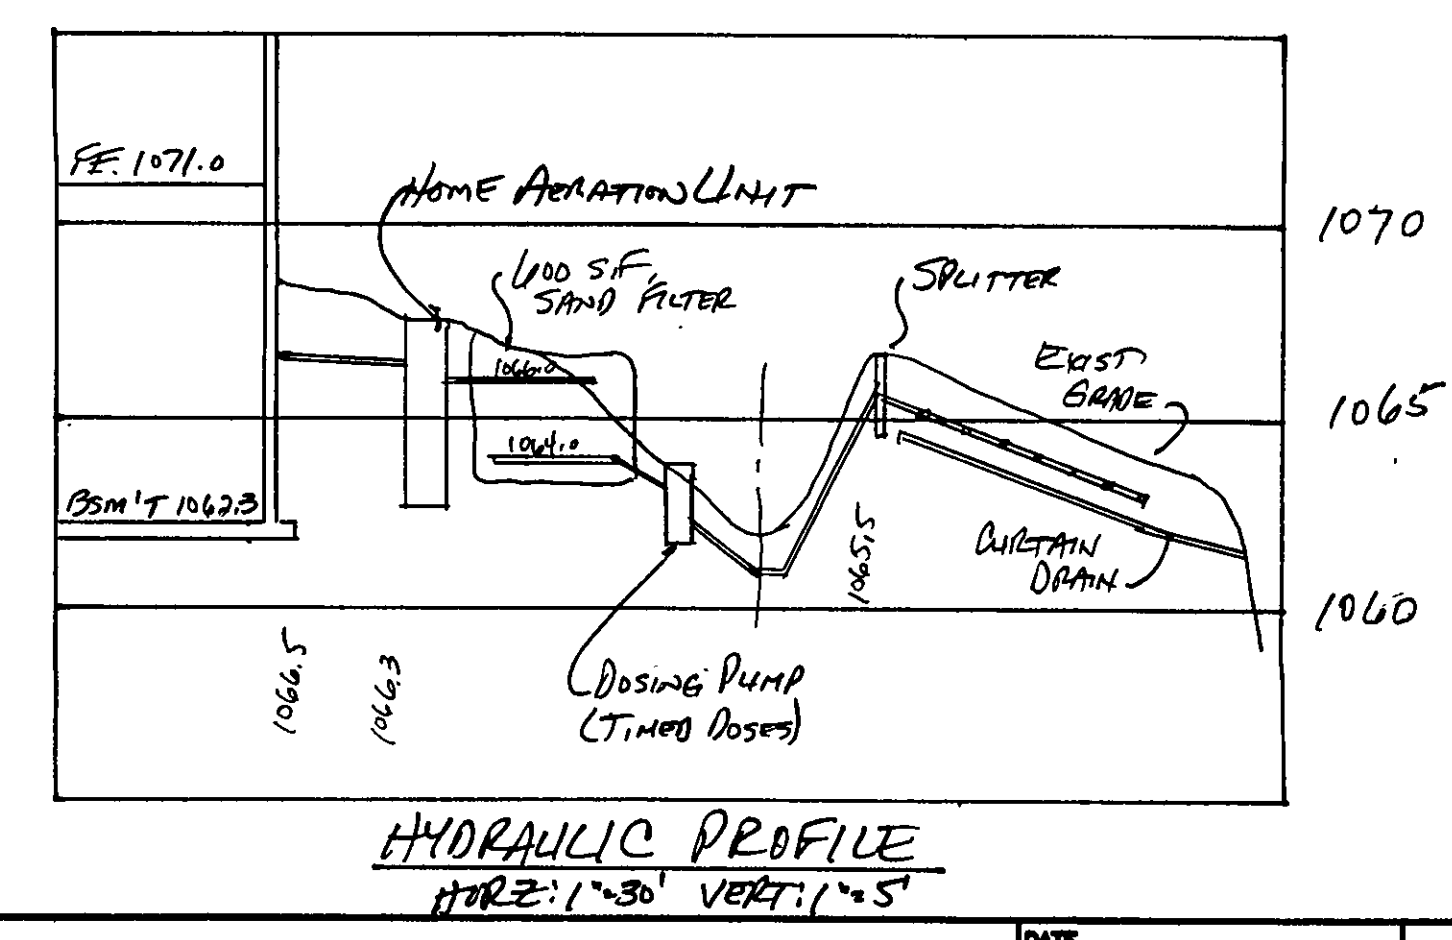

REV NO.	DESCRIPTION	DATE	BY	CHK'D
1	Revised septic system	10/5/00	HT	HT