

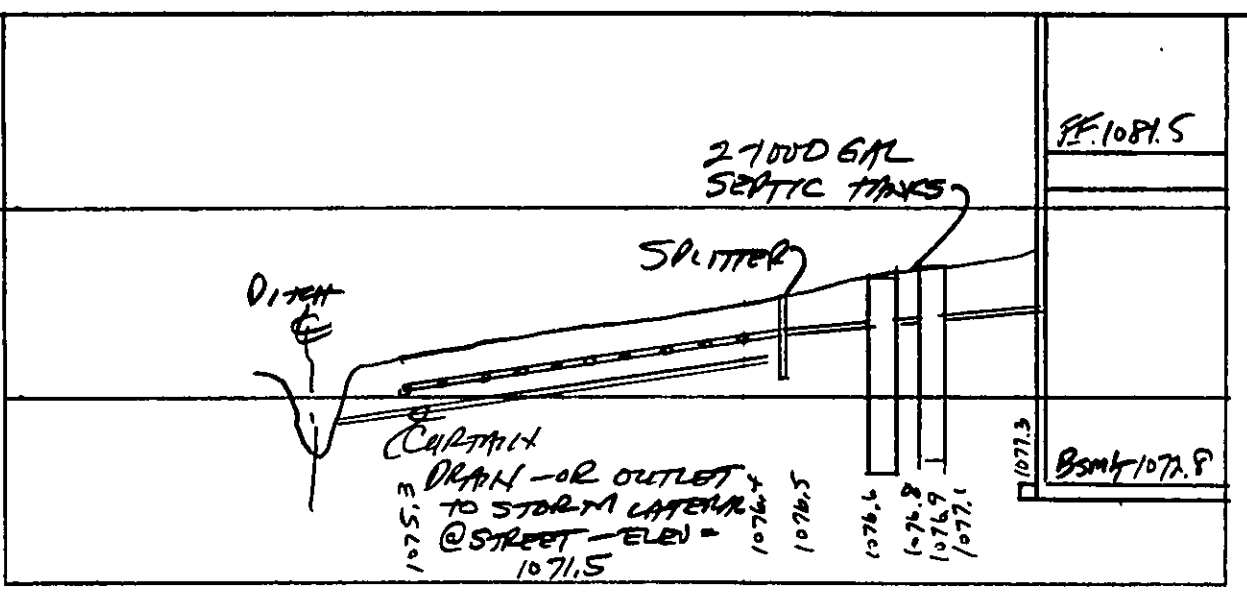
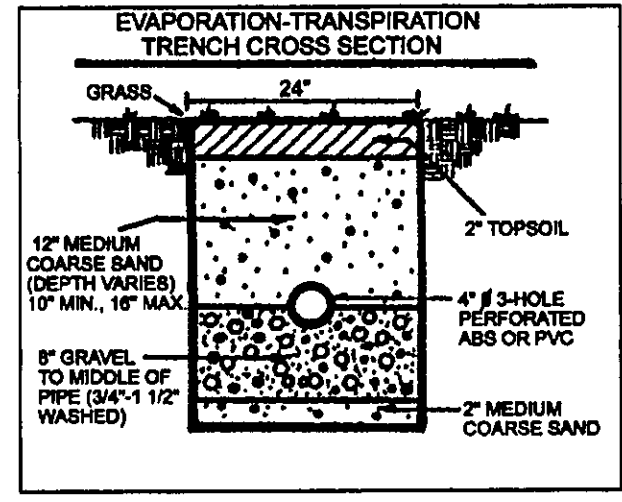
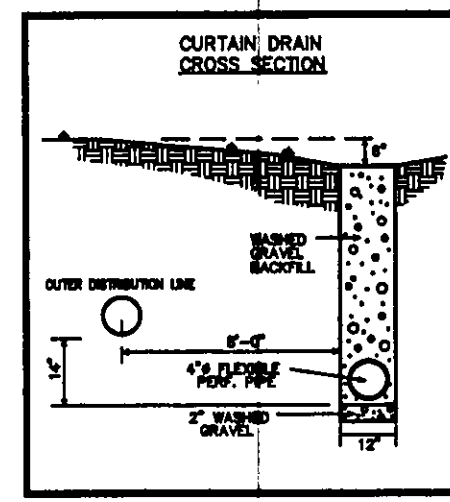


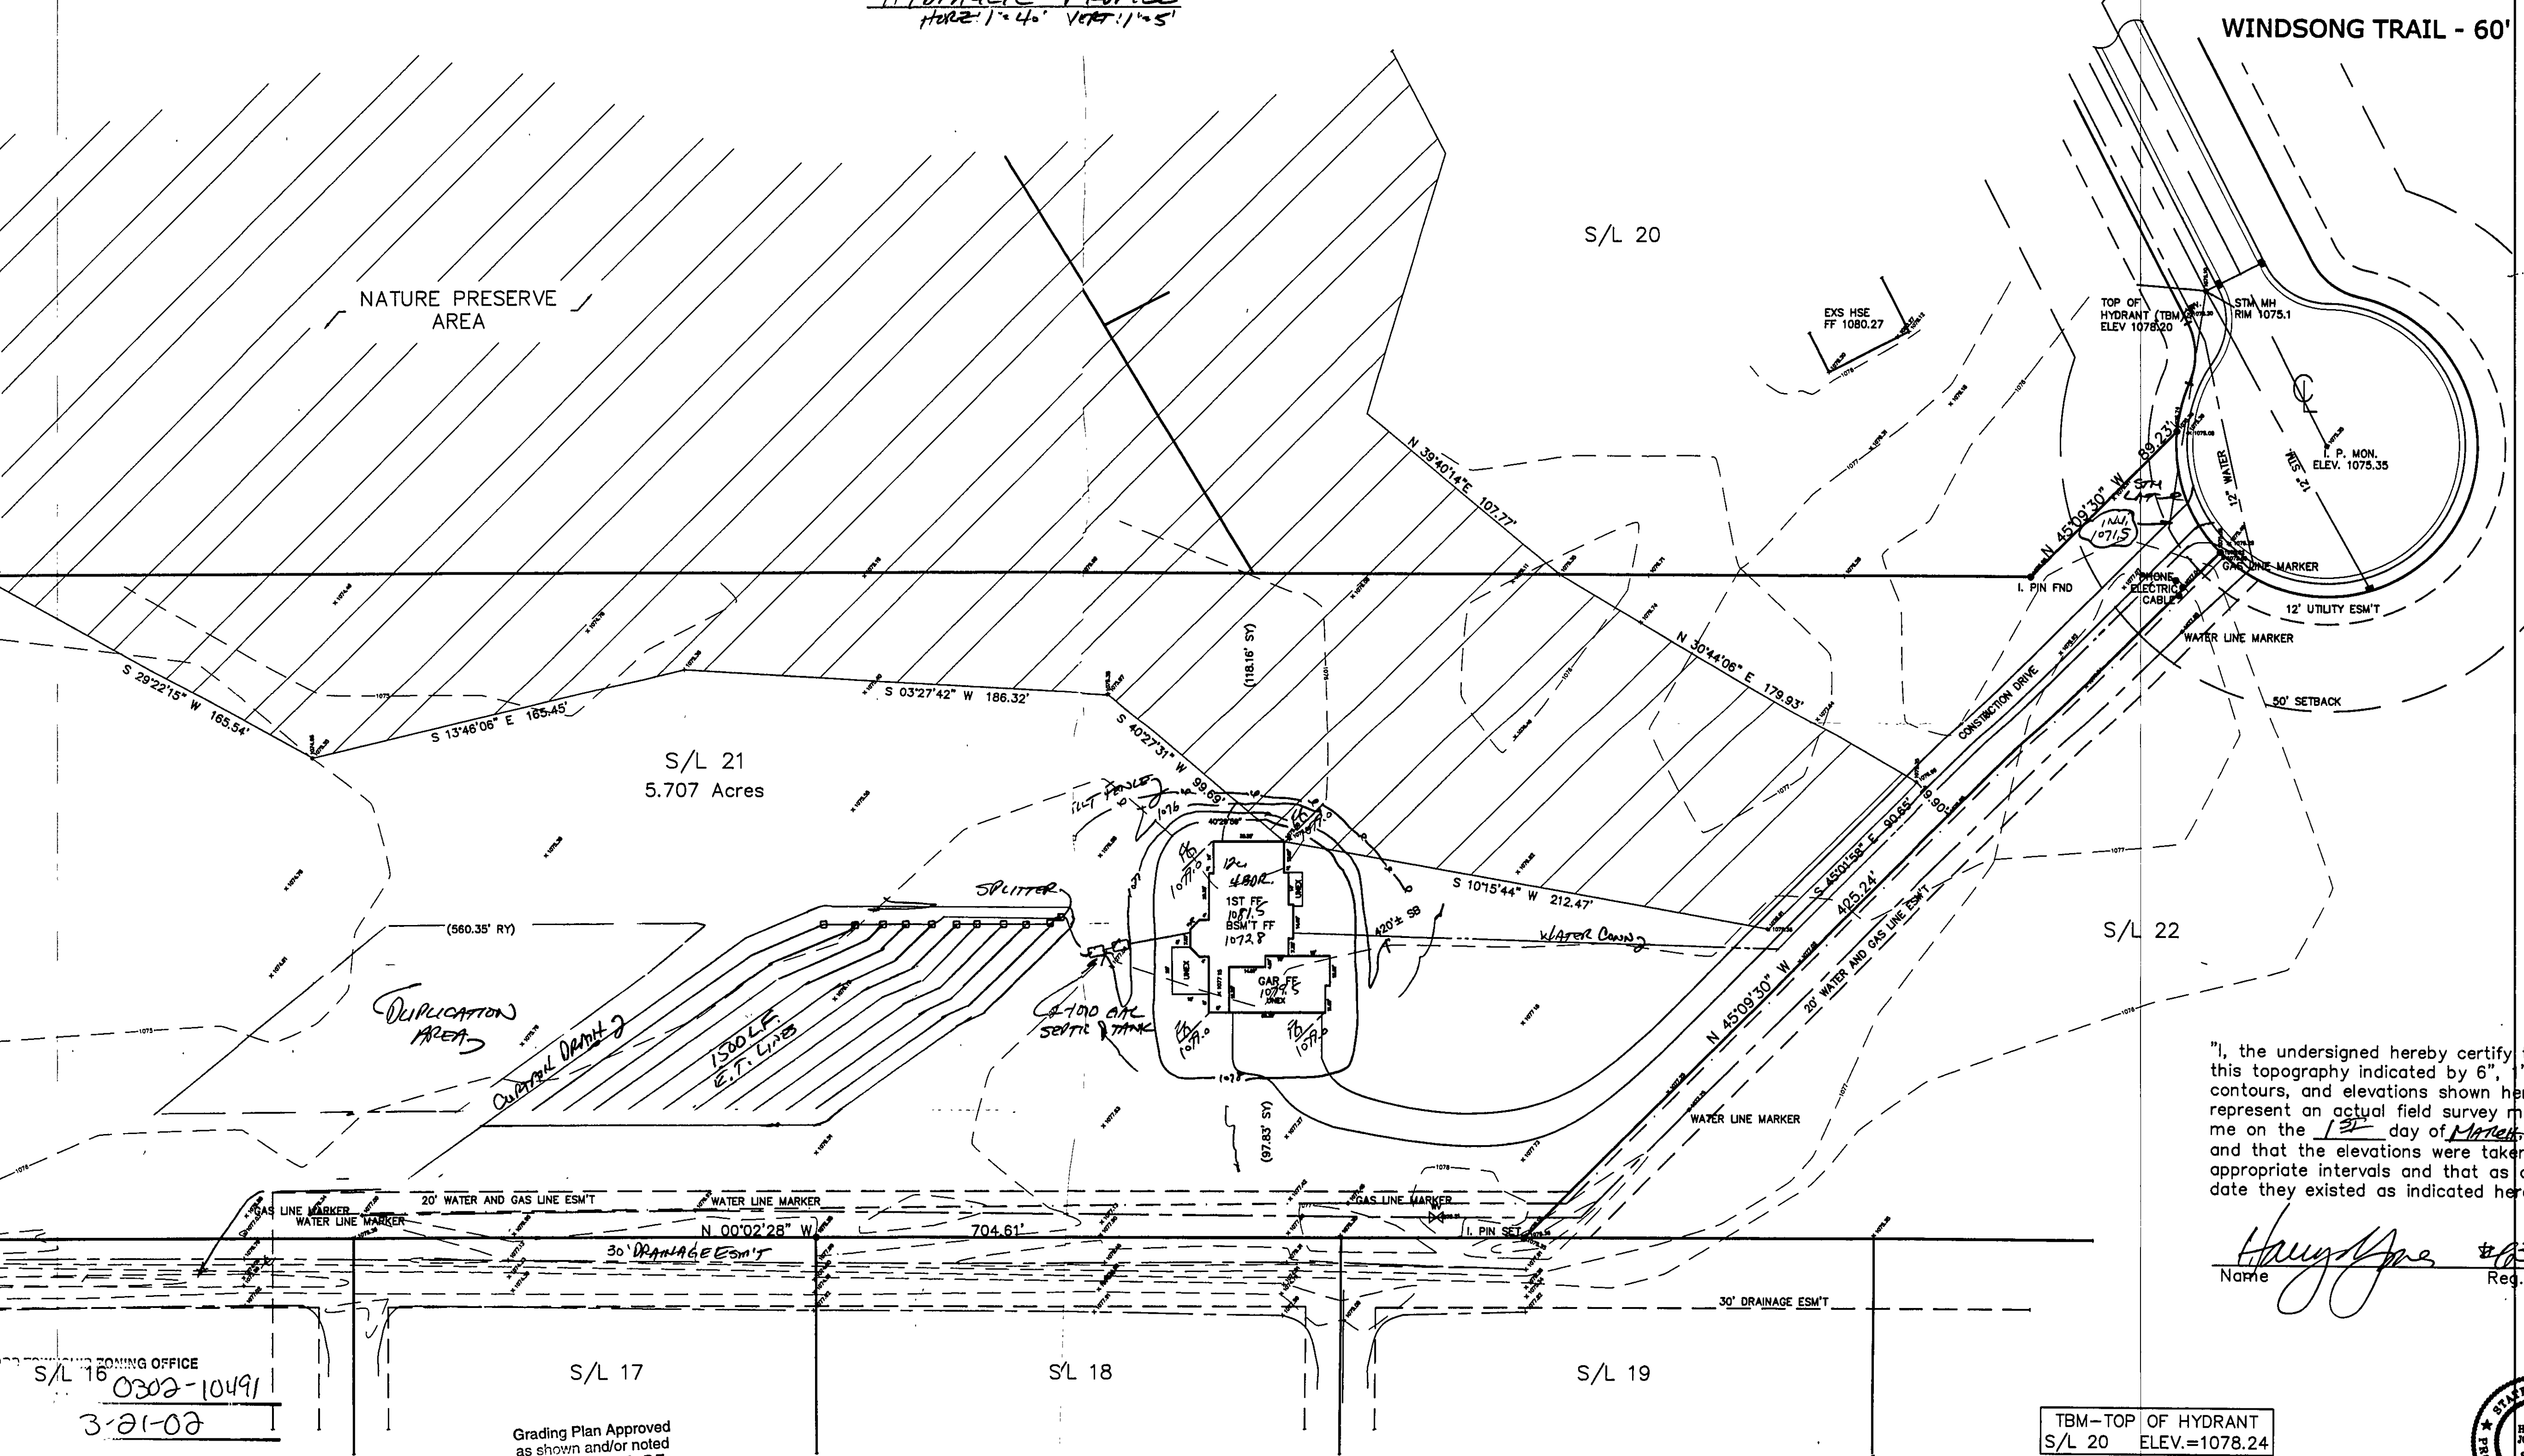

NOTE: TEMPORARY SEEDING REQUIRED IN DISTURBED AREAS.

HYDRAULIC PROFILE
HORIZ 1"=40' VERT 1"=5'

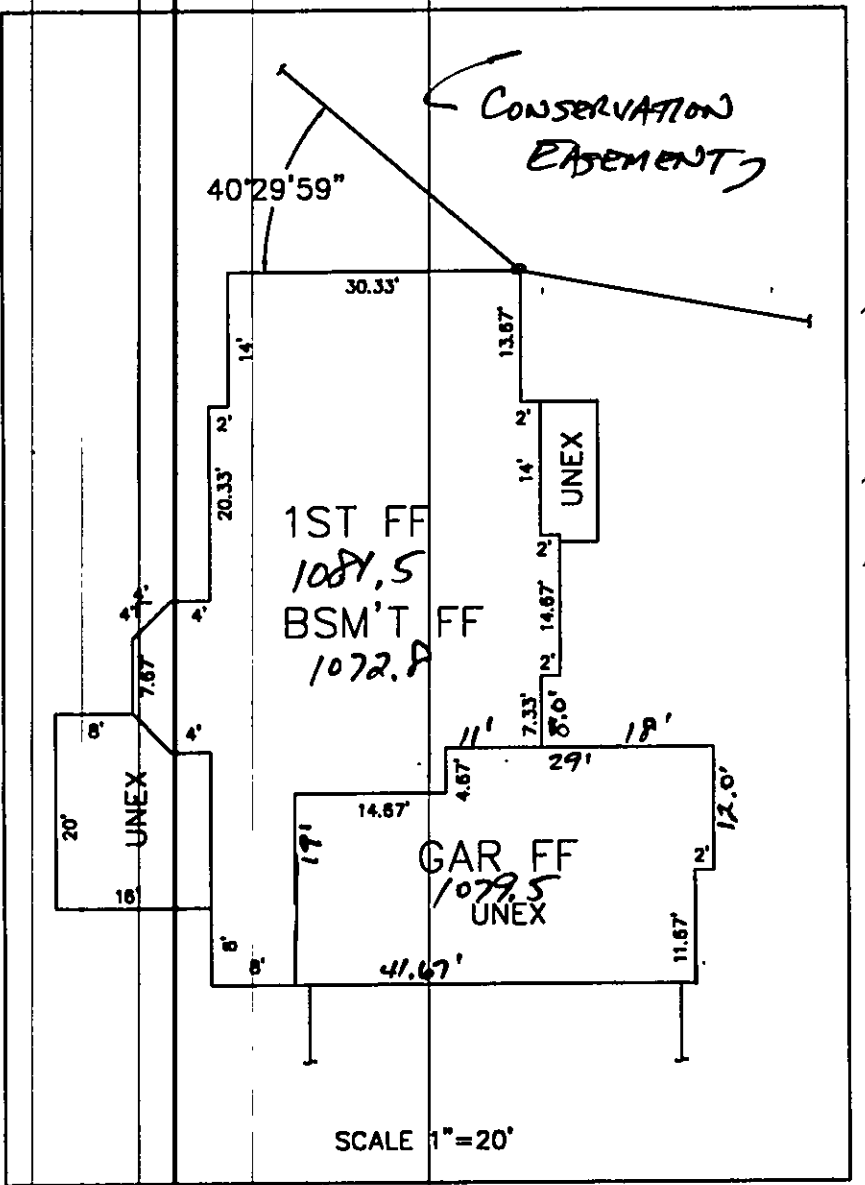

REVIEWED AND ACCEPTED
LAKE COUNTY GENERAL
HEALTH DISTRICT
Date 3/19/02 BY [Signature]

SEWER DISPOSAL PERMIT MUST BE
OBTAINED BY A LAKE COUNTY LICENSED
INSTALLER BEFORE INSTALLATION IS
STARTED

"I, the undersigned hereby certify that
this topography indicated by 6", 1" or 2"
contours, and elevations shown hereon
represent an actual field survey made by
me on the 13th day of March 2002
and that the elevations were taken at
appropriate intervals and that as of that
date they existed as indicated hereon."

Name [Signature] #1343
Reg. No.

CONCORD TOWNSHIP ZONING OFFICE
S/L 16 0302-10491
3-21-02
SUC [Signature]
DATE 3/21/02
BY [Signature]
DATE 3/21/02
BY [Signature]
DATE 3/21/02
BY [Signature]

Grading Plan Approved
as shown and/or noted
JAMES R. GILLS, P.E.
Lake County Engineer
By 614 Date 3/21/02

TBM-TOP OF HYDRANT
S/L 20 ELEV.=1078.24



REV NO.	DESCRIPTION	DATE	BY	CHK'D
1	REVISED SEPTIC	3-11-02	HT	HT

bj BABCOCK, JONES AND ASSOCIATES, INC
CIVIL ENGINEERS - SURVEYORS - LAND PLANNERS
PAINESVILLE OHIO 44077

DATE 4/6/02
DESIGN BY [Signature]
DRAWN BY B.P.
APPROVED BY H.J.

SITE PLAN
FOR
LEHTONEN
S/L 21 STANFORD SPRINGS SUB.
CONCORD TOWNSHIP
LAKE COUNTY

SCALE 1"=40'
JOB NO 98-185-21
SHEET 1 OF 1