


11

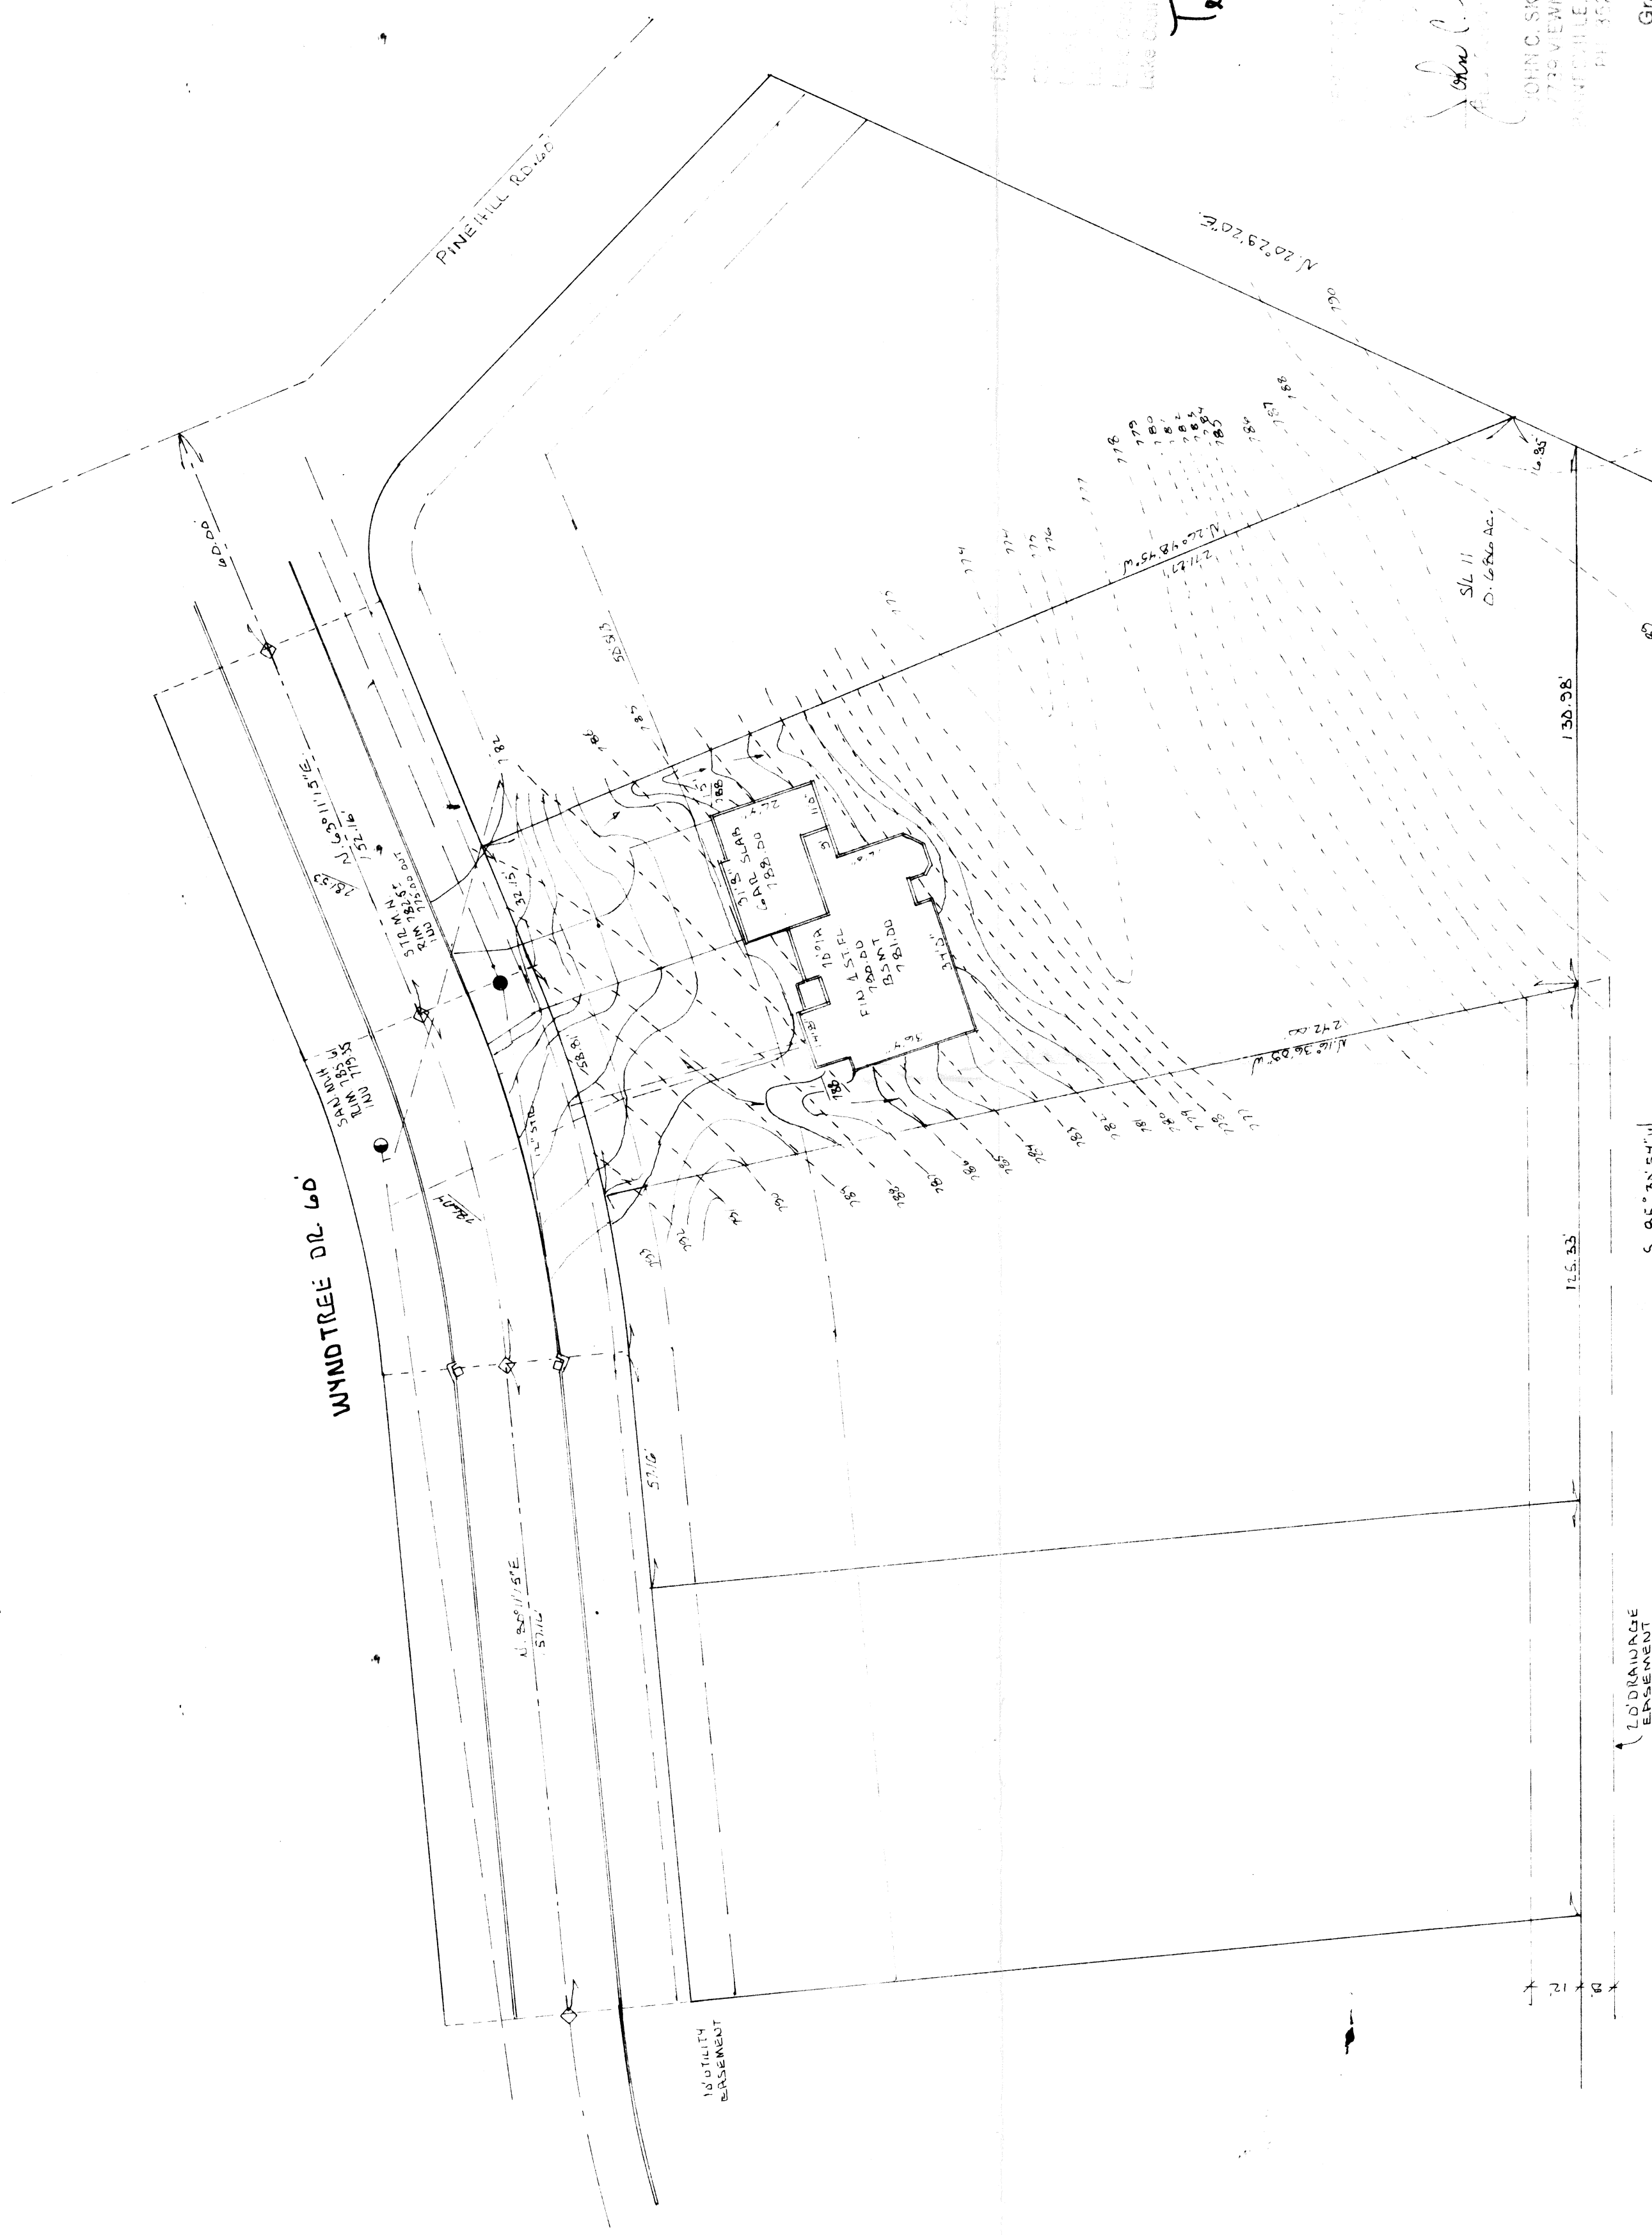

#5468
4-9-87

Teno S. Marano

John C. Skonieczny

JOHN C. SKONECZNY
7739 VERNAMOUNT DR.
PINE HILL, OHIO 44130
PH: 352-7742

Grading Plan Approved
as shown and/or noted
THOMAS P. GILLES, P.E.
Lake County Engineer

By John C. Skonieczny Date 4-13-87

SITE PLAN FOR: IDEAL AMERICAN HOMES INC.	
SCALE: 1" = 30'	APPROVED BY: <u>JCG</u>
DATE: APR 87	PLAT: <u>9-B-1</u>
BEING SUBLOT 10, 11, 12 & 13 IN THE WYNDTREE SUBDIVISION	
TOWNSHIP OF COLEBROOK COUNTY OF LAKE STATE OF OHIO	
DRAWING NUMBER: <u>87-536</u>	

NOTE: DRIVE LOCATION SHOULD
BE CHANGED SO TO AVOID
STW-SW.MH.

JOB Nos
SIL 10 87-611
SIL 11
SIL 12