


Handwritten signature/initials at the top left of the page.

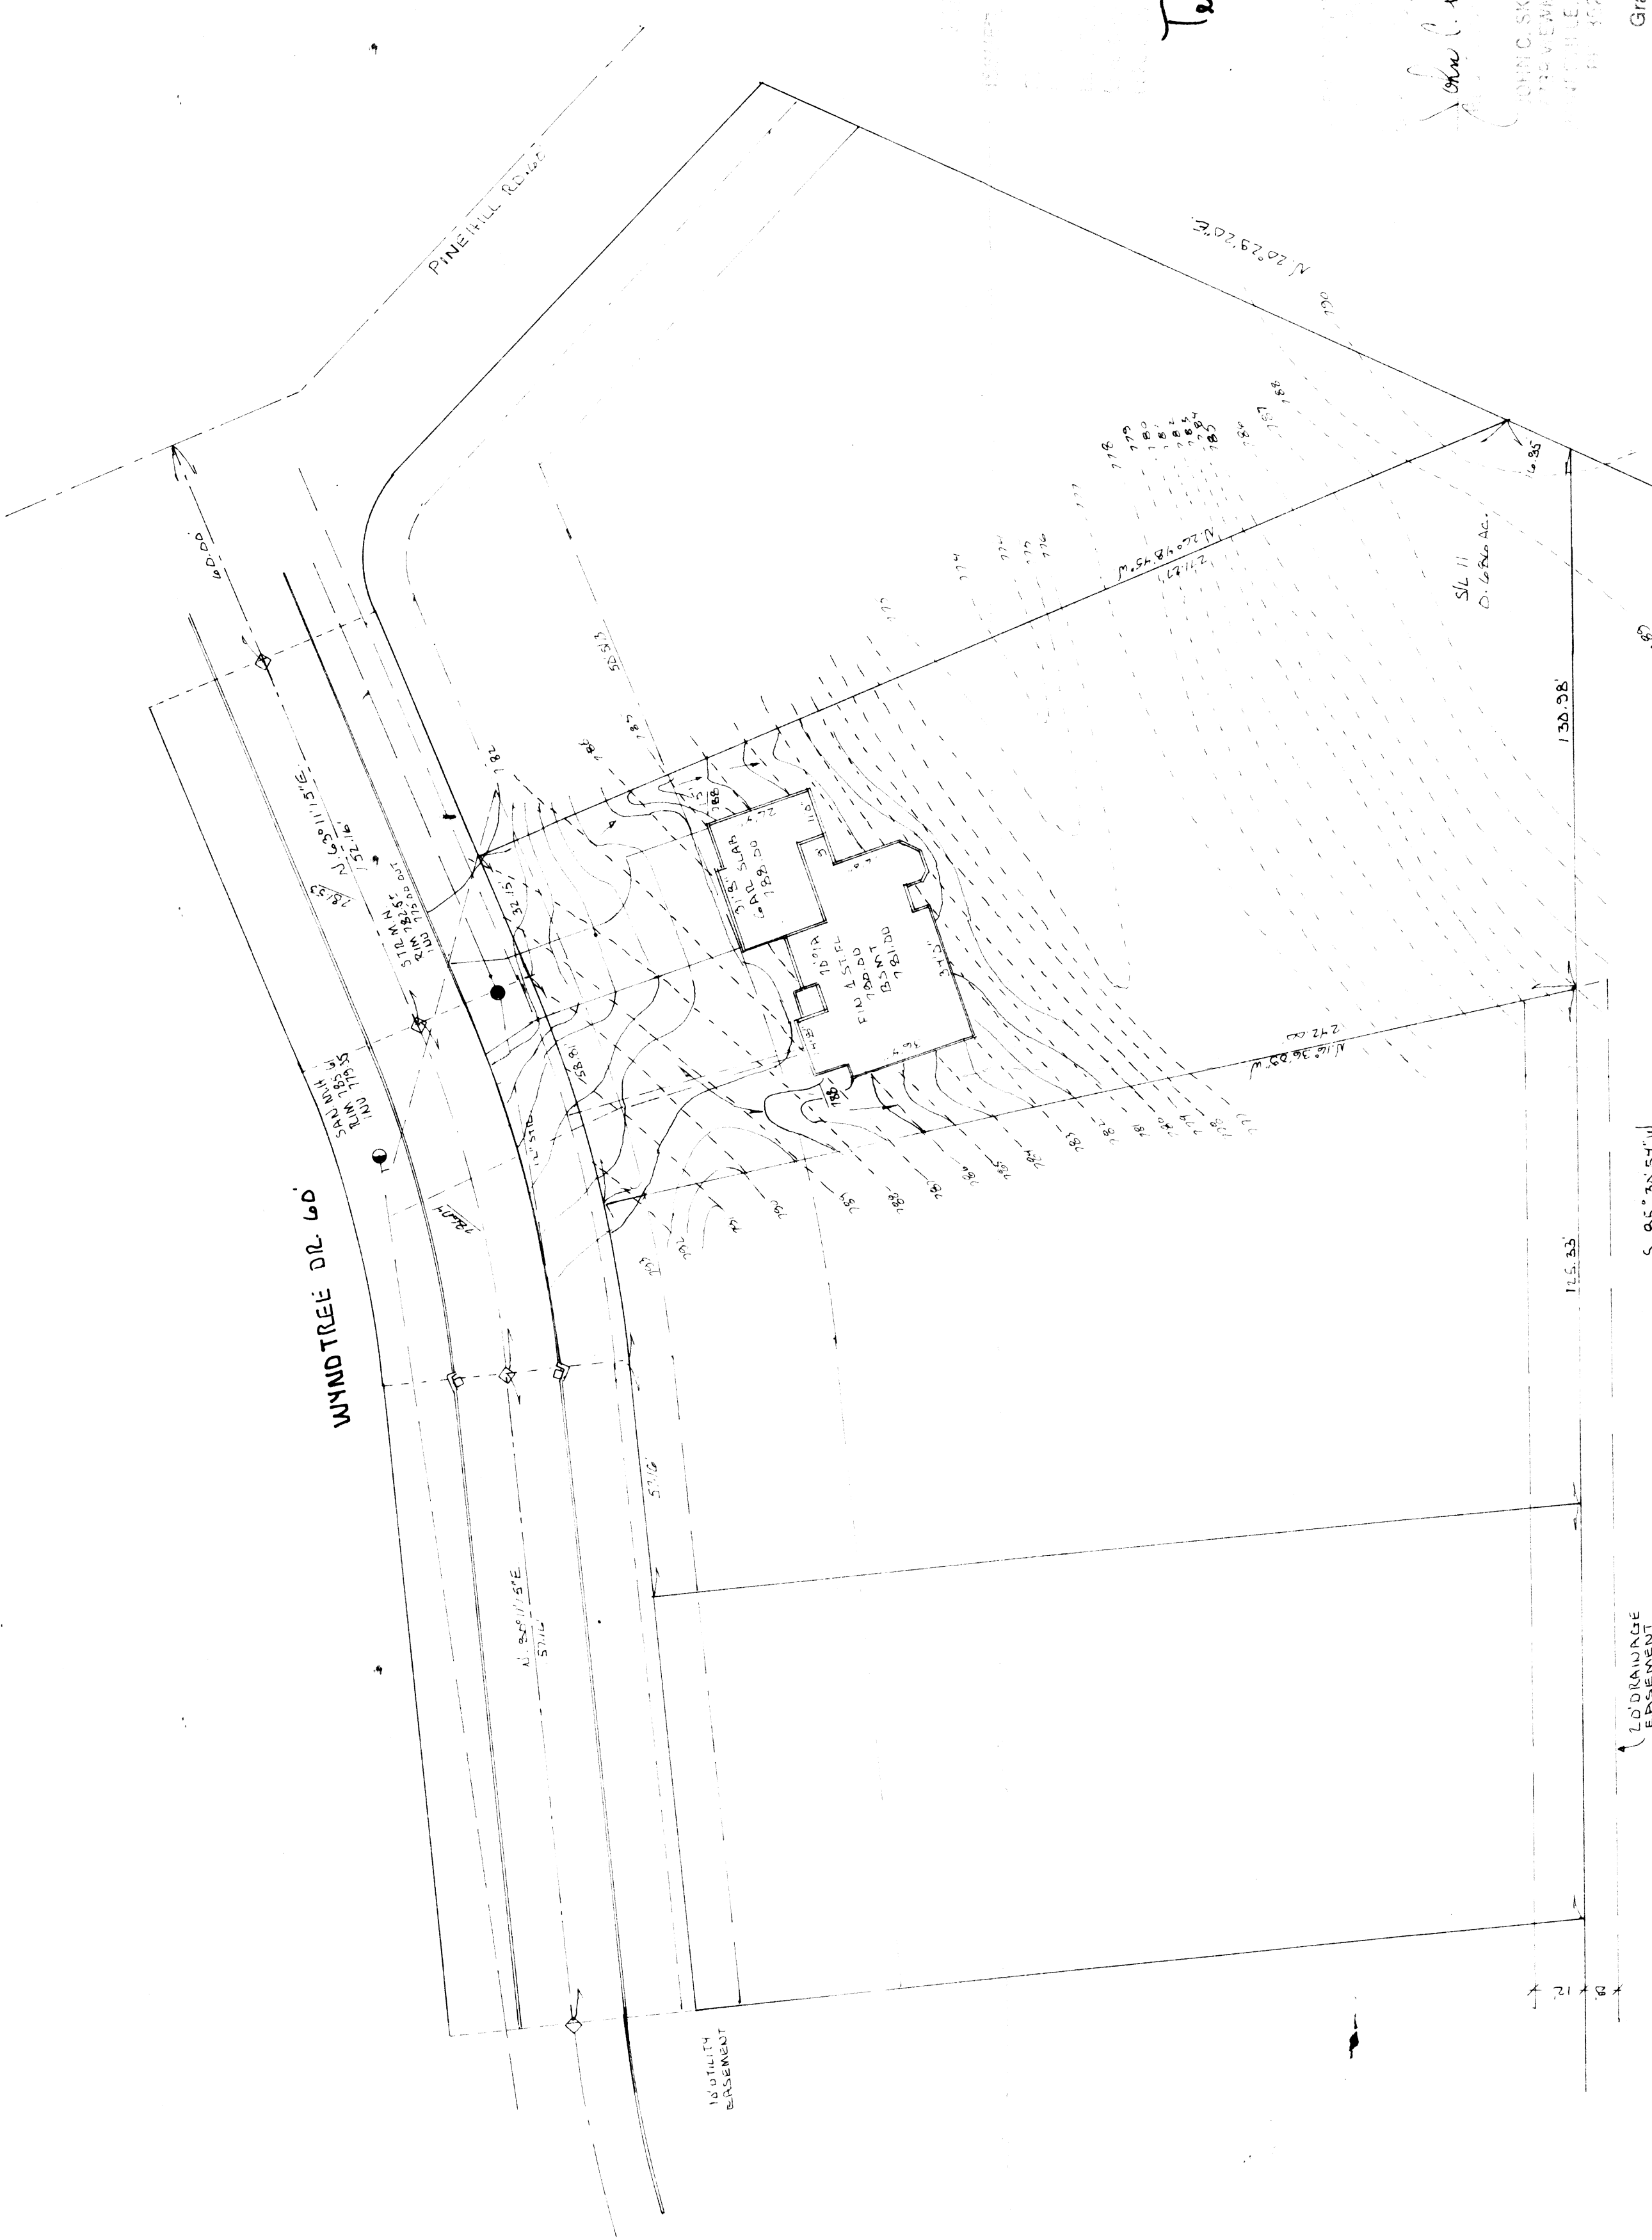

#5468
4-9-87
Teno S. Marano

John C. Skonieczny
JOHN C. SKONECZNY
STATE ENGINEER
1000 E. 10TH AVE.
CHICAGO, ILL. 60612

Grading Plan Approved
as shown and/or noted
THOMAS P. GILLES, P.E.
Lake County Engineer
BY *[Signature]* Date 4-13-87

NOTE: DRIVE LOCATION SHOULD
BE CHANGED SO TO AVOID
STW-SW.MH.

JOB Nos
SIL 10 87-611
SIL 11 87-612
SIL 12 87-613

SITE PLAN FOR: IDEAL AMERICAN HOMES INC.	
SCALE: 1"=30'	APPROVED BY: JCL
DATE: APR. 87	PLAT: 9-8-1
BEING SUBLOT 10, 11, 12 & 13 IN THE WINDTREE SUBDIVISION	
TOWNSHIP OF COOK COUNTY OF LAKE STATE OF OHIO	
DRAWING NUMBER: 87-536	