


Handwritten signature/initials.

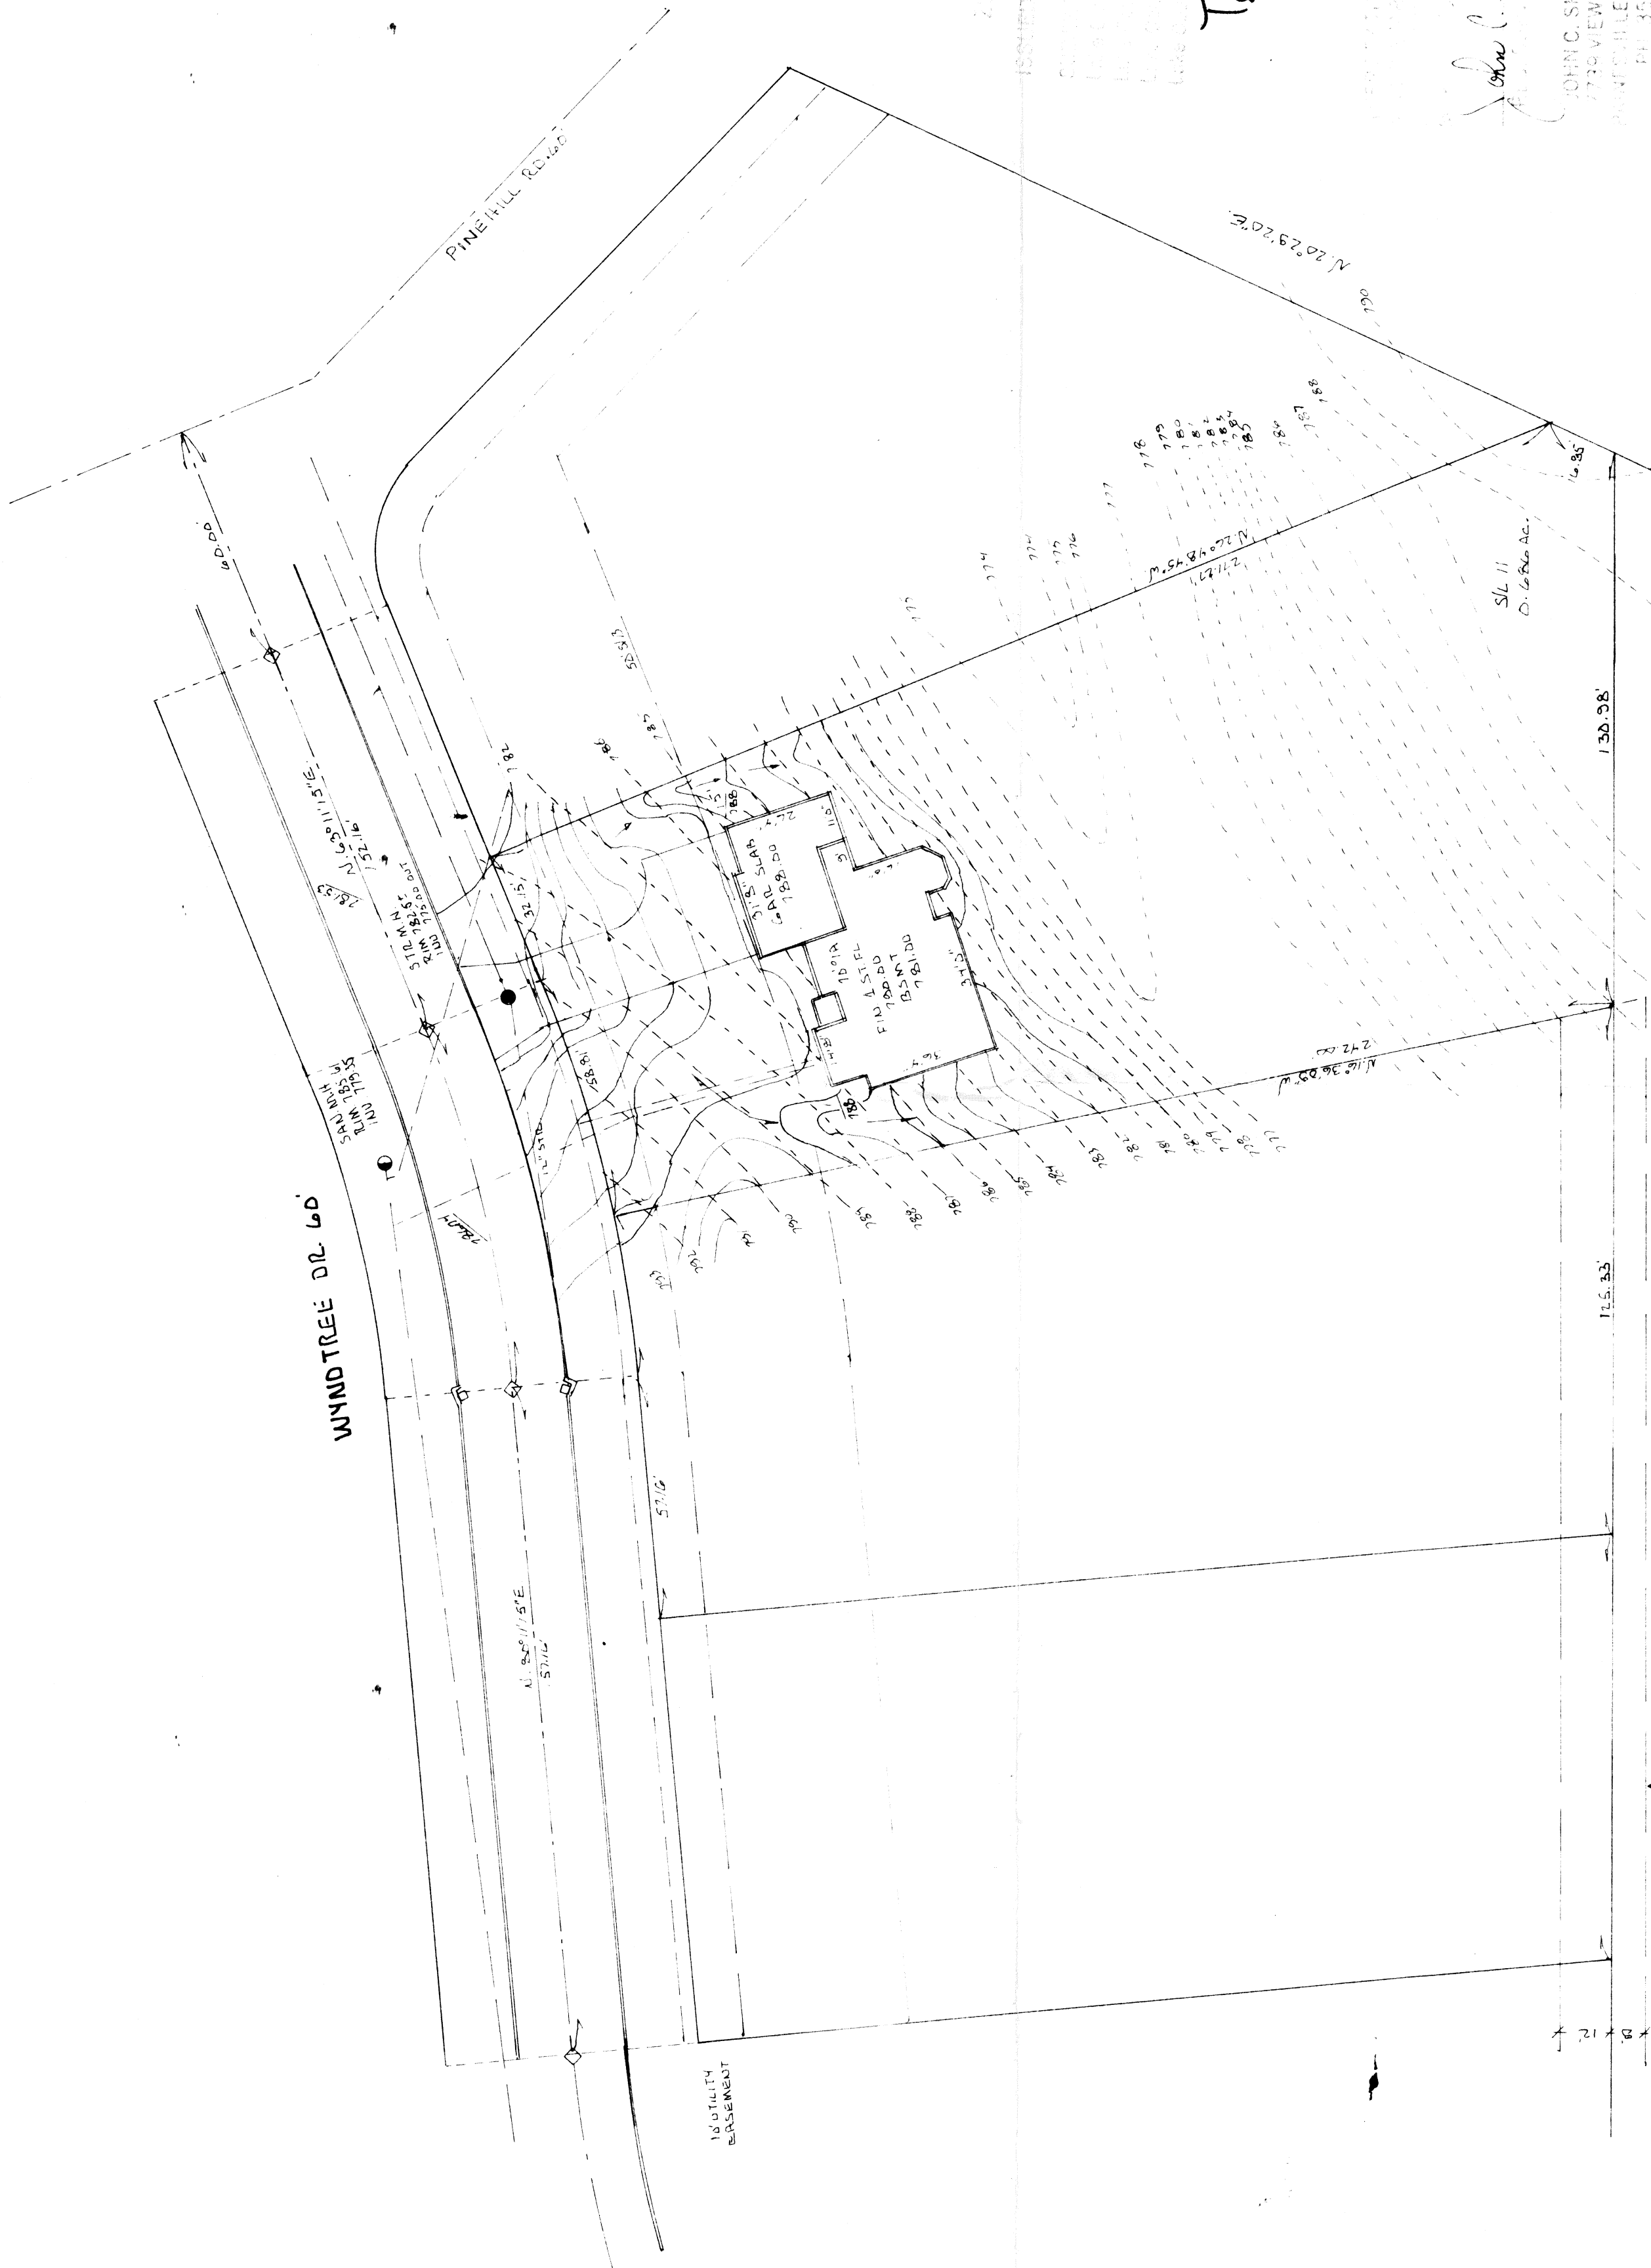

NOTE: DRIVE LOCATION SHOULD BE CHANGED SO TO AVOID STAY SW. MH.

JOB Nos.
S/L 10 8-7-611
S/L 11 8-7-611
S/L 12 8-7-611
S/L 13 8-7-611

#5468
4-9-87

Temo S. Marano

John C. Skonieczny

JOHN C. SKONECZNY
7730 VIEWMOUNT DR.
AVONESHIRE, OHIO 44007
PH: 452-3742

Grading Plan Approved
as shown and/or noted
THOMAS P. GILLES, P.E.
Lake County Engineer

By *[Signature]* Date 8-13-87

EXISTING GRADES
PROPOSED

SITE PLAN FOR:
IDEAL AMERICAN HOMES INC.

SCALE: 1" = 30'	APPROVED BY	DRAWN BY JCL
DATE: APR. 87		PLAT 9-8-1
BEING SUBLOT 10, 11, 12 & 13 IN THE WYNDTREE SUBDIVISION		
TOWNSHIP OF COLEBROOK COUNTY OF LAKE STATE OF OHIO		