
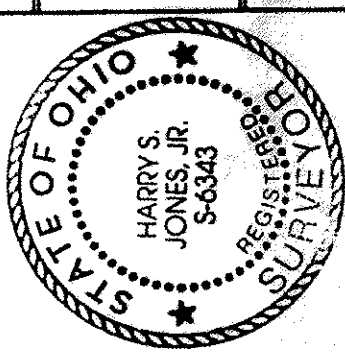


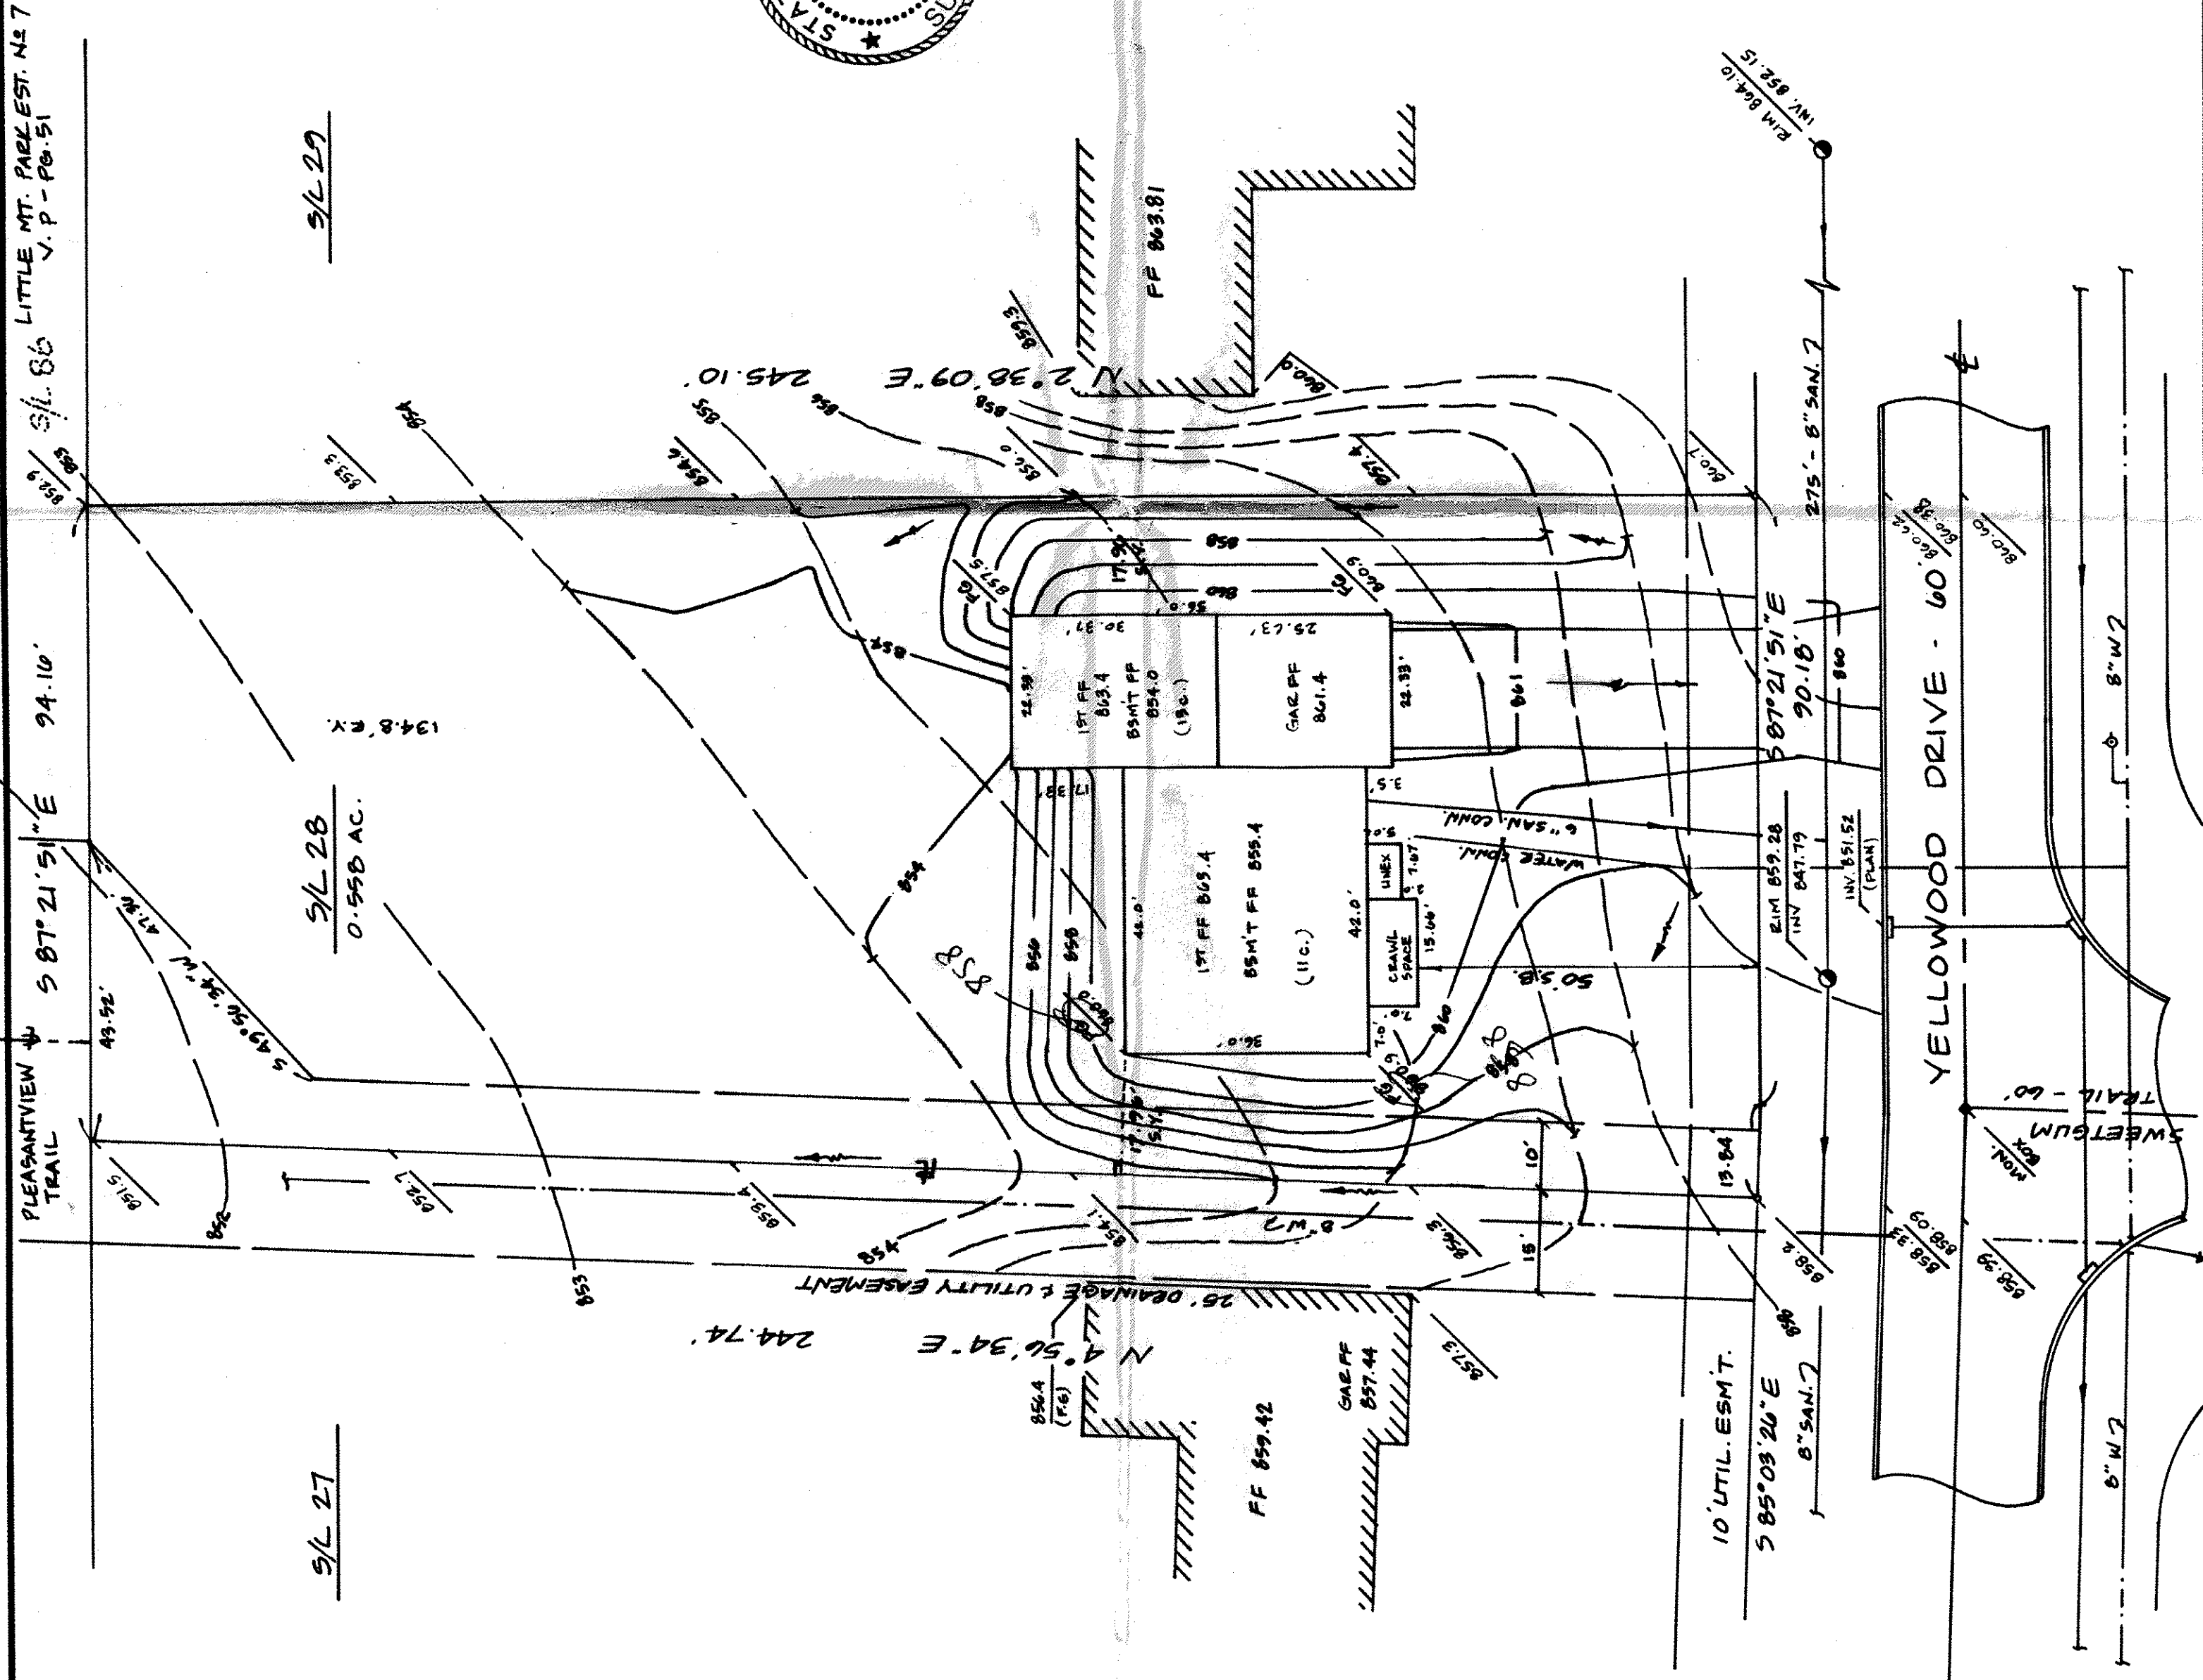

SITE PLAN

CONCORD TOWNSHIP, LAKE COUNTY, OHIO

for: **SHANDLE BUILDERS**

CLIENT _____ OWNER _____

ADDRESS _____ STREET _____ CITY _____ ZIP _____	
LOT _____ TRACT _____	
VOLUME _____ PAGE _____	
PERM. PARCEL NO. _____ STREET _____	
SUBLOT NO. _____	
SUBDIVISION NAME #48	
VOL. 13-32	
PAGE 20	
SUBLOT NO. 20	
YELLOWWOOD DR.	

LEGEND

SANITARY MANHOLE	WATER VALVE (GAS)
STORM MANHOLE	WATER METER (GAS)
INLET OR CATCH BASIN	AS BUILT ELEVATION
HYDRANT	INDICATES DIRECTION OF SURFACE DRAINAGE
EXISTING CONTOURS	
PROPOSED CONTOURS	
EXIST. ELEV. 100.0	PROP. ELEV. 100.0

REMARKS

ALL BOUNDARY DATA SHOWN WAS OBTAINED FROM (DEEDS, RECORDED SUBDIVISION PLAT OR OTHER PUBLIC RECORDS)

LOCATIONS AS SHOWN OF ADJACENT WELLS AND SEPTIC TANKS OBTAINED FROM LAKE COUNTY HEALTH DEPARTMENT

DESIGN CERTIFICATION

THIS PLAT WAS PREPARED BY ME, AND IS CORRECT TO THE BEST OF MY KNOWLEDGE AND BELIEF.

NAME Harry S. Jones, Jr. REGISTRATION NO. S-6343

CHECK LIST

NO. OF BEDROOMS	WATER MAIN SIZE, LOCATION
DIMENSIONS	SAN. SEWER SIZE, % GR. LOC.
TIE TO NEAREST STREET	SAN. MH. CAST. ELEV. INV. ELEV.
SUBLOT NO. PARCEL NO.	SAN. CONN. SIZE, LOC. DEPTH
SURROUNDING OWNERS	STORM SEWER SIZE, % GR. LOC.
BLDG. DIMENSIONS FIN. GR.	STORM MH. CAST ELEV. INV. ELEV.
BLOG. TIES ELEV. GRADES	PAV'T TYPE GRADE CURBS
APRON TYPE WIDTH THICKNESS	GAS LINE LOC. SIZE PRESSURE
CULVERT TYPE DIA. LENGTH	SEPTIC TANK LOCATION & DUPLICATION AREA
ROCK OUTCROPPINGS	WELL LOCATION
	ISOLATION RADIUS FROM WELL

PLAN PREPARED BY:

BABCOCK • JONES & ASSOCIATES, INC.

PAINESVILLE, OHIO

REVISIONS	NO.	DATE	BY
1	1/27/95	6	
2			
3			
4			
5			

DRAWN BY	SCALE	PHONE NO.
4	1" = 20'	357-1811
CHK'D.	DATE	DRAWING NO.
1/1	JAN. 5, 1995	
CREW	APP'D.	
BB	HT	91-009-28

"AS BUILT" CERTIFICATION

I, HEREBY CERTIFY THAT THE CIRCLED GRADES ARE EXISTING FINISH GRADES CHECKED IN THE FIELD ON _____, 19____, AND ARE CORRECT TO THE BEST OF MY KNOWLEDGE AND BELIEF.

REGISTERED SURVEYOR _____ REG. NO. _____

BENCHMARK: RIM SAN MH 5/L 30 ± 31. ELEV. = 864.10

Harry S. Jones, Jr.
P. O. Box 12795
Painesville, OH 44130
Professional Engineer
No. 12795

FINISHED GRADES ON WEST SIDE SHALL BE 858.0.