


W:\2008\0006756\01\00128.dwg, 5/19/2010 10:02:32 AM, Copyright Barrington Consulting Group

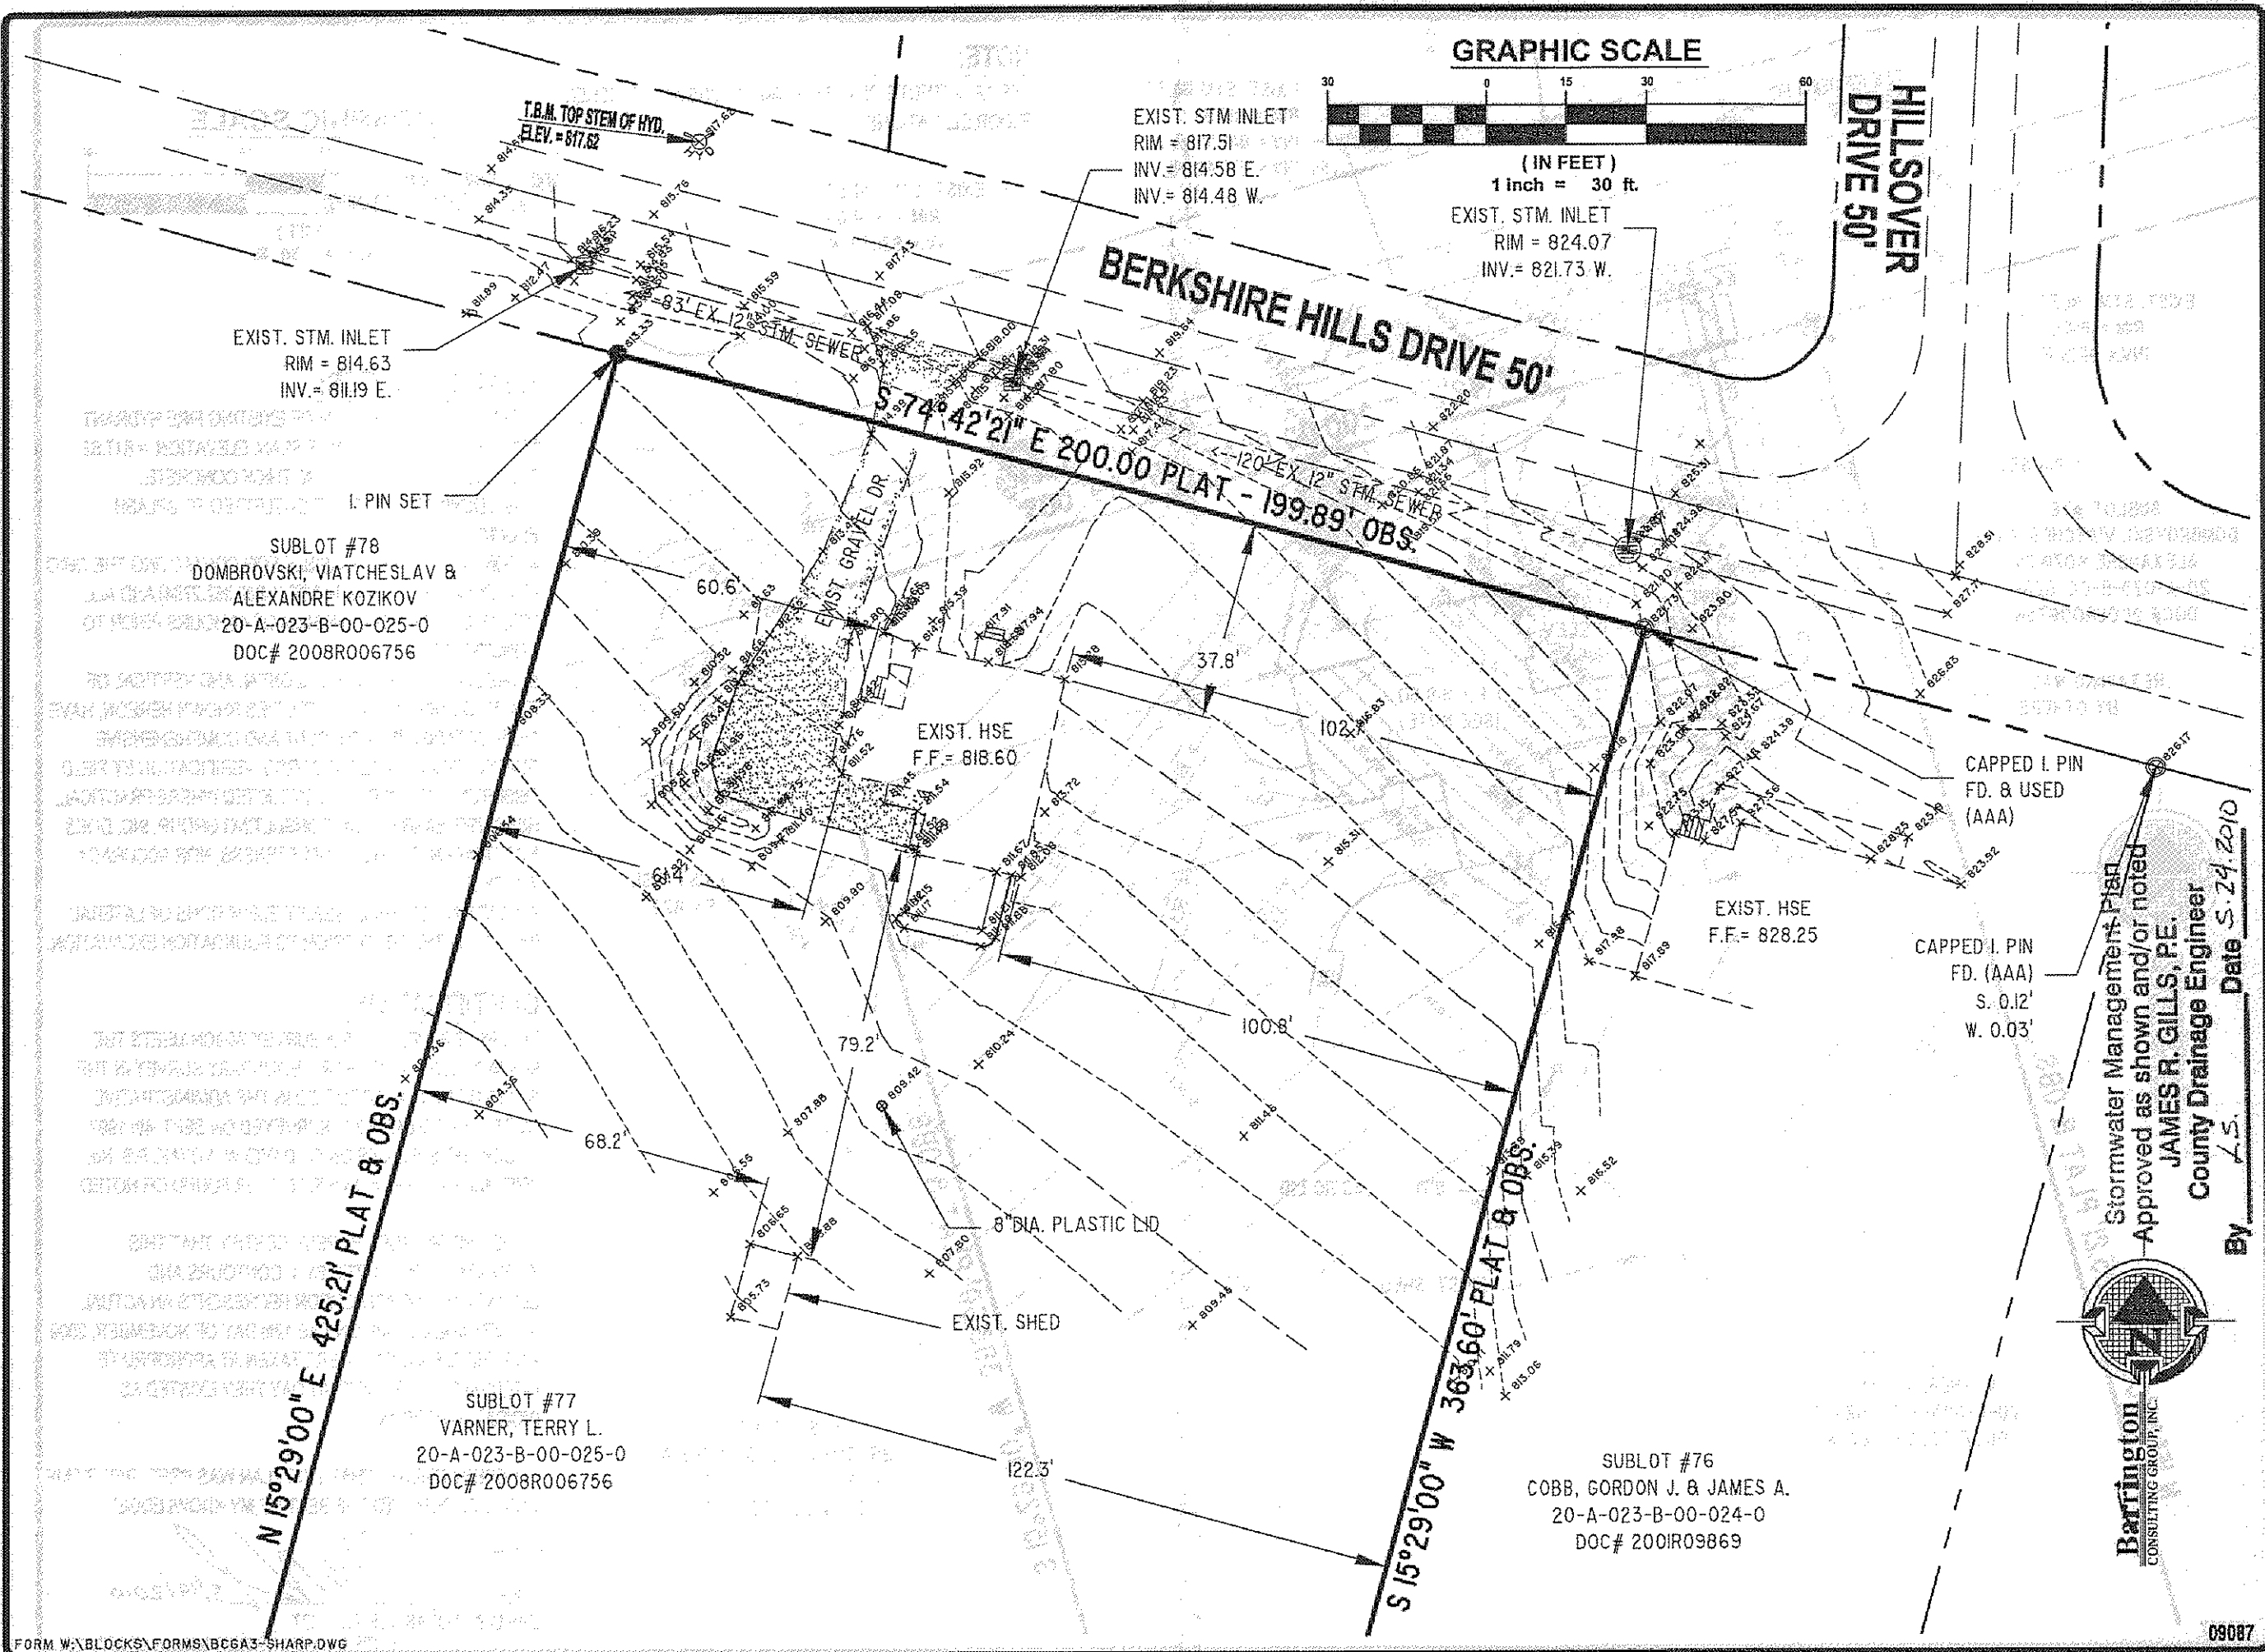


FORM W:\BLOCKS\FORMS\BC6A3-SHARP.DWG

09087

REVISIONS	BY

Barrington
CONSULTING GROUP, INC.
9114 TYLER BLVD., MENTOR, OHIO 44060
PHONE 440.205.1260 FAX 440.205.1262
www.BarringtonCGI.com

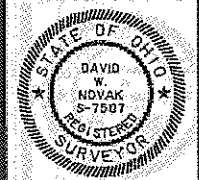

EXISTING CONDITIONS
7112 BERKSHIRE HILLS DRIVE
KIRTLAND, OHIO 44094
JIM COBB

DRAWN	WSO
CHECKED	DWN
DATE	MAY 19, 2010
SCALE	1" = 30'
JOB NO.	09087
SHEET	1/3