
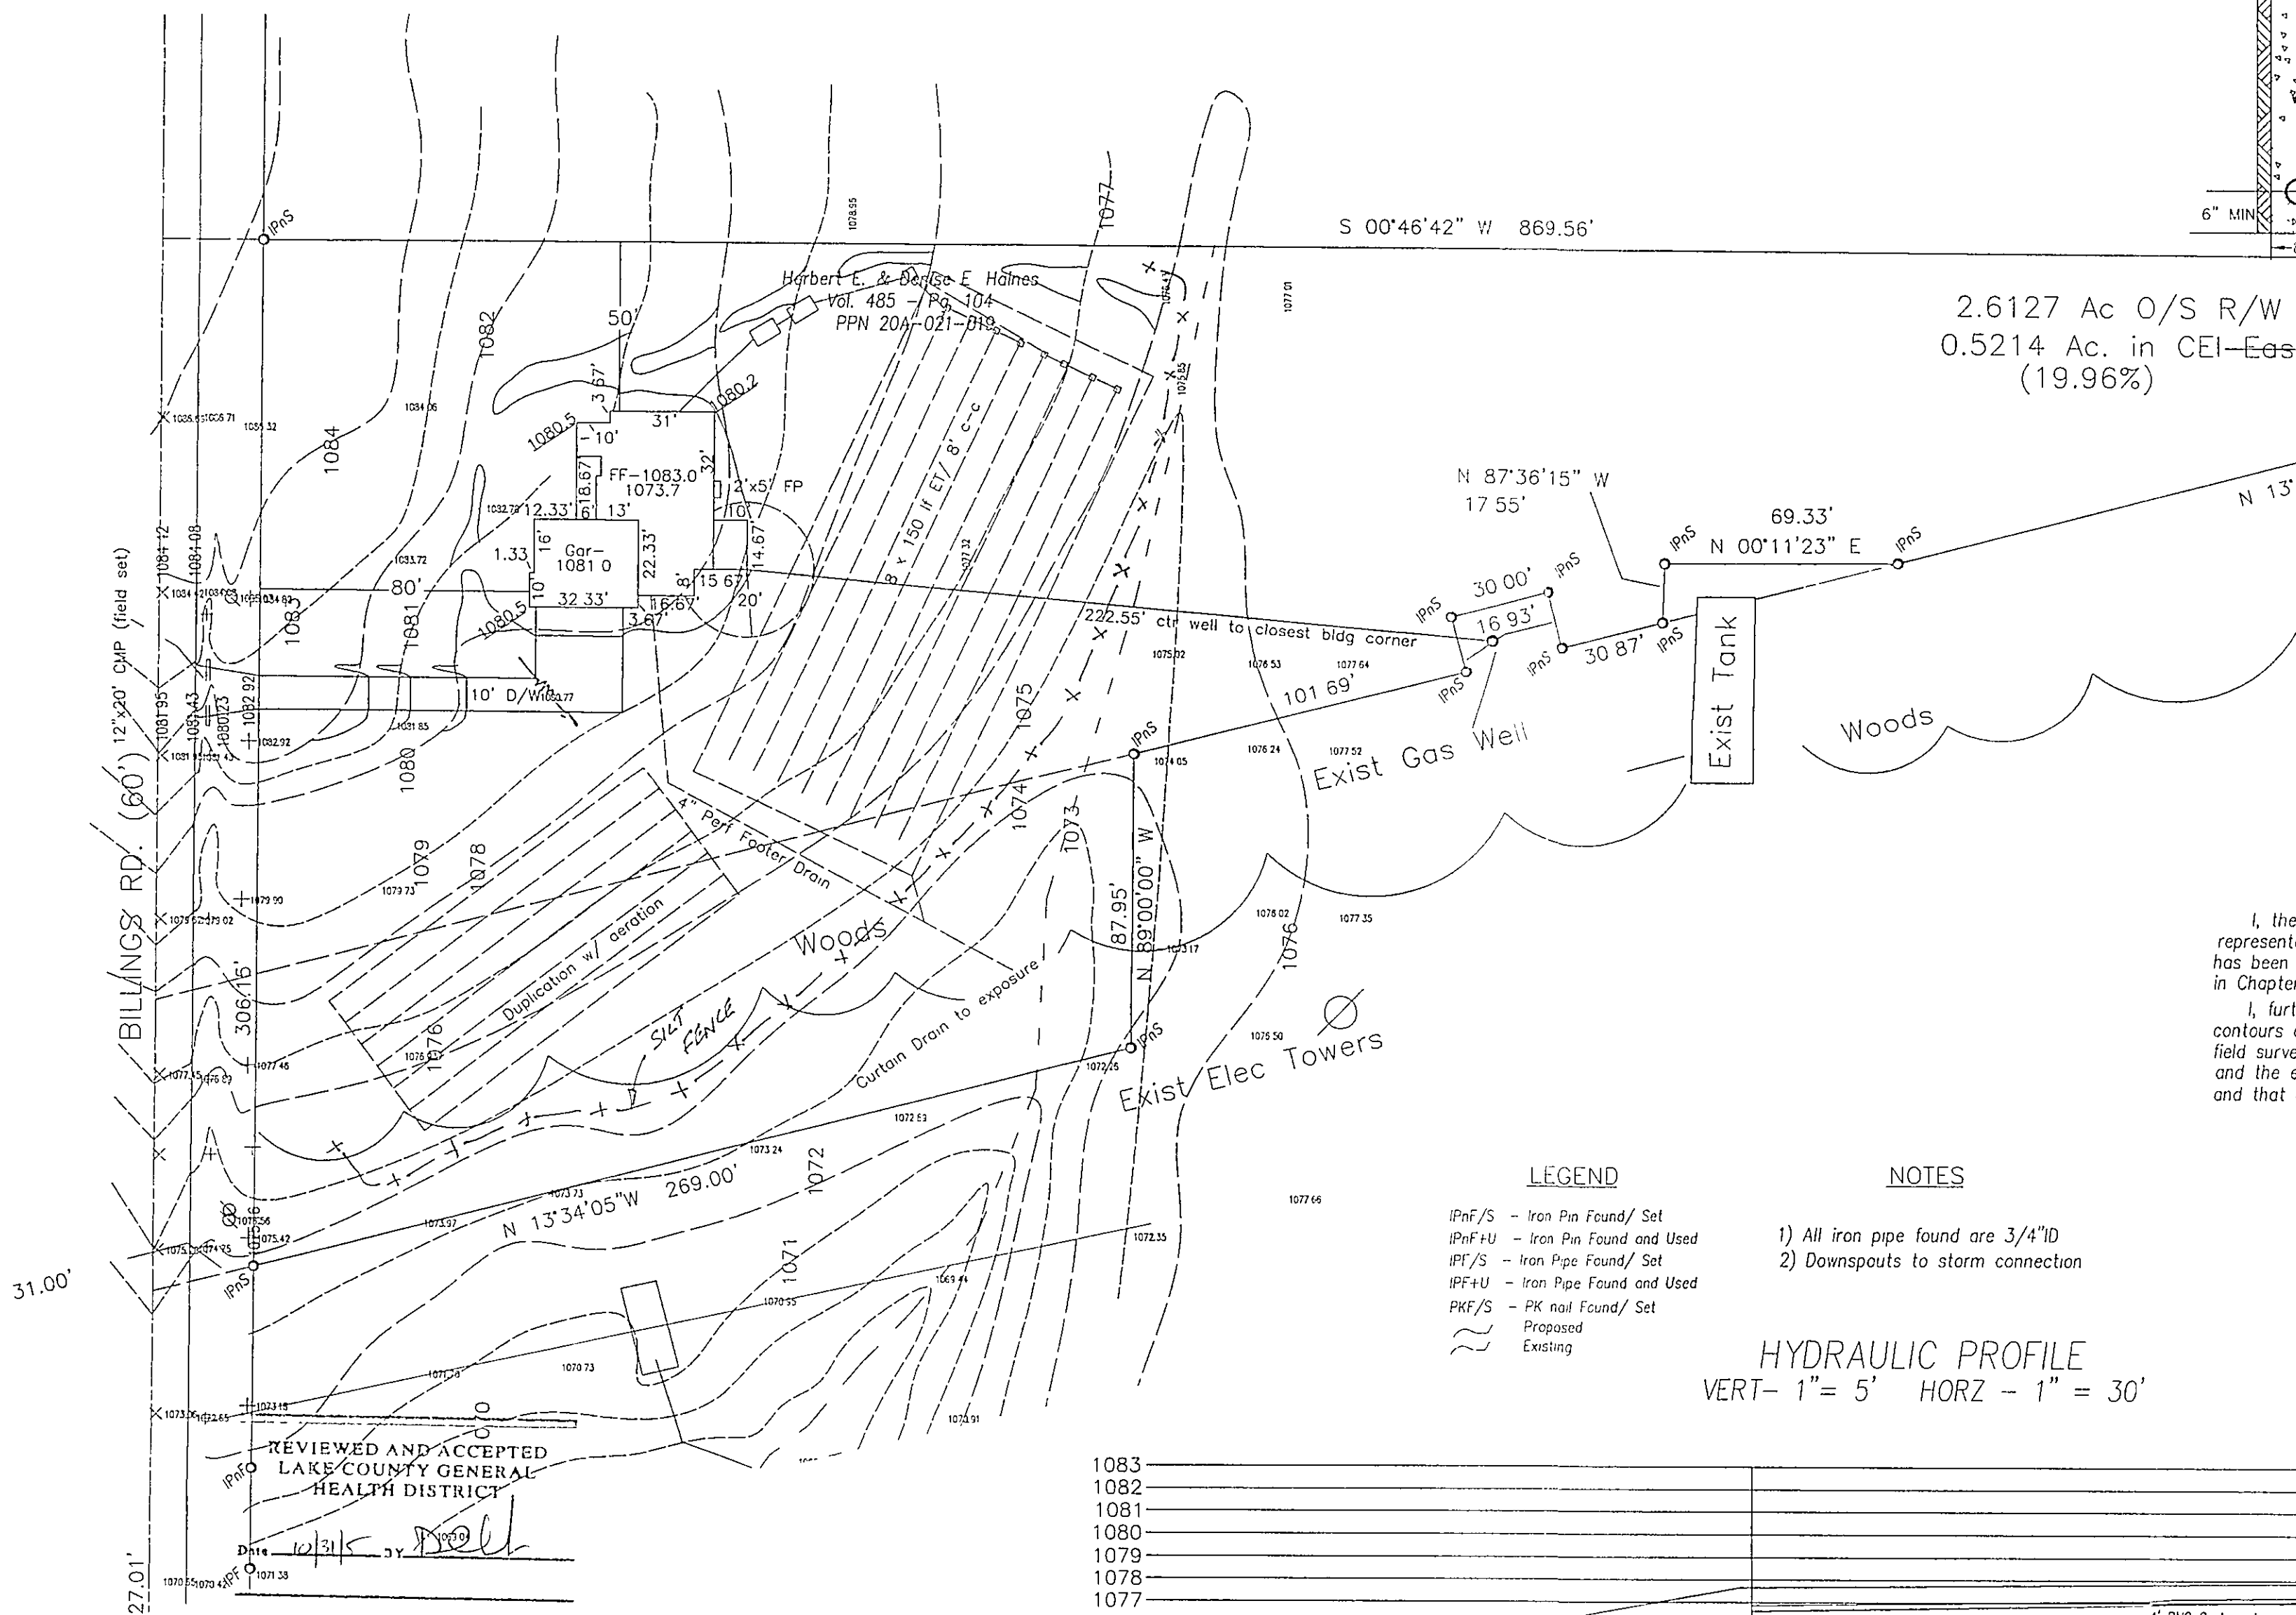



Site Plan FOR Herb Haines

BEING A PART OF LOT No's. 80 & 81, TRACT
No. 3, IN THE CITY OF KIRTLAND, COUNTY OF
LAKE, STATE OF OHIO.

Stormwater Management Plan
Approved as shown and/or noted
JAMES R. GILLS, P.E.
County Drainage Engineer
By L.S. Date 11/10/05

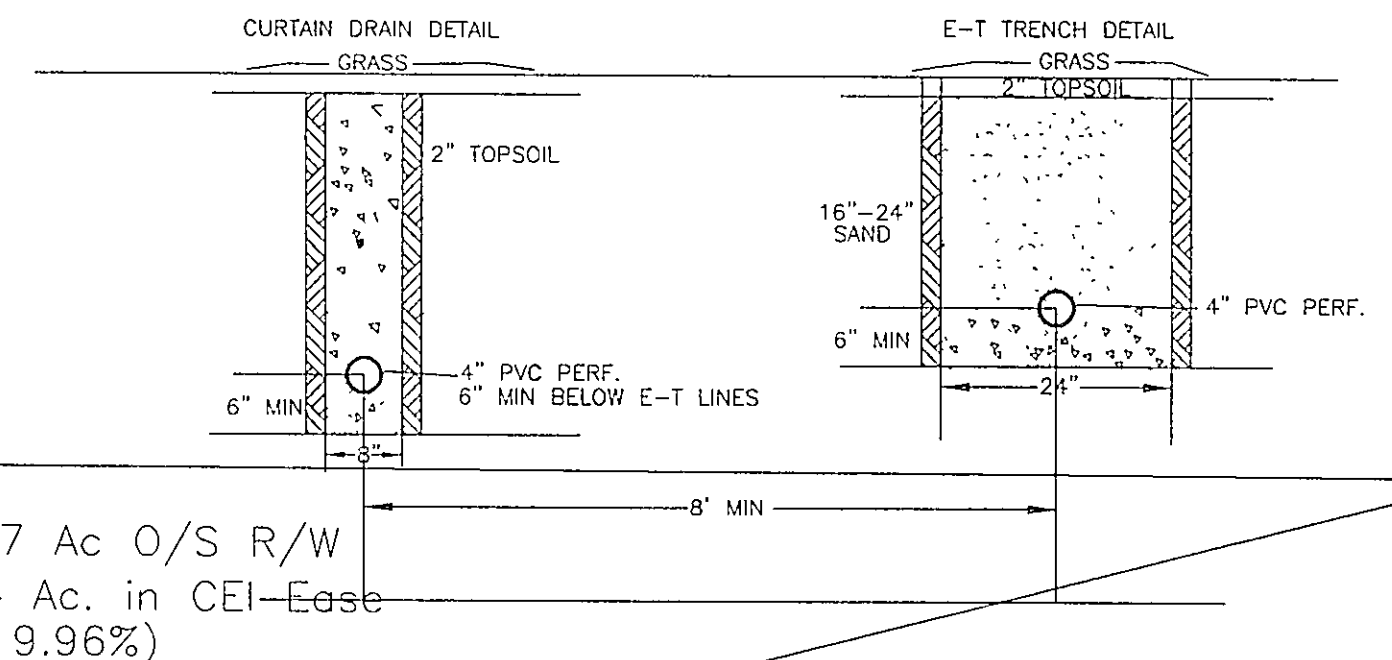

I, the undersigned hereby certify that the boundary survey represented by this plat and that all monumentation set has been done in accordance with the specifications set forth in Chapter 4733-37 of the Ohio Administrative Code.
I, further certify that the topography, indicated by 2 foot contours and elevations shown hereon represent an actual field survey made by me on June 22, 2005 and the elevations were taken at the appropriate intervals and that as of that date they existed as indicated hereon

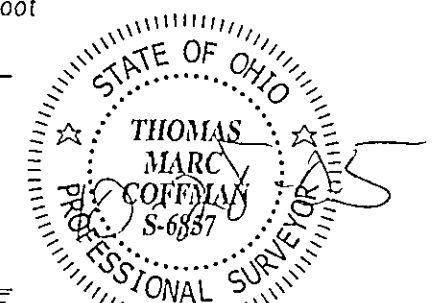

THOMAS M. COFFMAN, P.S., DATE
REGISTERED SURVEYOR No. 6857
STATE OF OHIO

July 20, 2005
REV-92905 (change house layout)
REV-101505 (curt drain outlet & details)
+ ZCC


LEGEND

IPnF/S - Iron Pin Found/ Set
IPnF+U - Iron Pin Found and Used
IPF/S - Iron Pipe Found/ Set
IPF+U - Iron Pipe Found and Used
PKF/S - PK nail Found/ Set
Proposed
Existing

NOTES

- 1) All iron pipe found are 3/4"ID
- 2) Downspouts to storm connection

HYDRAULIC PROFILE
VERT- 1" = 5' HORZ - 1" = 30'

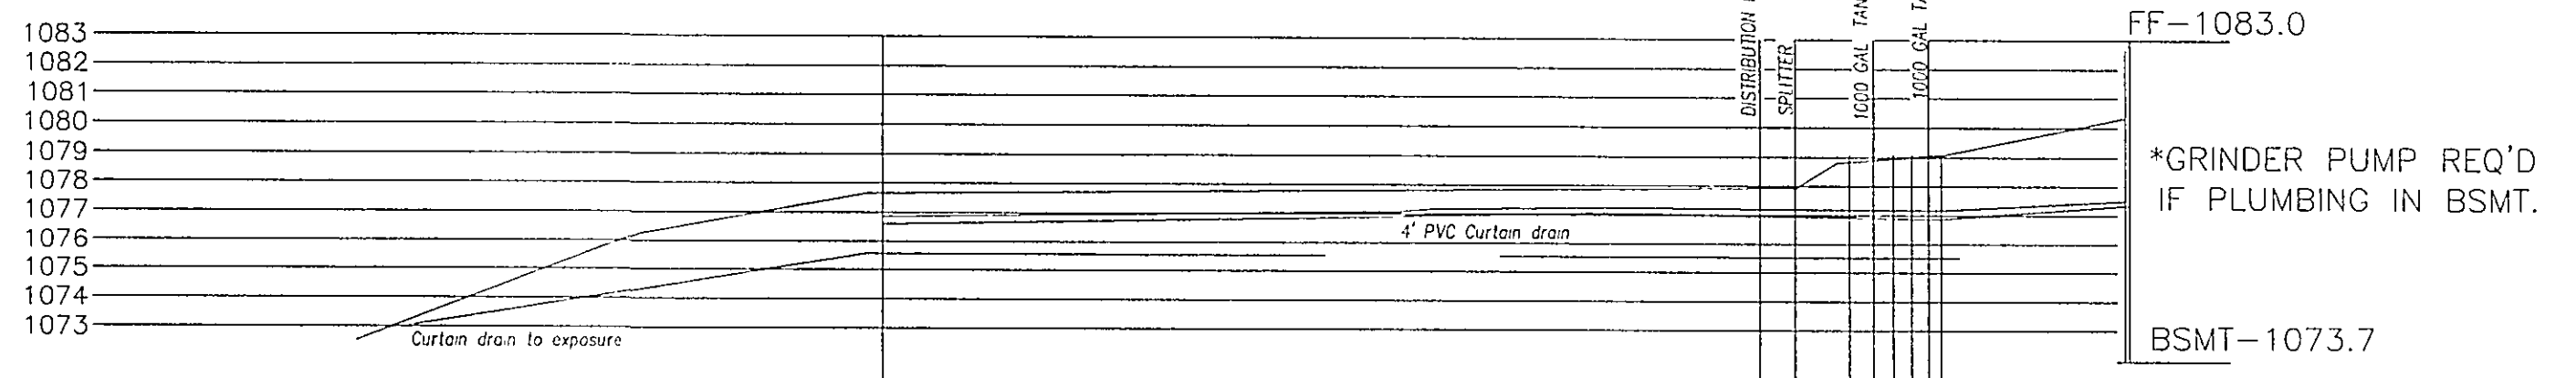

*GRINDER PUMP REQ'D
IF PLUMBING IN BSMT.

BSMT-1073.7