


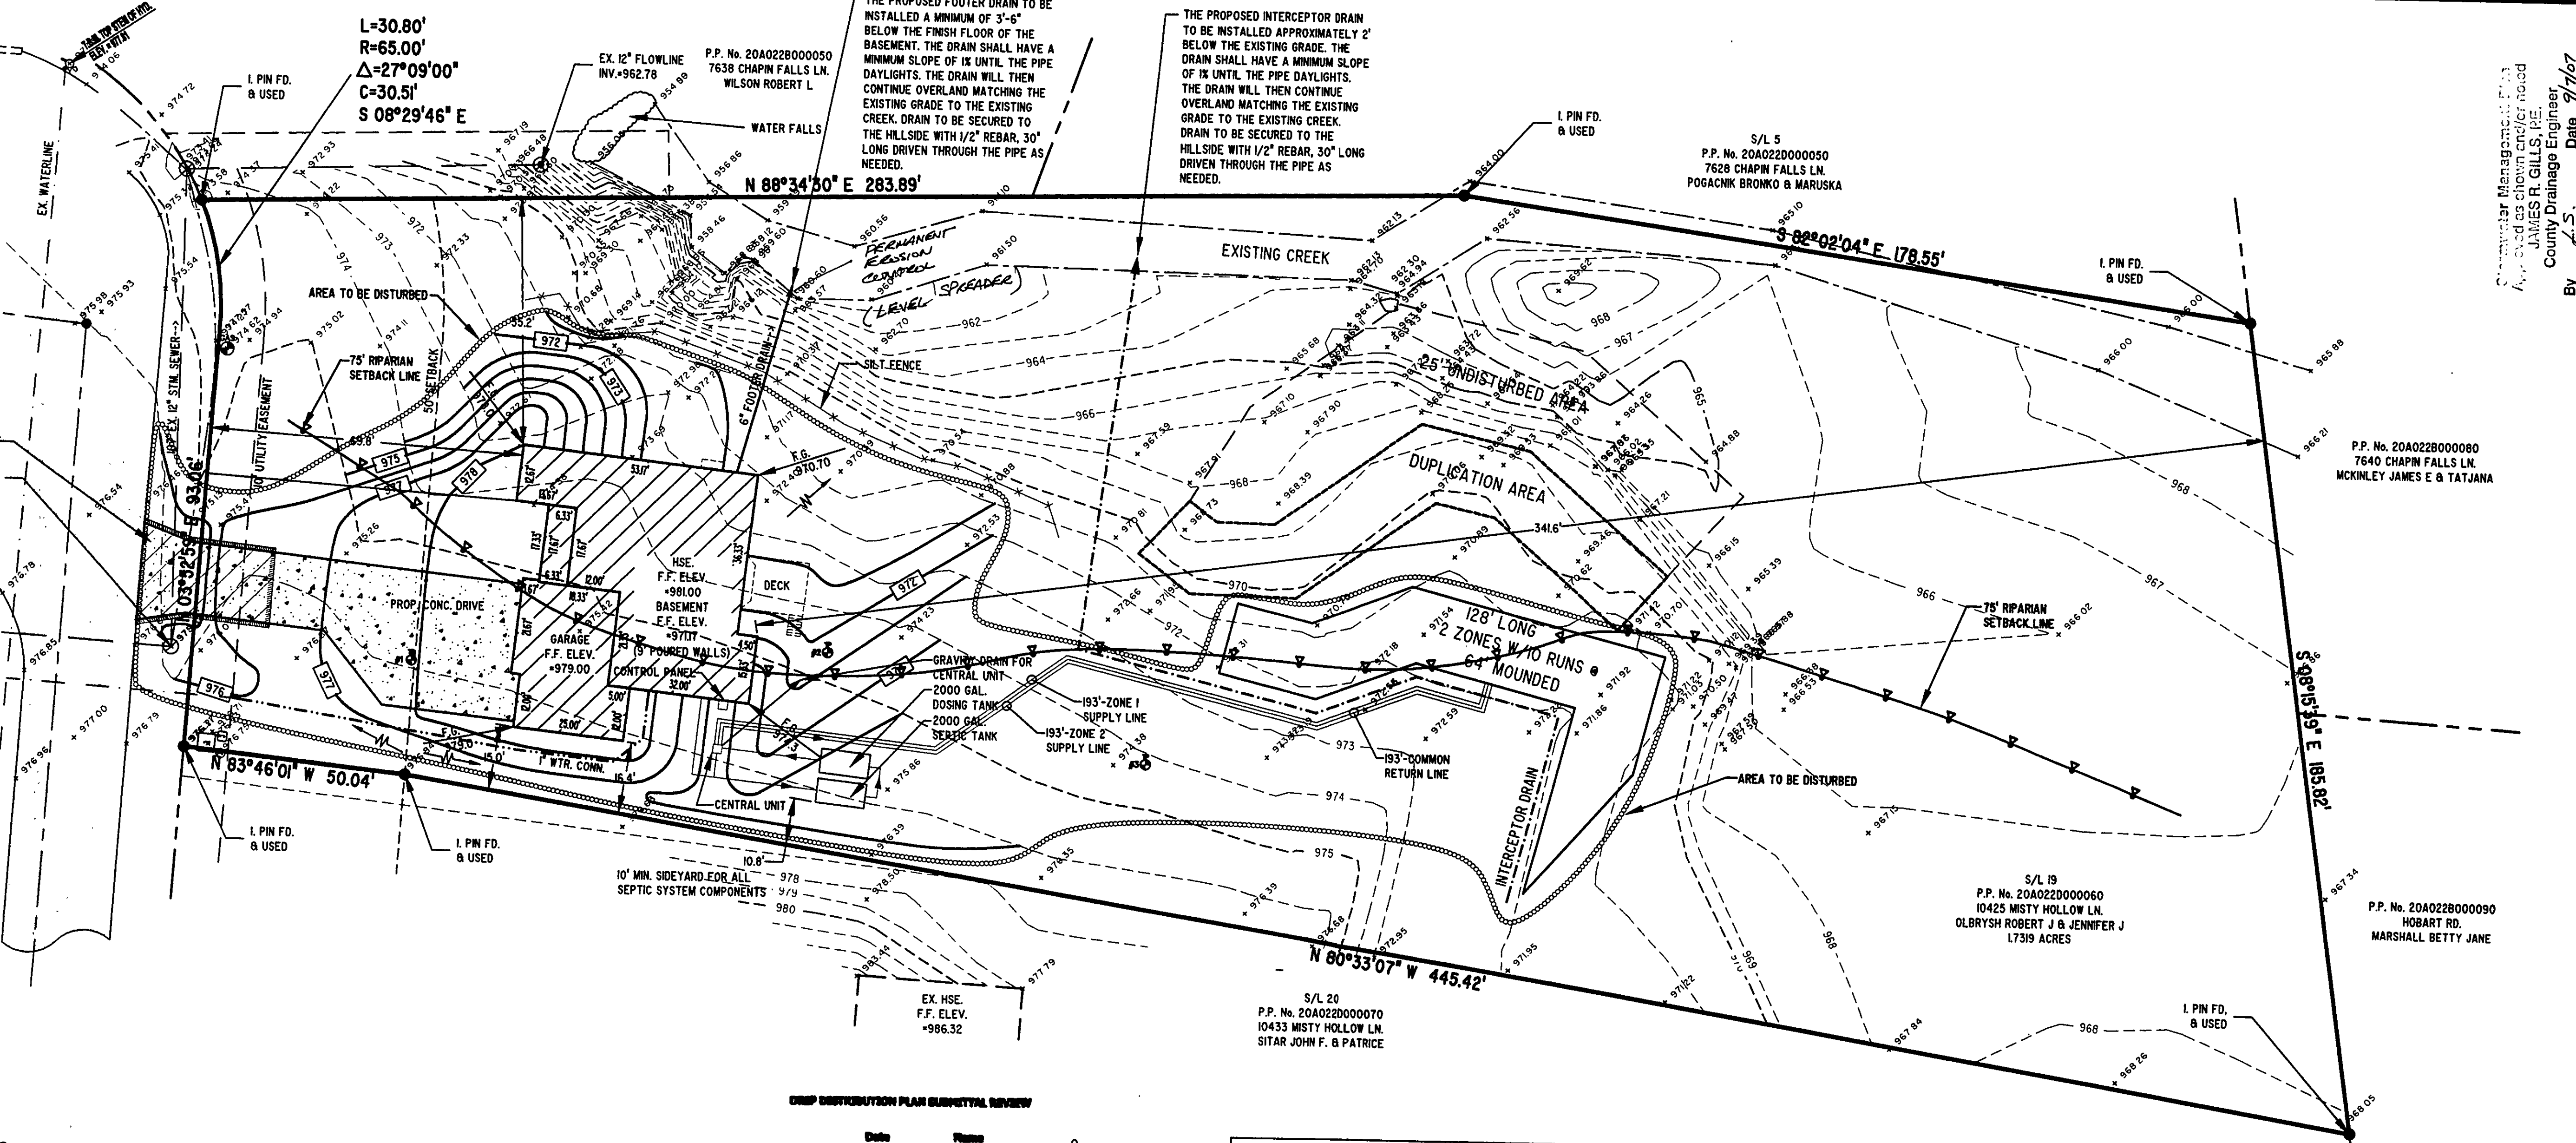

EXISTING FIRE HYDRANT LOCATED IN FRONT SUBLOT 19, BE 6" THICK CONCRETE. BE OUTLETTED TO SPLASH BLOCKS, WHILE FOOTER DRAINS, D INTO STORM SEWER. DECHLORINIZED PRIOR TO DISCHARGE INTO STORM SEWER. NSIBLE FOR CONTACTING THE OHIO UTILITY PROTECTION AND ALL UTILITY COMPANIES A MINIMUM OF 48 HOURS PRIOR. HORIZONTAL AND VERTICAL OF EXISTING UNDERGROUND ON, HAVE BEEN OBTAINED BY A DILIGENT AND COMPREHENSIVE RECORDS. VERIFICATION BY FIELD OBSERVATION HAS BEEN ACTICAL, HOWEVER, BARRINGTON CONSULTING GROUP, INC. THE COMPLETENESS, NOR ACCURACY THEREOF. VERIFY ELEVATIONS OF LATERAL INVERTS IN THE FIELD PRIOR ATION.

REPRESENTS THE MINIMUM STANDARDS FOR BOUNDARY OF OHIO AS ADOPTED MAY 1st, 1980 OF THE OHIO REVISED SURVEYED ON THE 2nd DAY OF OCTOBER, 2002 UNDER THE N. NOVAK, P.S. No. 7507. ALL PIN SET ARE 5/8" DIA., 30" LONG D NOVAK 7507. ALL PROPERTY CORNERS WERE EITHER SET .

REBY CERTIFIES THAT THIS TOPOGRAPHY OF THE HOUSE SITE NTOURS AND ELEVATION SHOWN HEREON REPRESENTS AN Y ME ON THE 14th DAY OF AUGUST, 2007 AND THE ELEVATIONS APPROPRIATE INTERVAL AND AS OF THAT DAY THEY EXISTED AS TIONAL TOPOGRAPHICAL INFORMATION WAS OBTAINED FROM STEM.





THIS PLAN WAS PREPARED BY ME AND IS CORRECT TO THE AND BELIEF"

DRIP DISTRIBUTION PLAN SUBMITTAL REVIEW

Date	Name
9/6/7	David Lark
9/6/7	David Lark
9/6/7	David Lark

Drip distribution area has been field verified and protected with marking tape
Plans submitted to LCONG and meet design criteria
Hydraulic calculations verified and accurate

- EXISTING FIRE HYDRANT
- IRON PIN SET
- MONUMENT ROUND
- GAS MARKER
- STM MANHOLE EXIST
- UTILITY BOXES

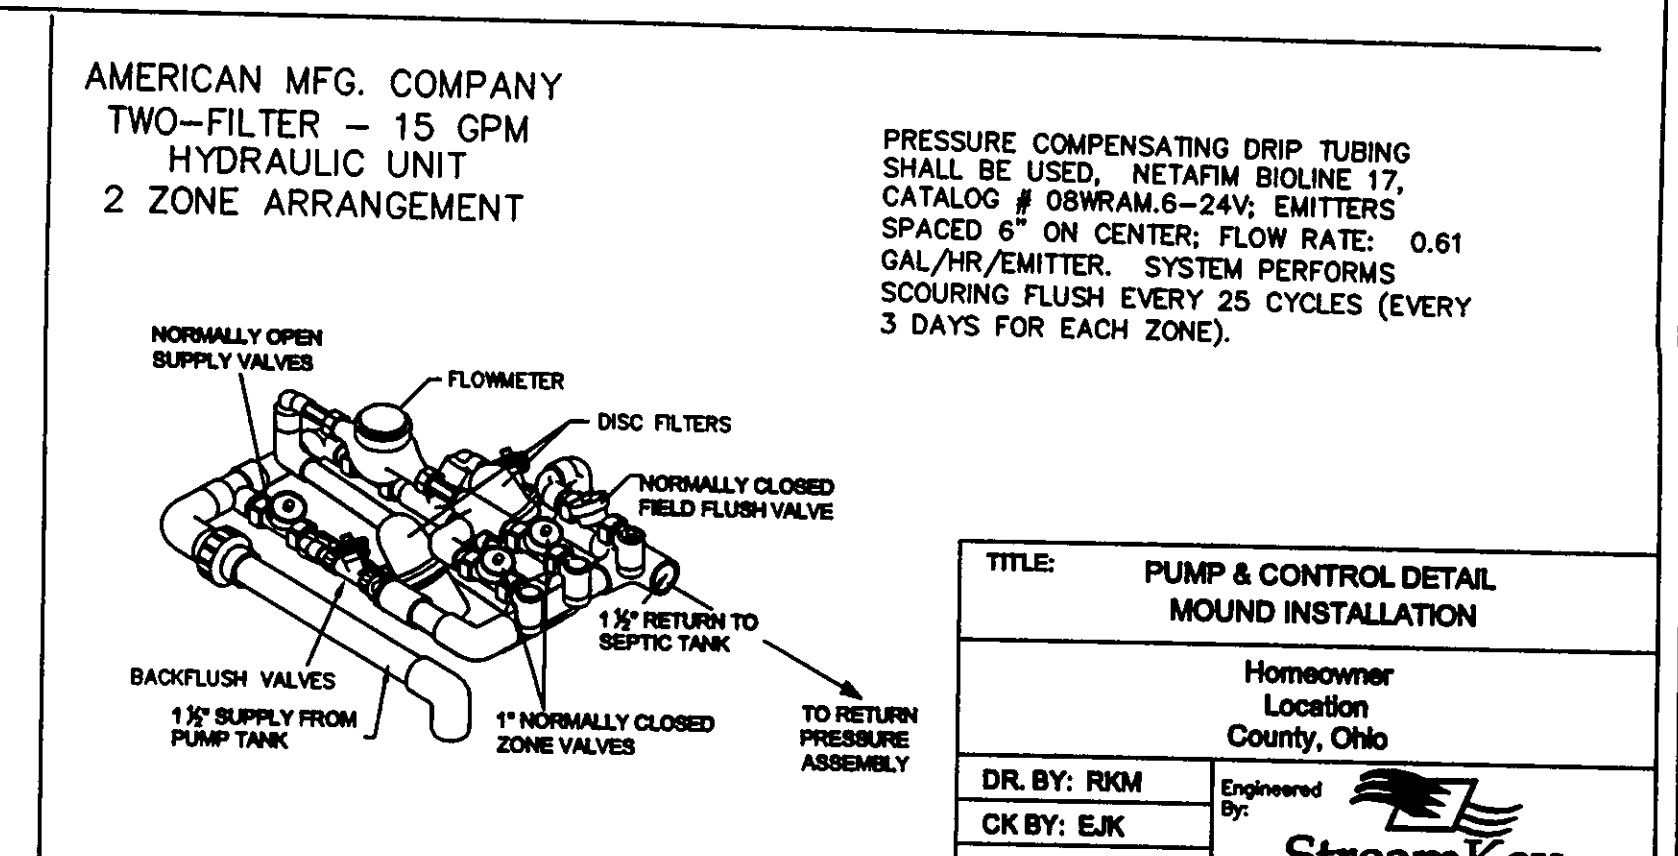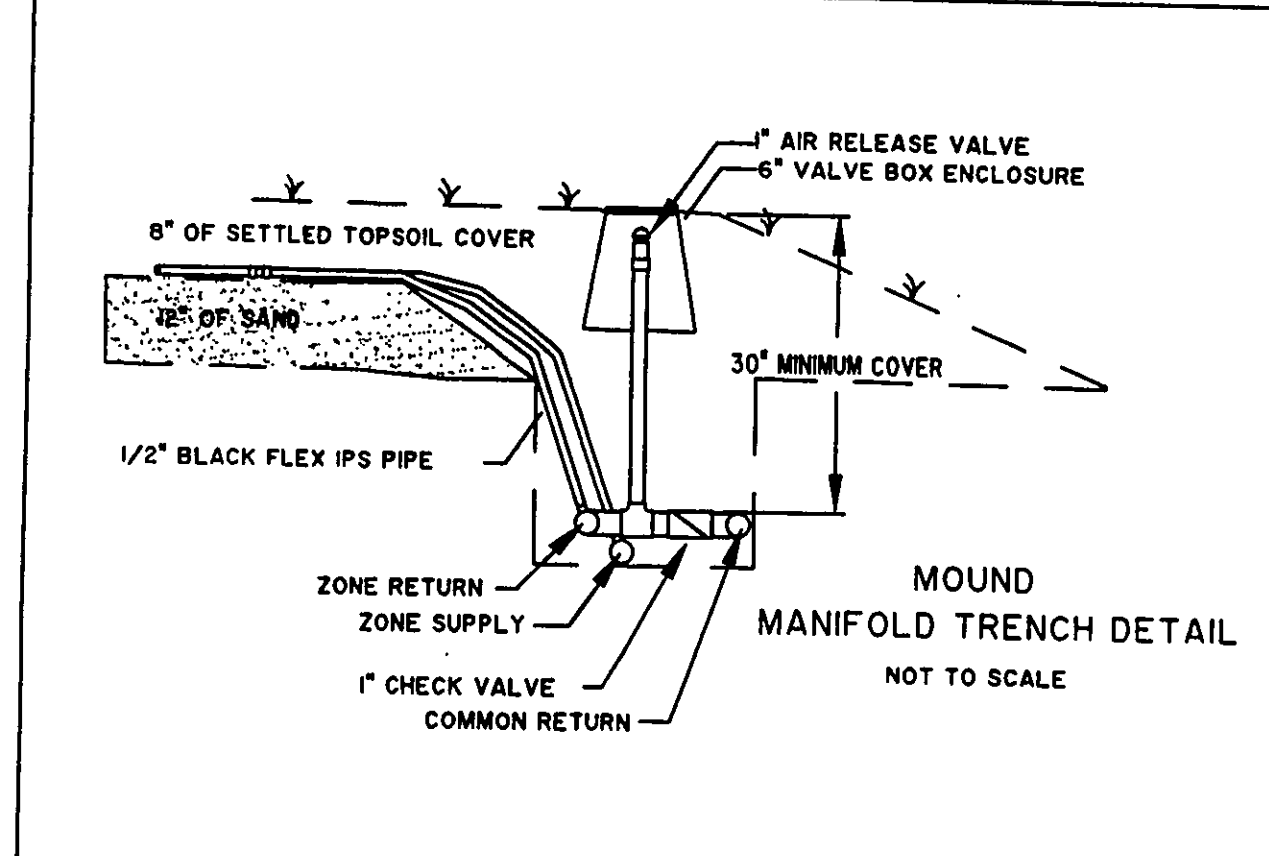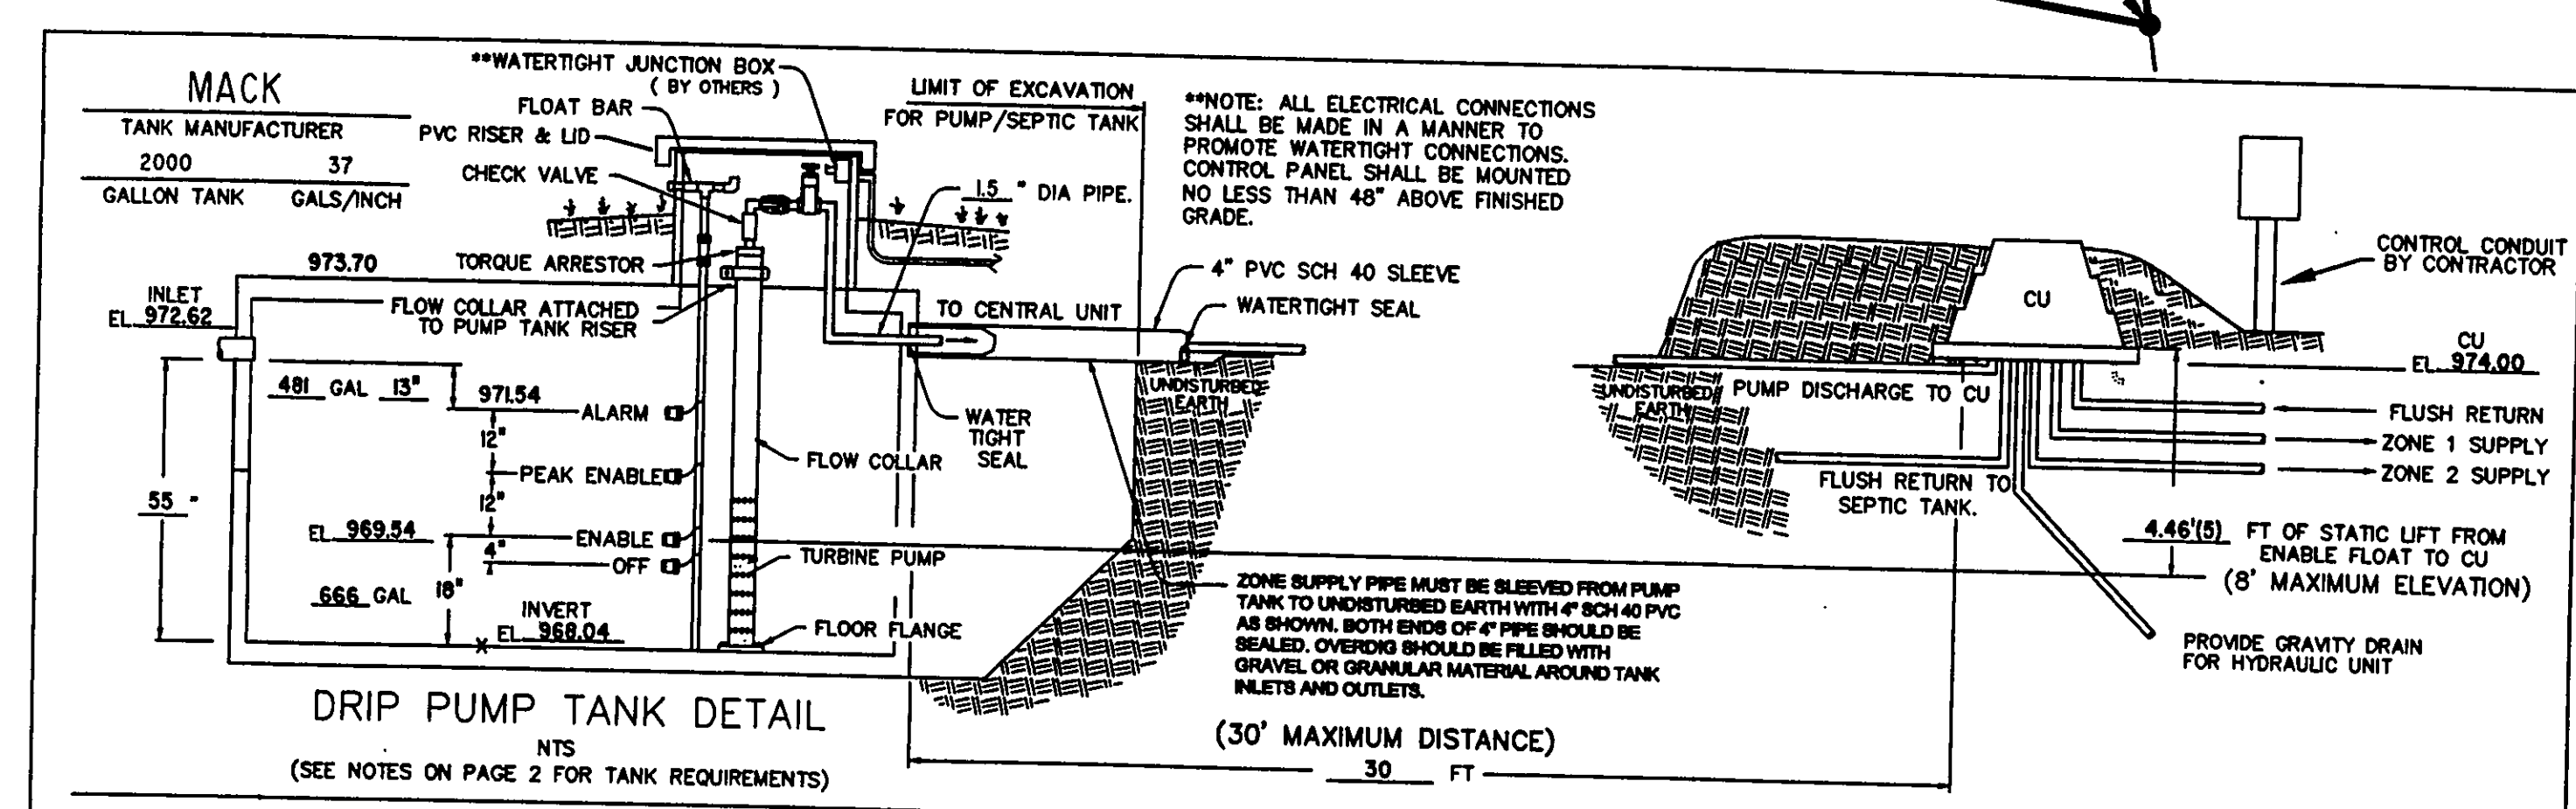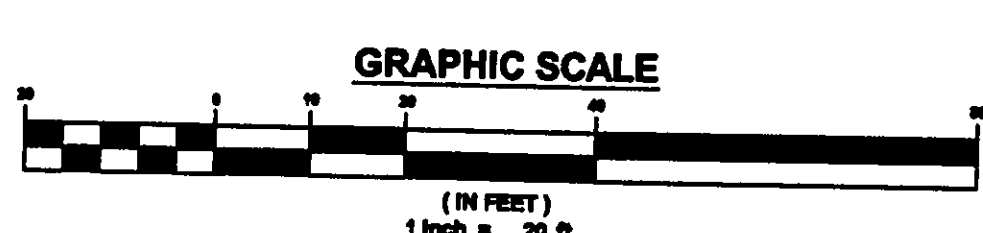

TITLE: PUMP & CONTROL DETAIL MOUND INSTALLATION	
Homeowner Location: County, Ohio	
DR. BY: RKM	Engineered By: StreamKey
CK BY: EJK	Engineered Plumbing & Wastewater Solutions
DATE:	10515 Reading Road Cincinnati, OH 45241 513-792-1221
SCALE: None	
SHEET NO.	FILE: