


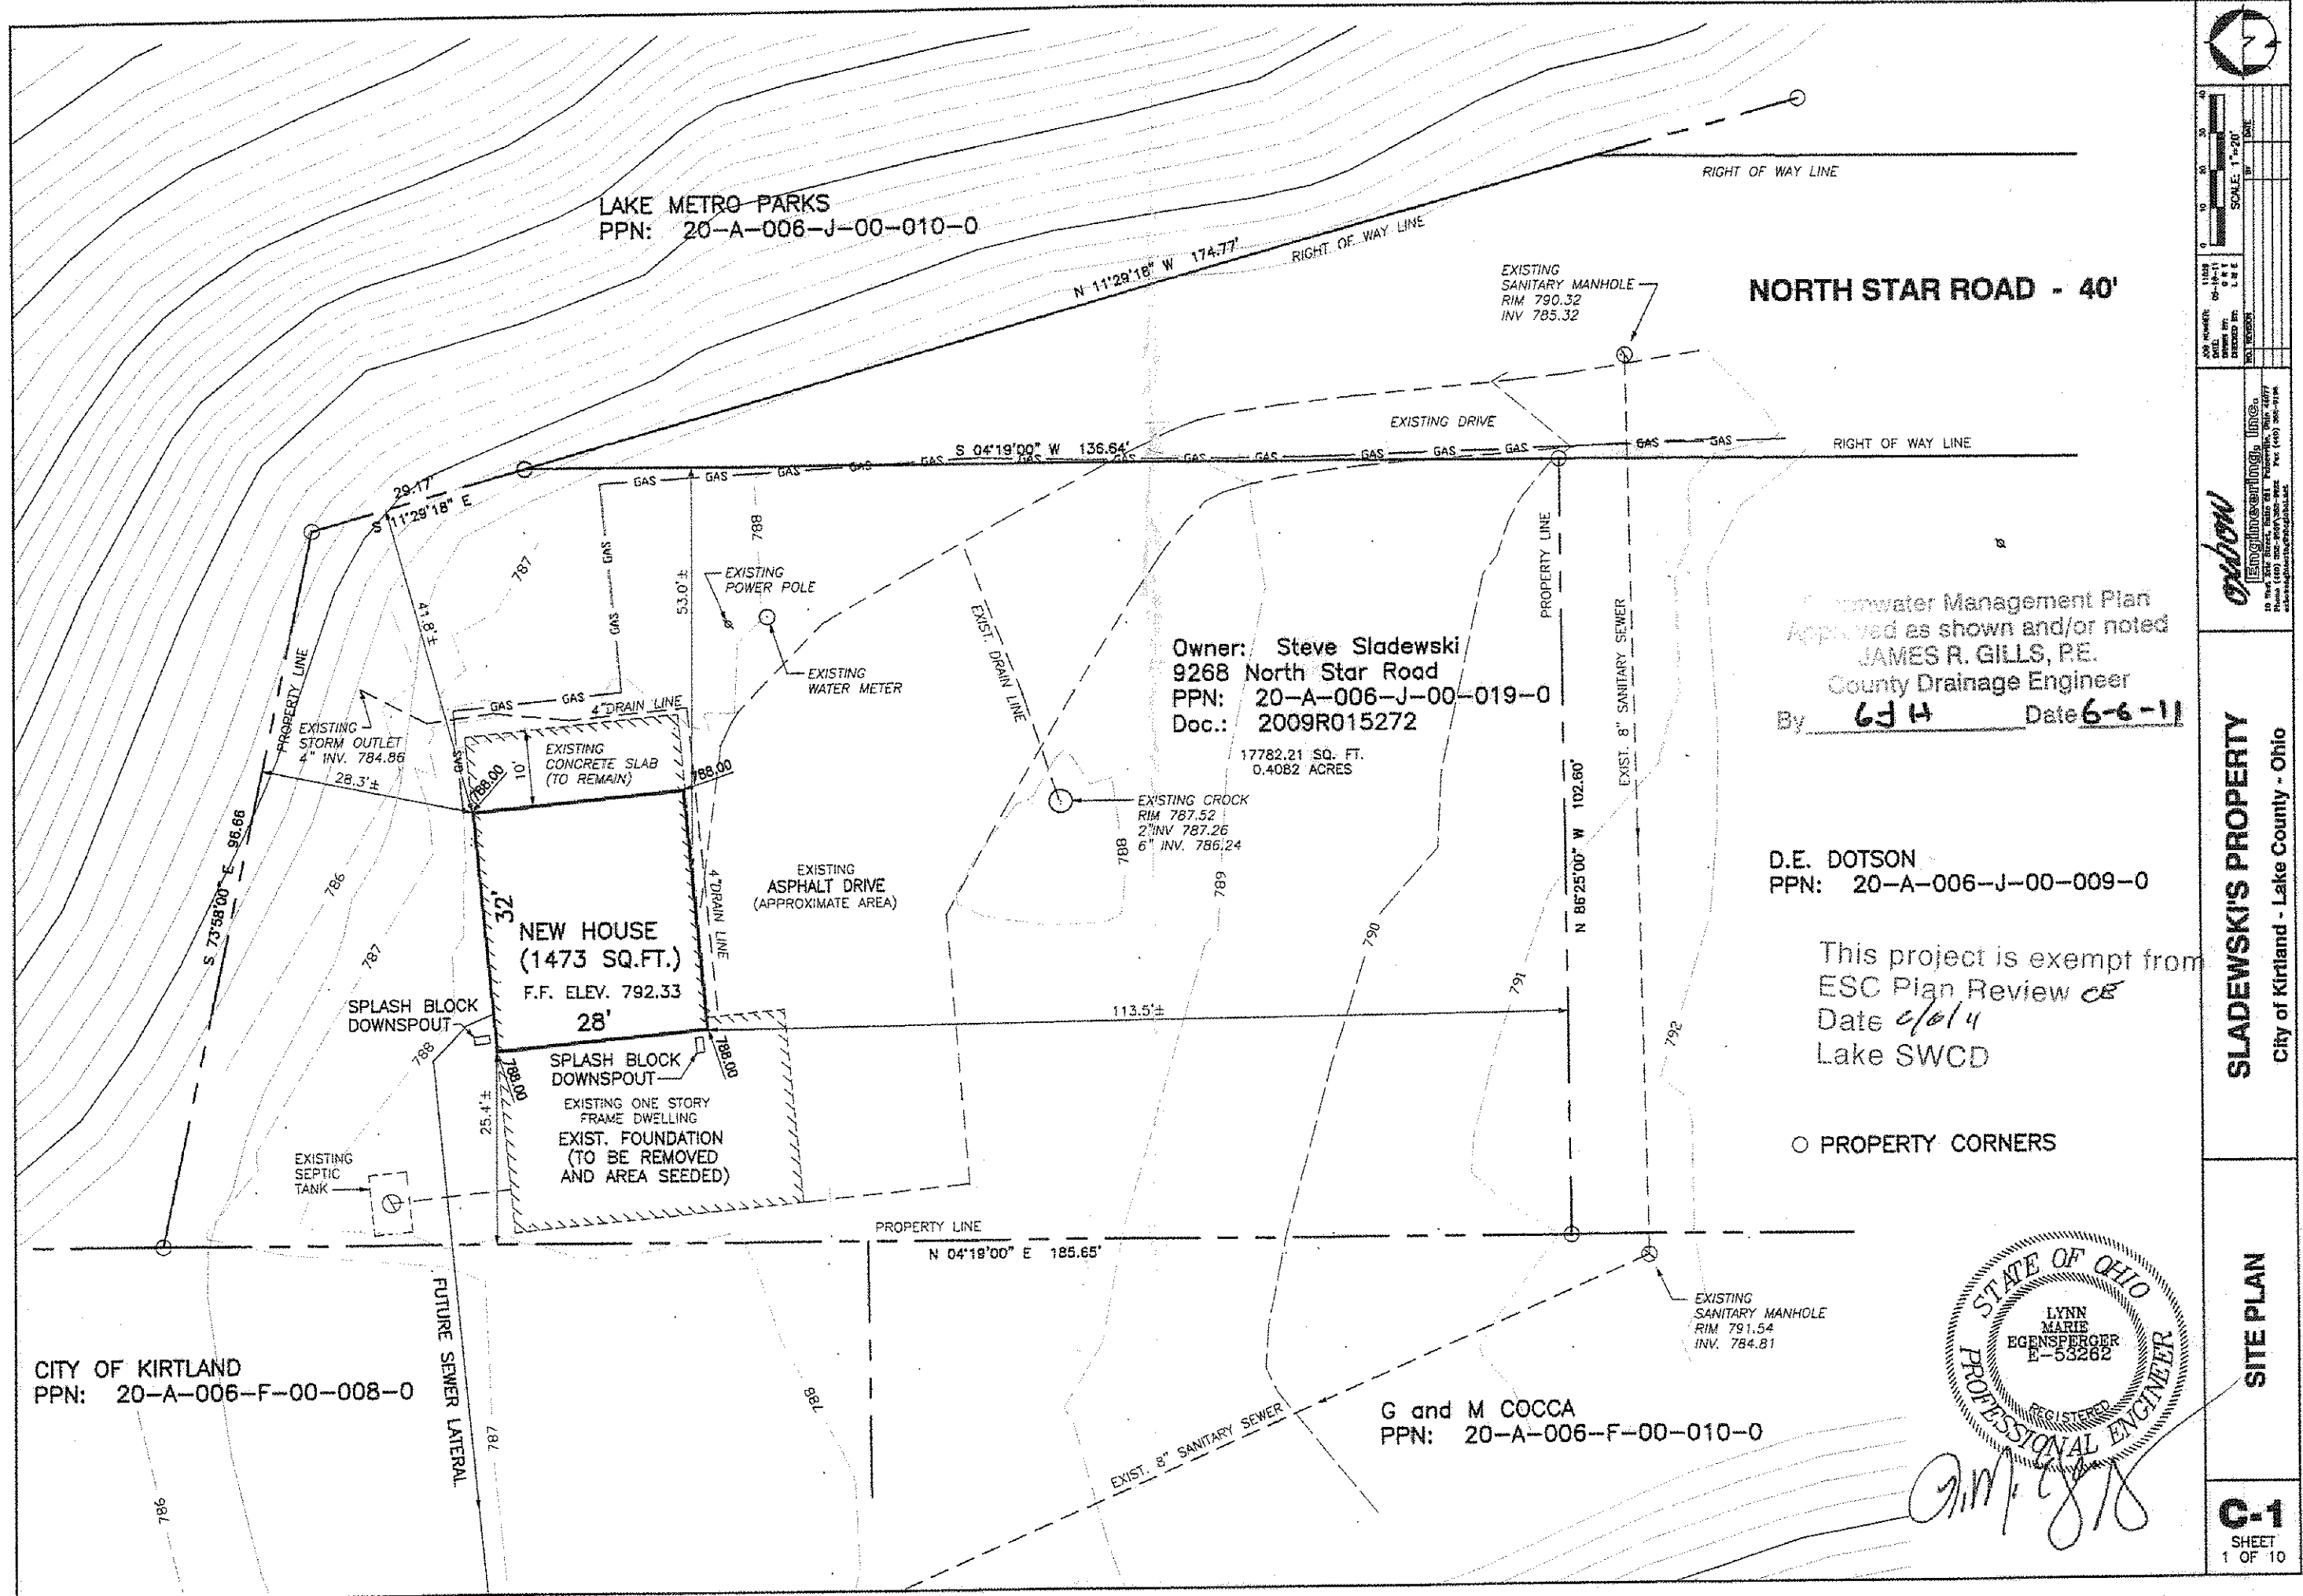

LAKE METRO PARKS
PPN: 20-A-006-J-00-010-0

NORTH STAR ROAD - 40'

Owner: Steve Sladewski
9268 North Star Road
PPN: 20-A-006-J-00-019-0
Doc.: 2009R015272

17782.21 SQ. FT.
0.4082 ACRES

NEW HOUSE
(1473 SQ.FT.)
F.F. ELEV. 792.33
28'

SPLASH BLOCK
DOWNSPOUT
EXISTING ONE STORY
FRAME DWELLING
EXIST. FOUNDATION
(TO BE REMOVED
AND AREA SEED)

Sanitary Management Plan
Approved as shown and/or noted
JAMES R. GILLS, P.E.
County Drainage Engineer
By 6JH Date 6-6-11


D.E. DOTSON
PPN: 20-A-006-J-00-009-0

This project is exempt from
ESC Plan Review CE
Date 6/6/11
Lake SWCD

○ PROPERTY CORNERS

CITY OF KIRTLAND
PPN: 20-A-006-F-00-008-0

G and M COCCA
PPN: 20-A-006-F-00-010-0

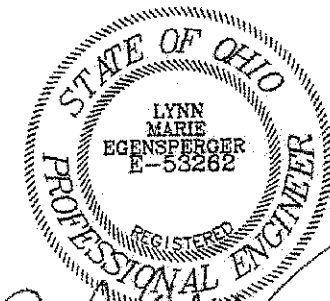

SCALE: 1"=20'

DATE: 6-6-11

BY: 6JH

FOR: JAMES R. GILLS, P.E.

FOR: JAMES R. GILLS, P.E.

SLADEWSKI'S PROPERTY

City of Kirtland - Lake County - Ohio

SITE PLAN

C-1

SHEET
1 OF 10