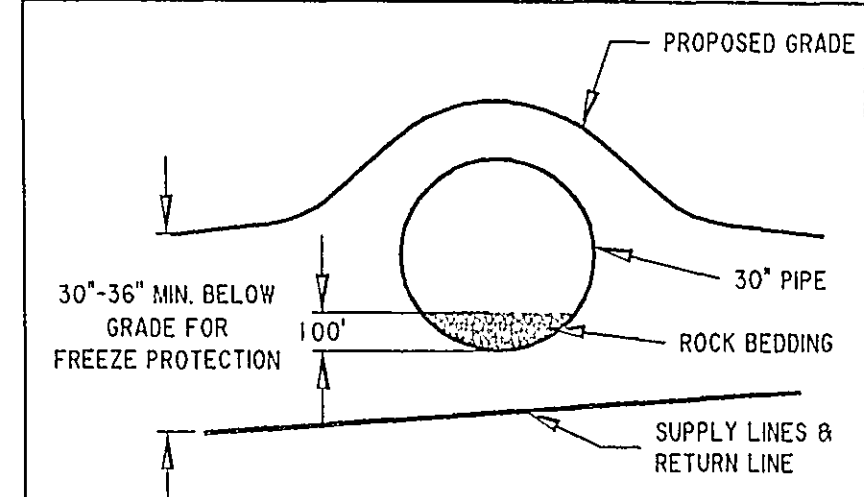
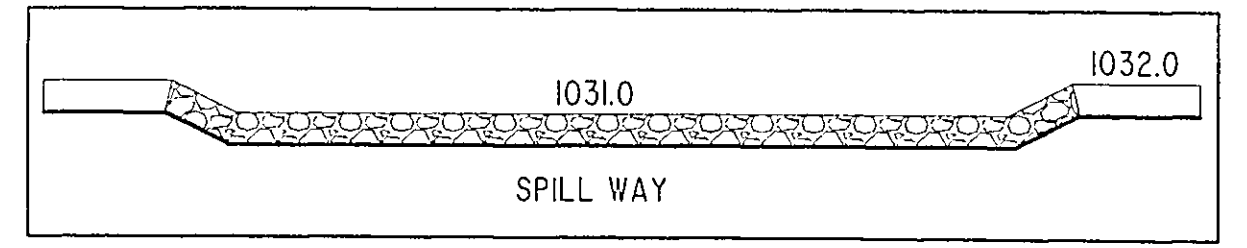
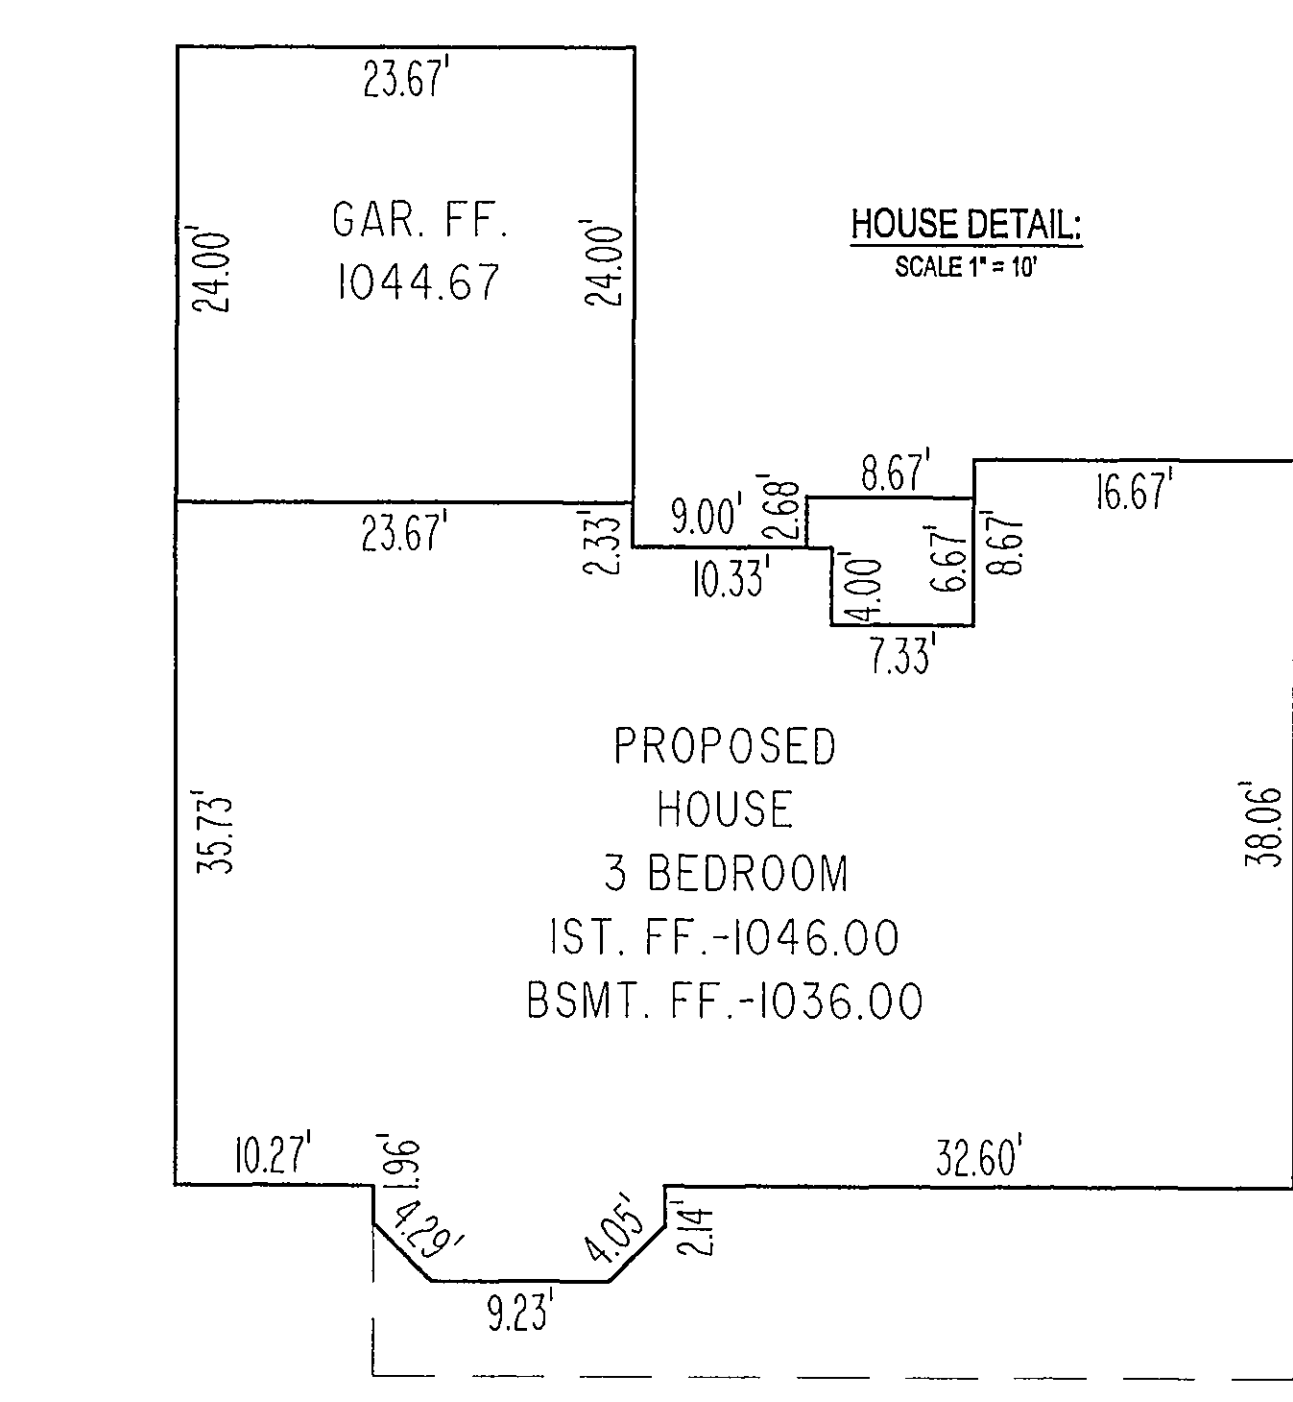
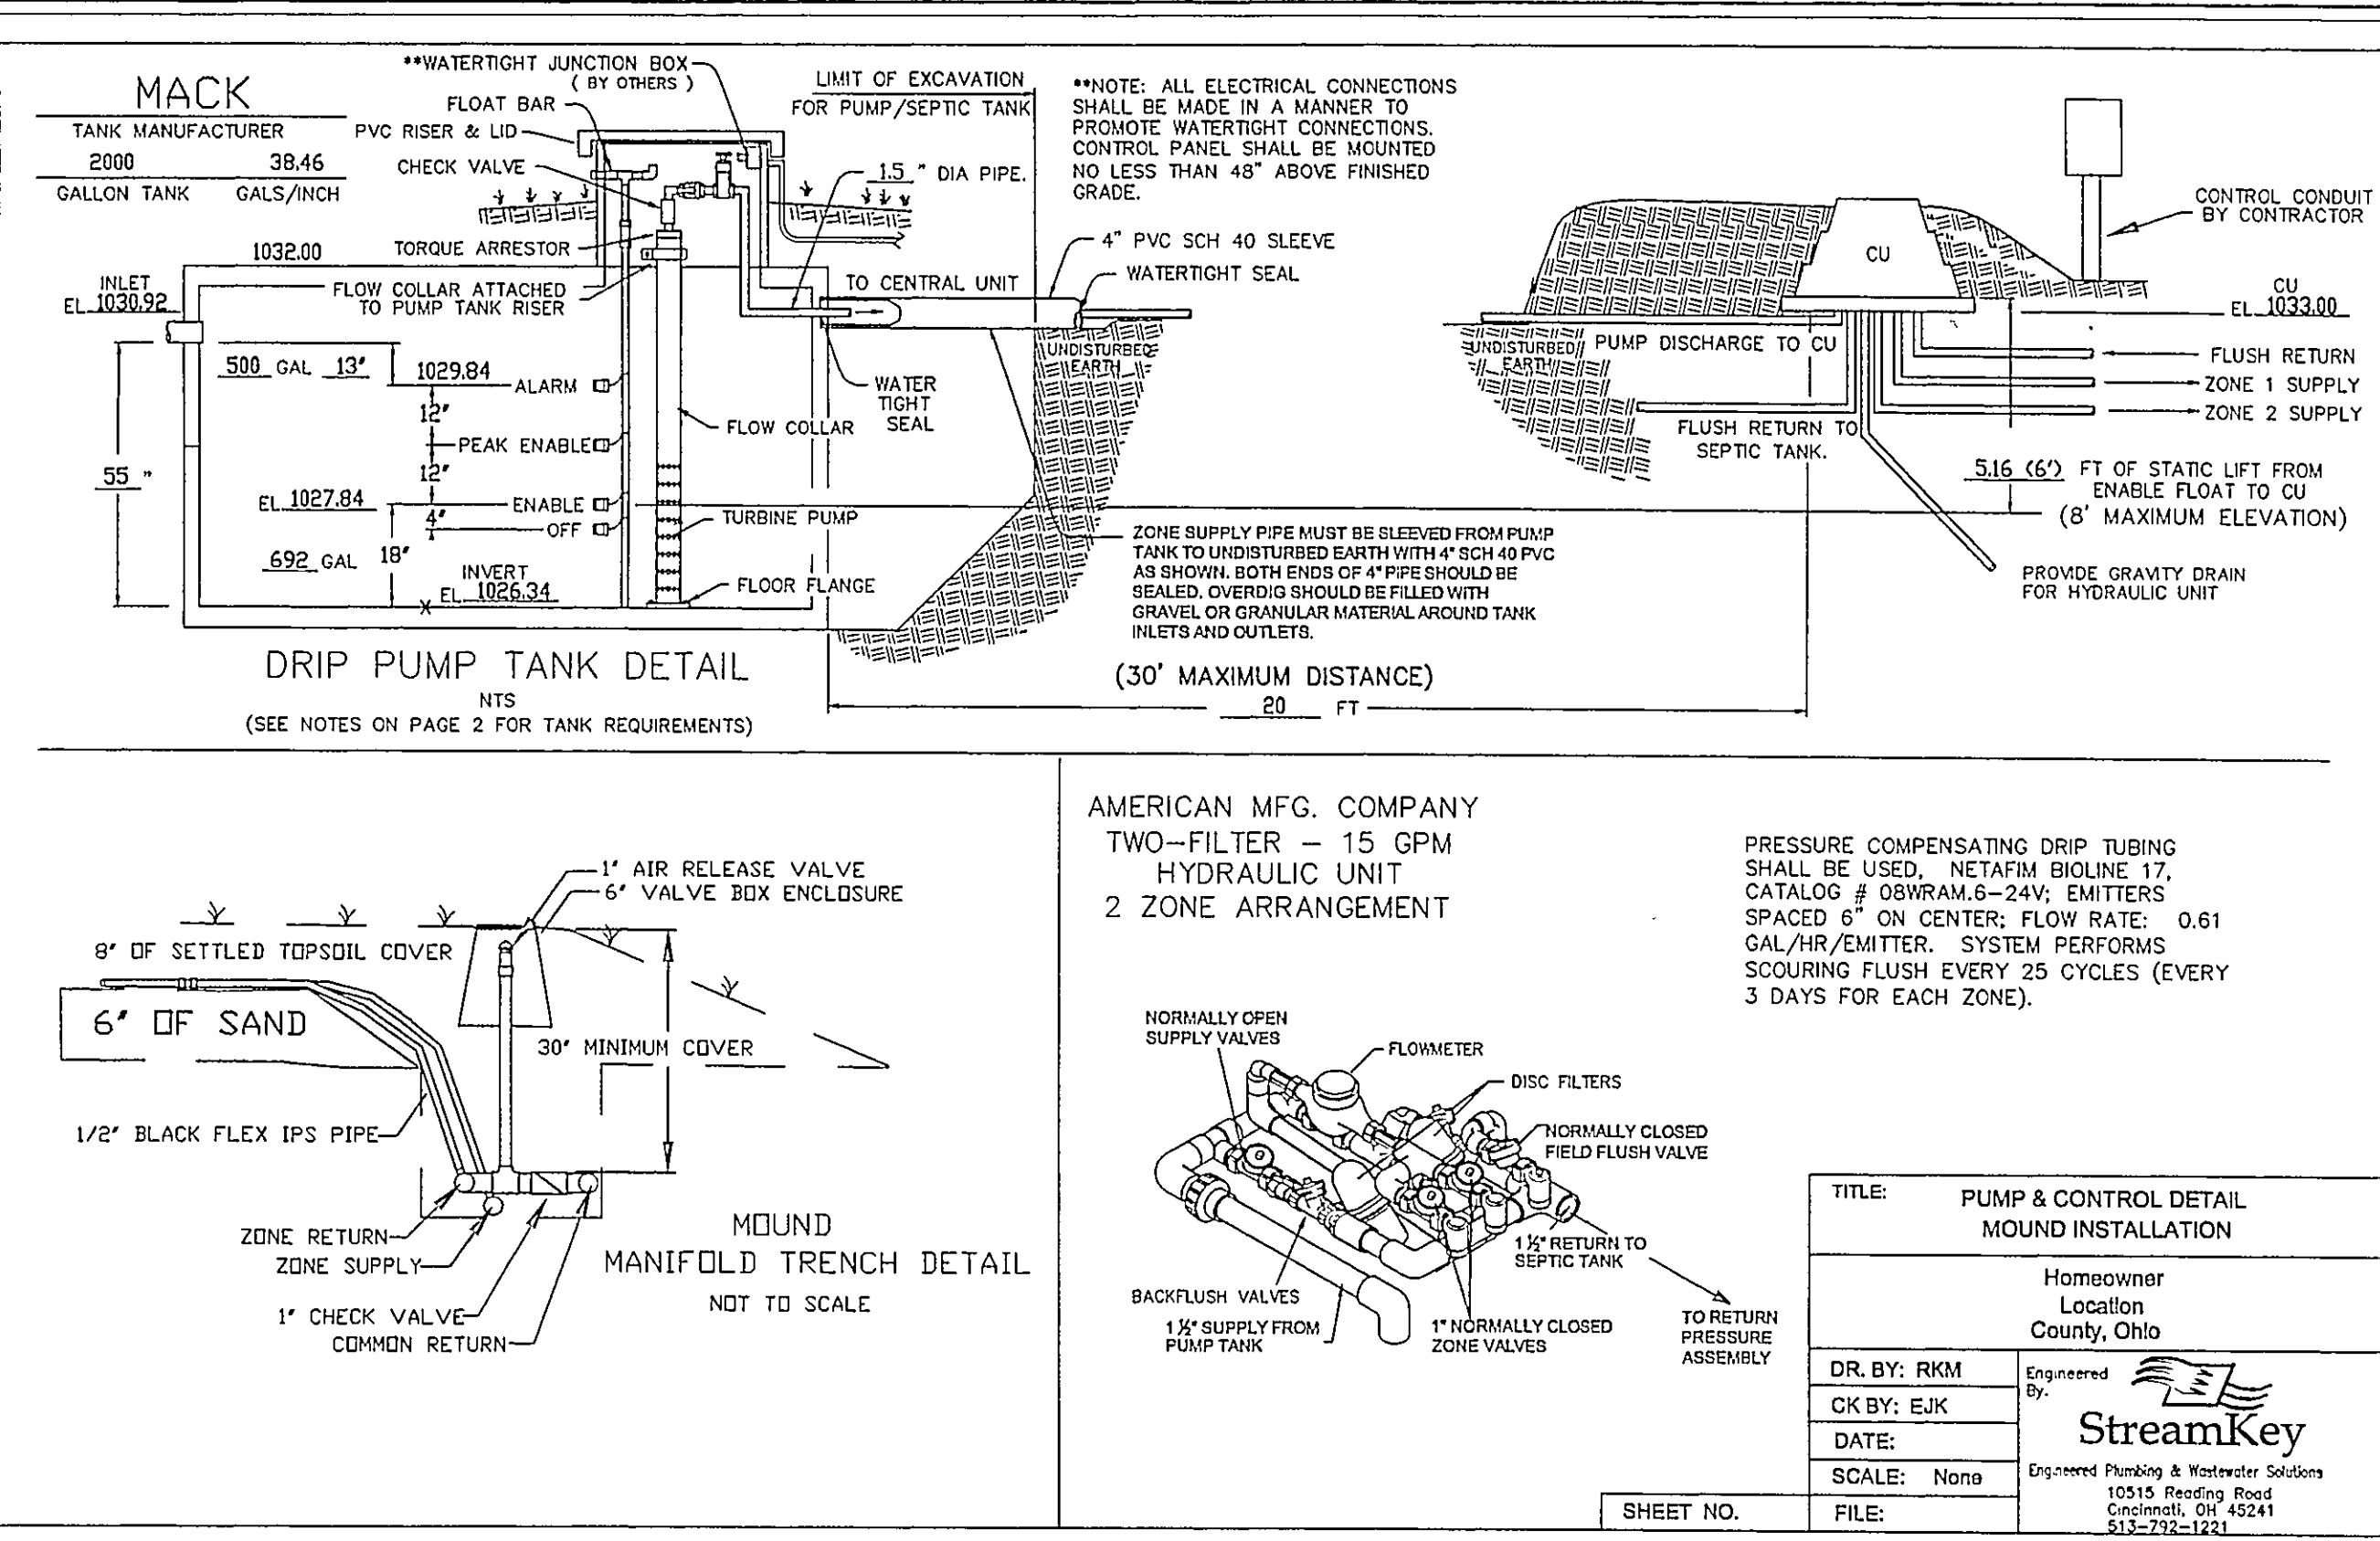
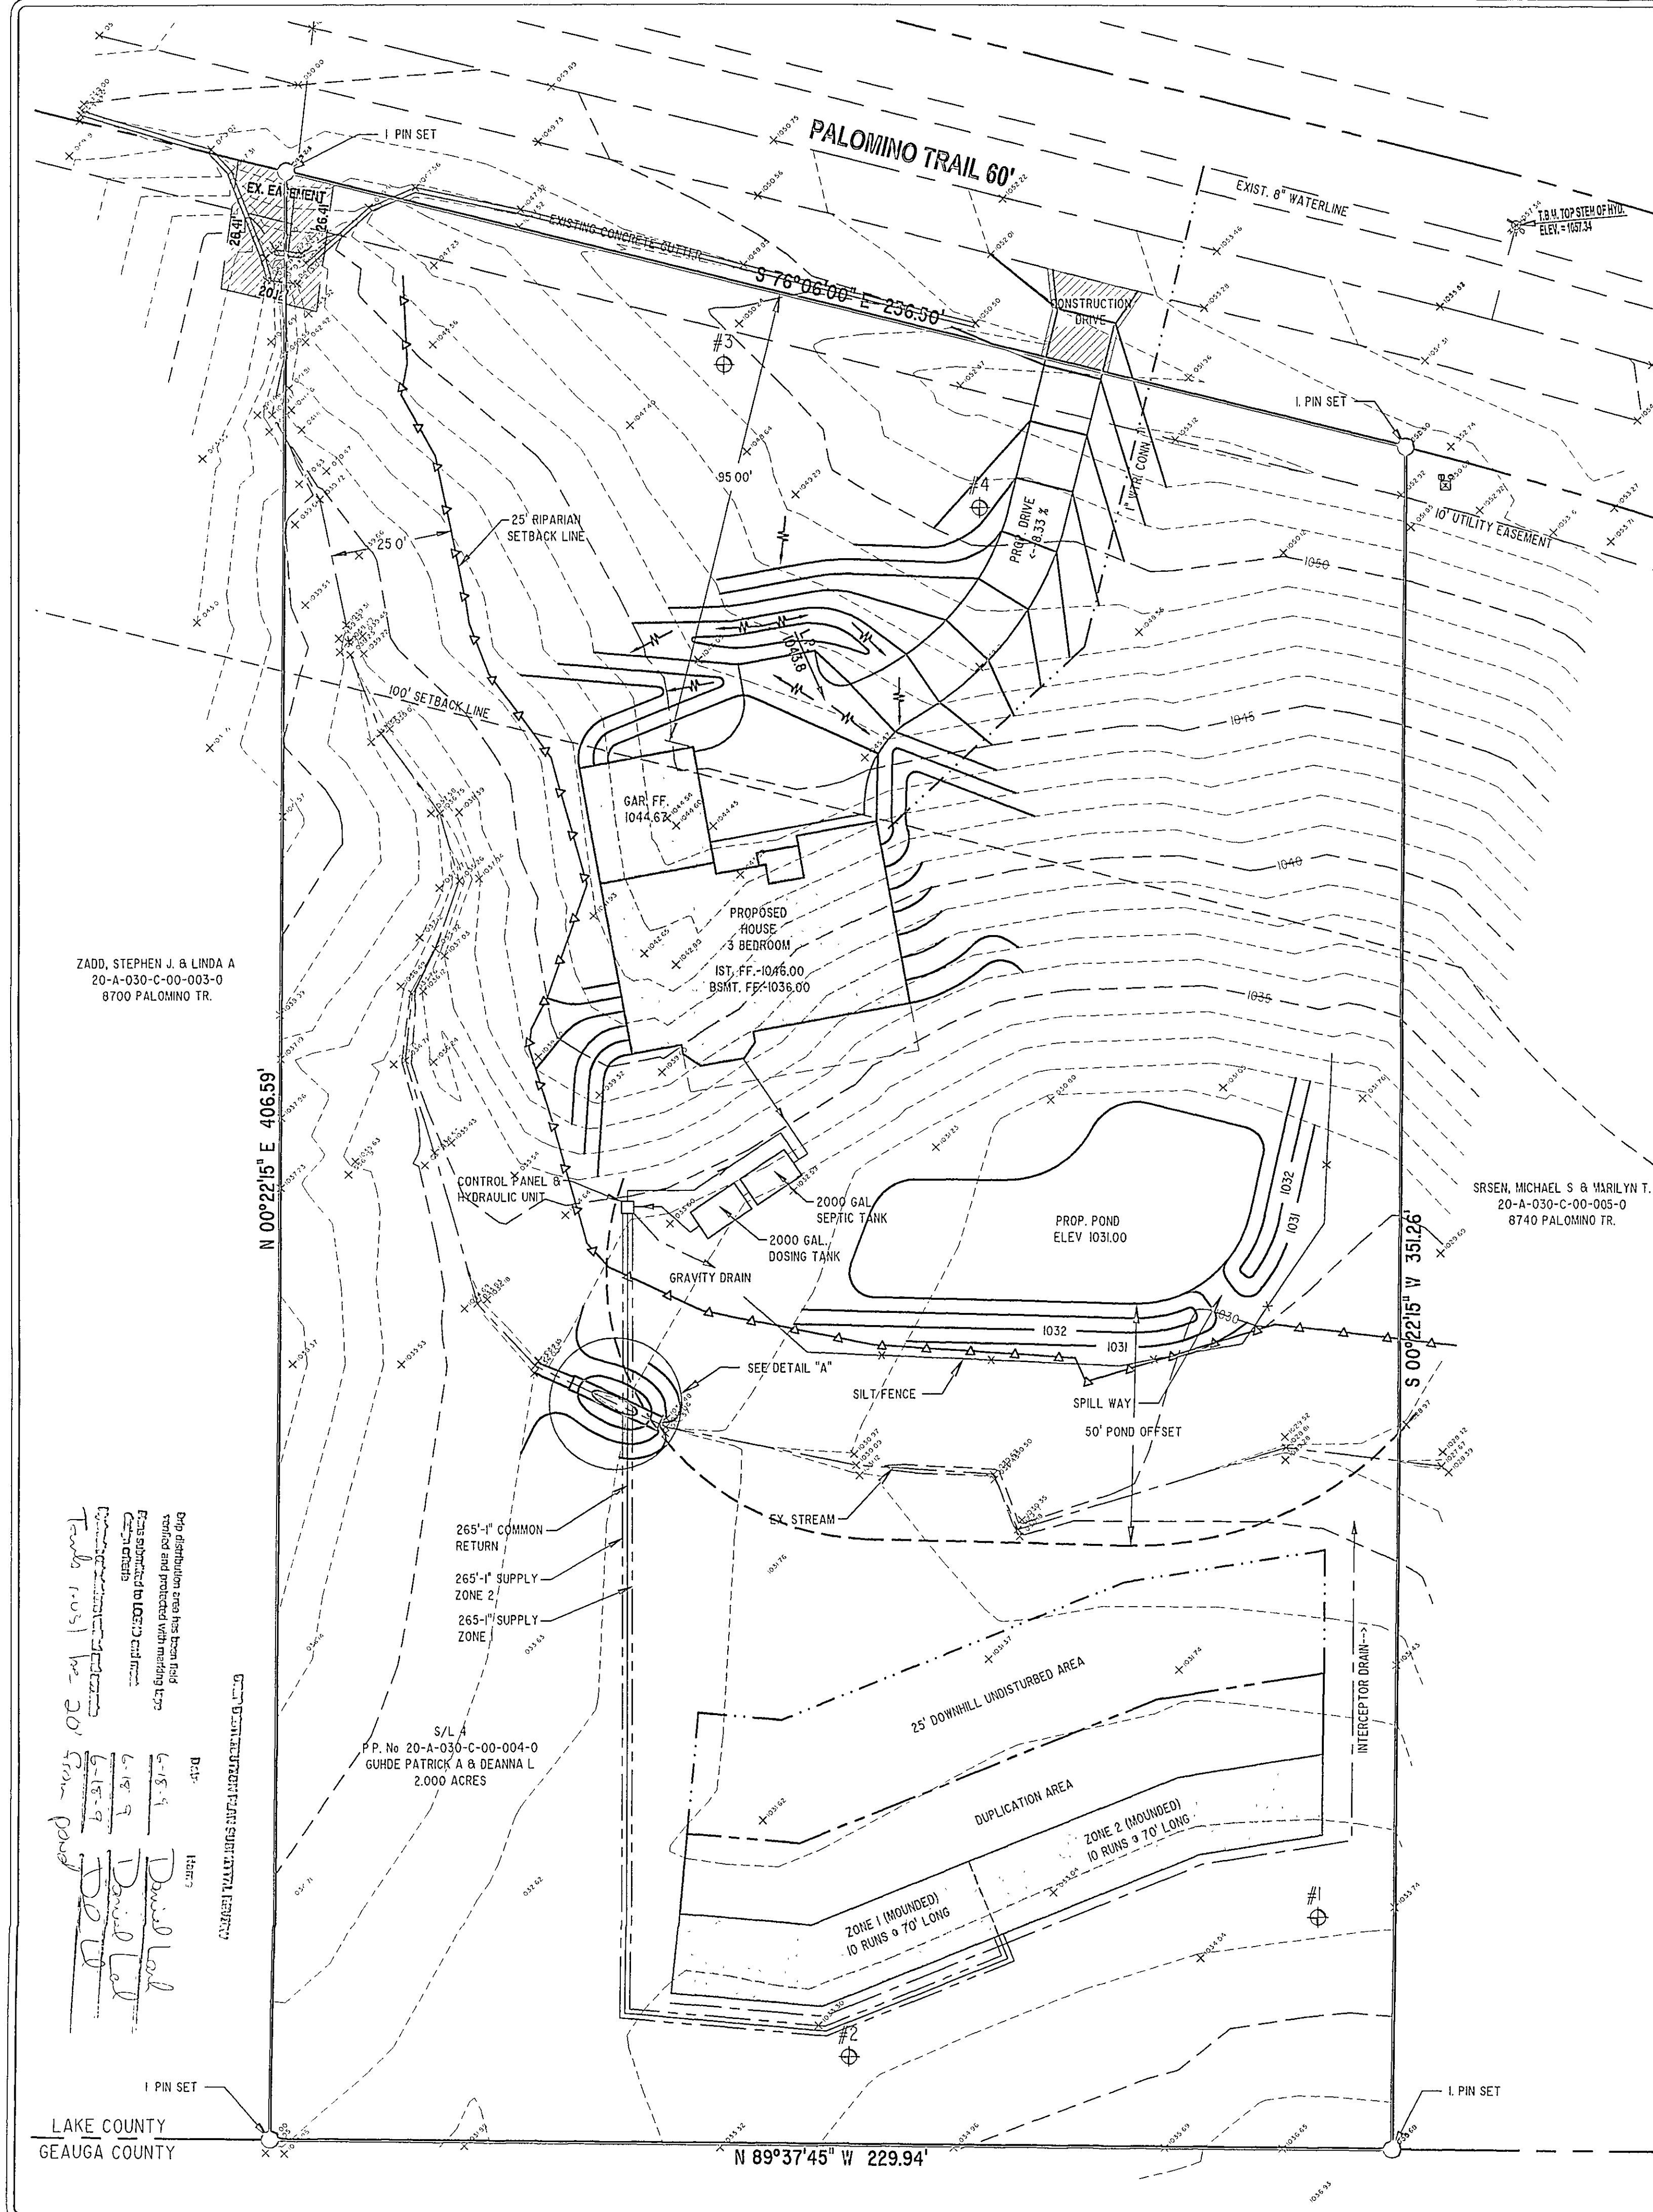


REVISIONS	BY
REVISED HOUSE LOCATION APR. 04, 2009	WSO
REVISED SEPTIC PER STREAMLINE APR. 07, 2009	WSO
REVISED GRADING MAY 29, 2009	WSO

Barrington
CONSULTING GROUP, INC.
9114 TYLER BLVD., MENTOR, OHIO 44060
PHONE 440.205.1260 FAX 440.205.1262
www.BarringtonCGI.com

STEVEN J. PETRO
7991 AILEEN DR.
MENTOR, OHIO 44060
440-255-1211

SITE PLAN
S/L 4 PALOMINO TR., KIRTLAND, OHIO 44094
BRIDLEHURST ESTATES SUBDIVISION No. 3 VOL. Y PG. 31

PETRO RESIDENCE

DRAWN
WSO
CHECKED
DWM
DATE
FEB. 25, 2009
SCALE
1" = 20'
JOB NO.
08100
SHEET
1/3

OF
SHEETS
08100