
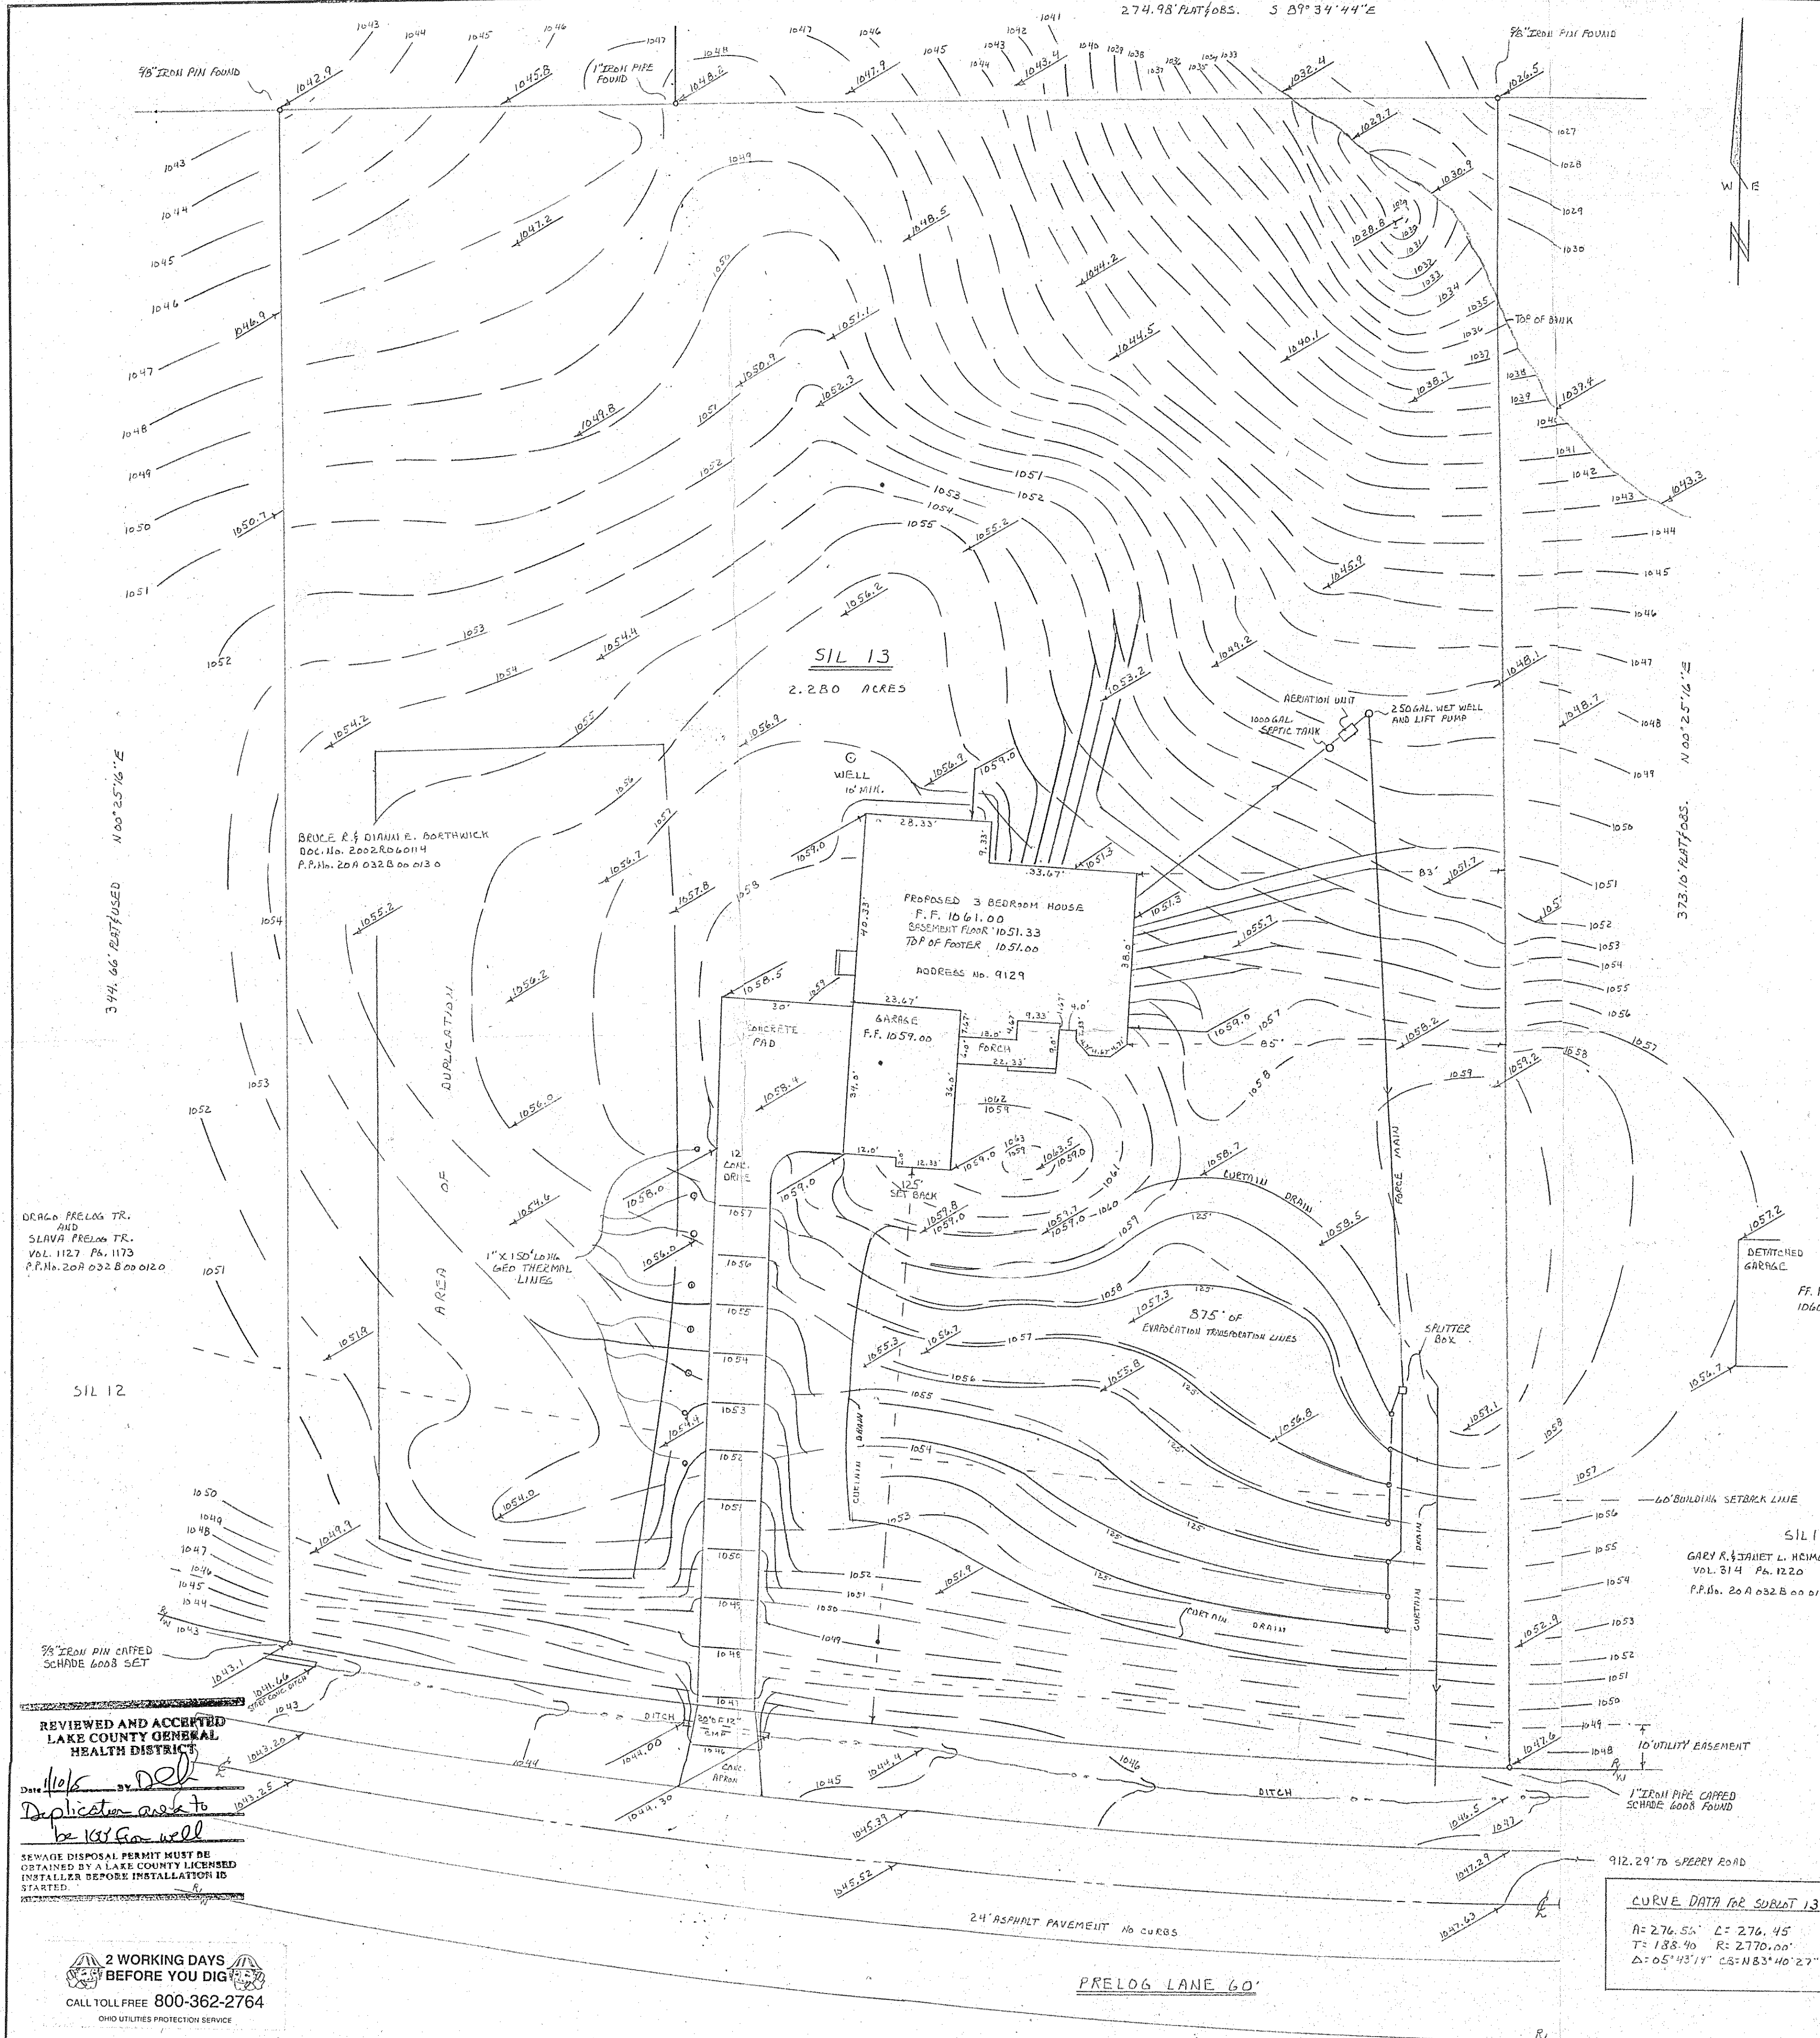
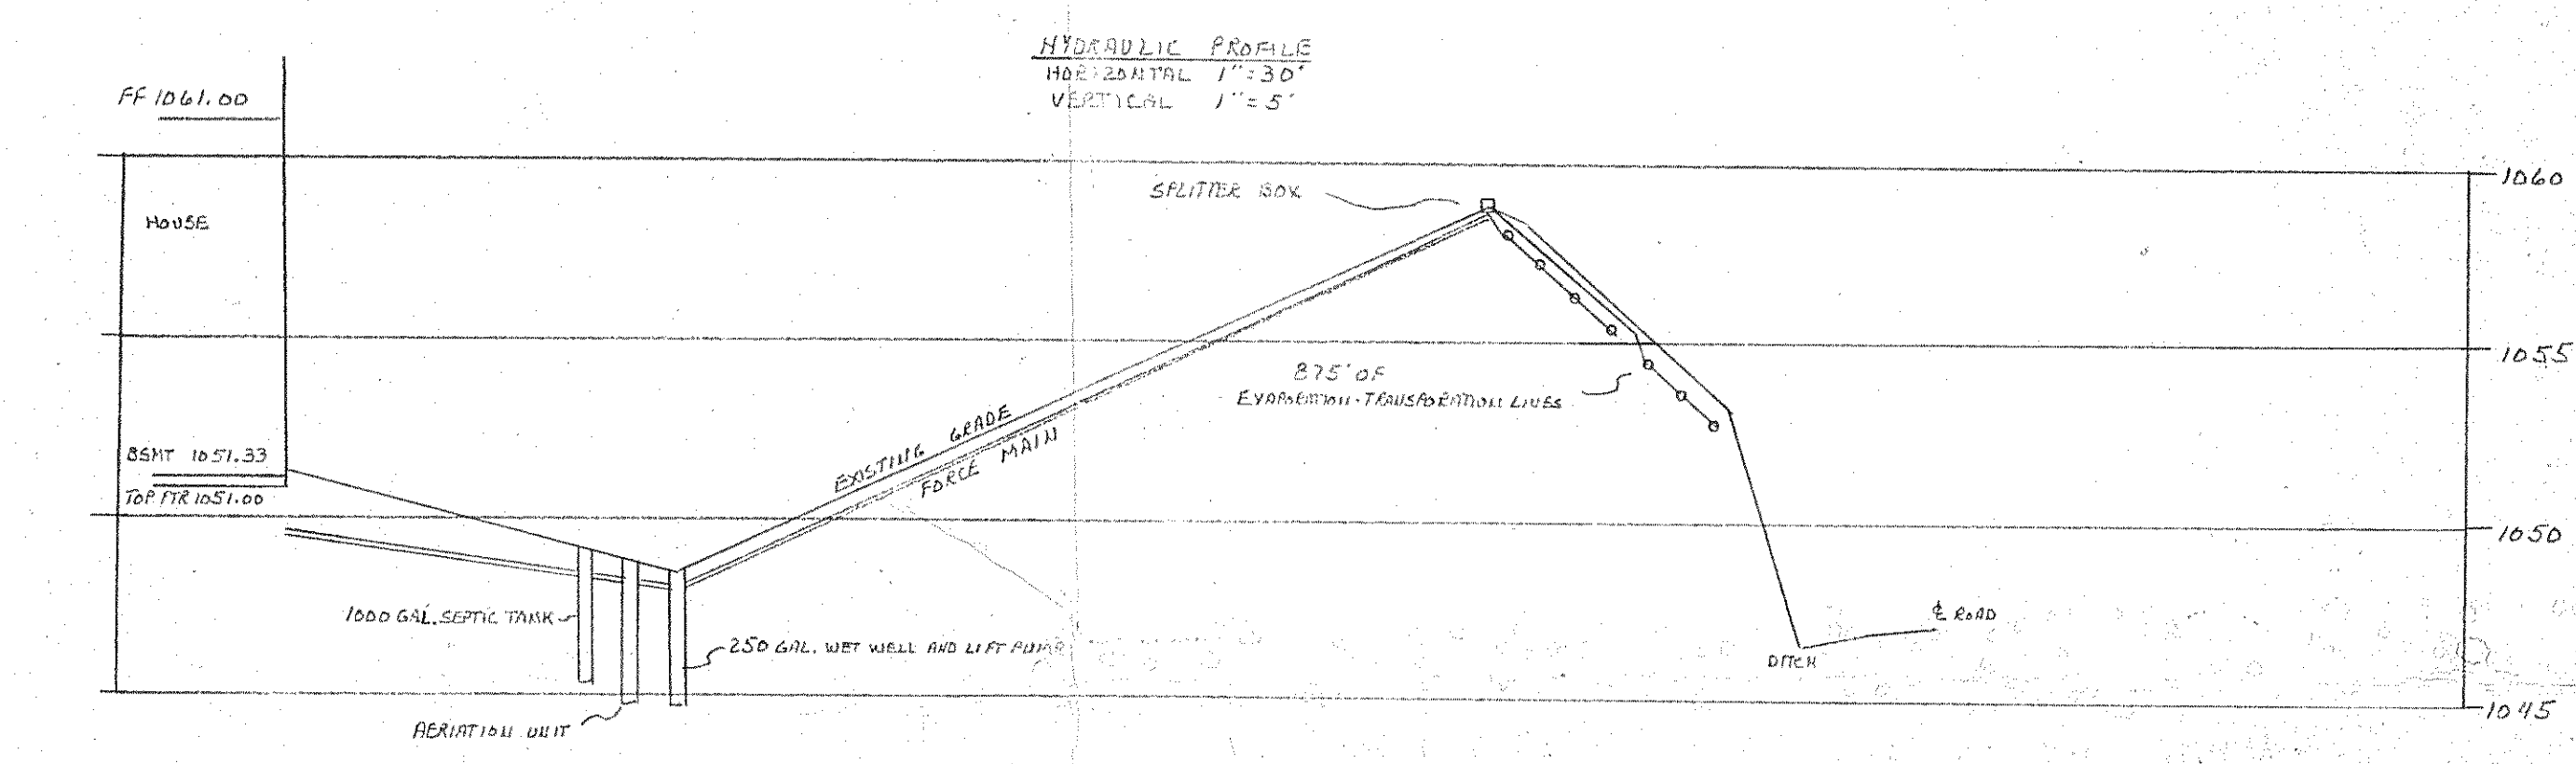


SILVER PINE SUBDIVISION
VOL. X P. 20
LAKE COUNTY RECORD OF PLATS
ORIGINAL KIRTLAND TOWNSHIP
LOT Nos. 78 & 79, TRACT No. 3

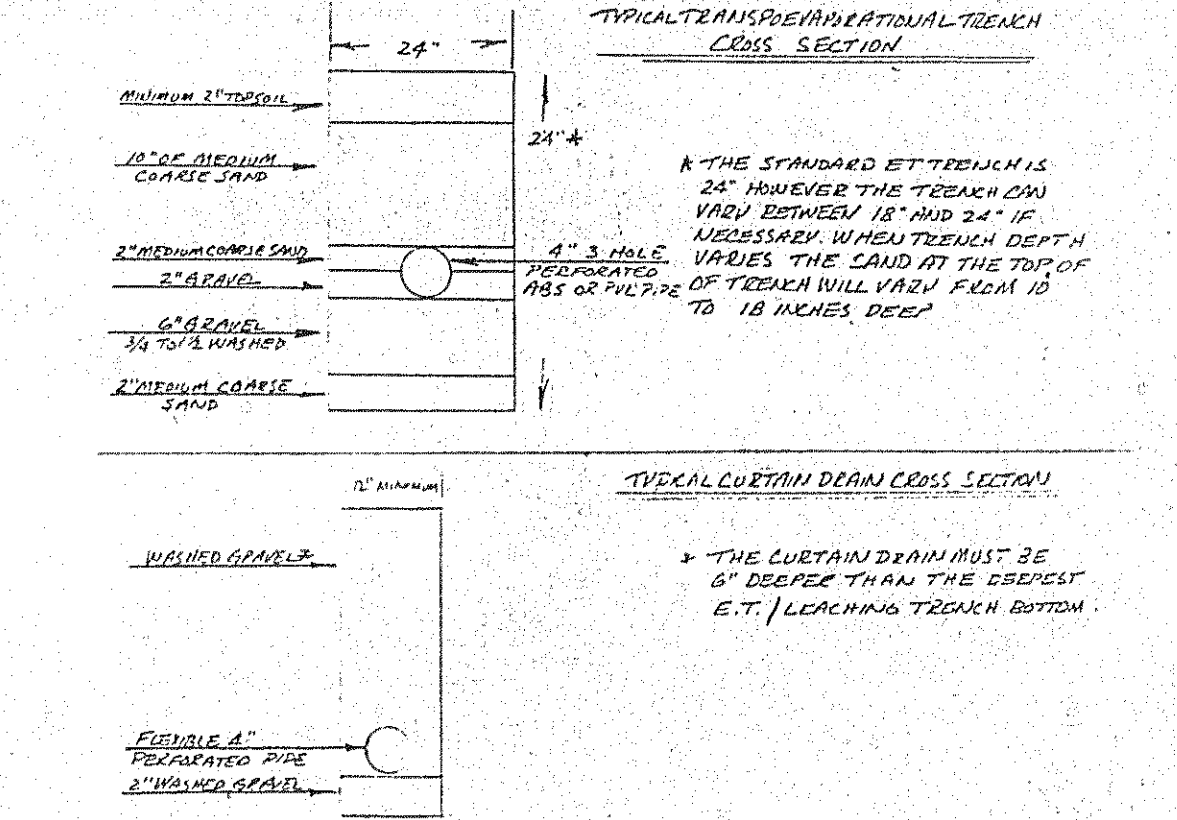


Stormwater Management Plan
Approved as shown and/or noted
JAMES R. GILLS, P.E.
County Drainage Engineer
By L.S. Date 1/19/06

LEGEND
EXISTING ELEVATION
PROPOSED ELEVATION
EXISTING CONTOUR
PROPOSED CONTOUR

NOTES
1. HOME MUST BE EQUIPPED WITH WATER SAVING FIXTURES.
2. DOWNSPUTS MUST BE DIRECTED AWAY FROM SEWAGE SYSTEM.
3. MAINLINES ETC. MUST BE BENT UP TO GRADE.

I, THE UNDERSIGNED, HEREBY CERTIFY THAT THE TOPOGRAPHY INDICATED BY THE CONTOURS AND ELEVATIONS SHOWN HEREON
BY ME ON THE 13TH DAY OF MAY 2005 AND THAT THE ELEVATIONS WERE TAKEN AT APPROPRIATE INTERVALS
AND THAT AS OF THAT DATE THEY EXISTED AS INDICATED HEREON.
I HEREBY CERTIFY THAT AN ACTUAL BOUNDARY SURVEY WAS PREPARED BY ME ON THE 13TH DAY OF MAY 2005
AND THAT THE SURVEY IS IN ACCORDANCE WITH O.R.C. CHAPTER 4733-37 MINIMUM STANDARDS IN THE
STATE OF OHIO. PERMANENT MONUMENTS WERE FOUND OR SET AT ALL LOCATIONS SHOWN HEREON.
ALL DIMENSIONS GIVEN ARE EXPRESSED IN FEET DECIMAL PARTS THEREOF. BEARINGS ARE TO AN ASSUMED
MERIDIAN AND ARE SHOWN TO INDICATE ANGLES ONLY.
I HEREBY CERTIFY THAT THIS SITE PLAN WAS PREPARED BY ME AND IS CORRECT TO THE BEST OF MY KNOWLEDGE,
INFORMATION AND BELIEF.

WILLARD F. SCHADE JR.
WILLARD F. SCHADE JR., PROFESSIONAL SURVEYOR No. 6008
DATE 1-09-06

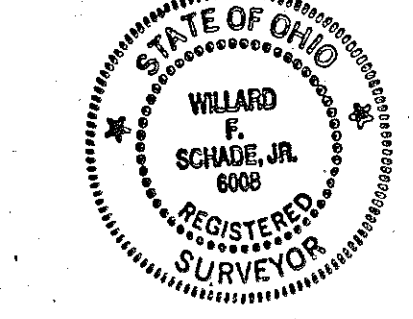

APPROVED AS NOTED
CT CONSULTANTS, INC.
By Phyllis W. Kapp 01-12-06
CITY ENGINEER DATE

SCHADE SURVEYING COMPANY 4043 ERIE STREET WILLARD, OHIO 44094 440 751-6454	
SITE PLAN FOR: BRUCE BORTHWICK	SCALE 1"=20'
9129 PREL06 LANE KIRTLAND LAKE COUNTY, OHIO PART OF LOT NOS. 78 & 79, TRACT No. 3	DRAWN BY J.S. SCHADE JR. REVISED 11-22-2005
DATE 10-27-2005	APPROVED BY [Signature]
	DRAWING NUMBER 05-1703

2 WORKING DAYS
BEFORE YOU DIG
CALL TOLL FREE 800-362-2764
OHIO UTILITIES PROTECTION SERVICE

CURVE DATA FOR SUBMIT 13
R=276.53' C=276.45'
T=138.40' R=2770.00'
Δ=05°43'14" CS=N83°40'27"W